


NOTE



| Revision | Date | Description | By/Ch |
|----------|----------|---------------------|-------|
| P01 | 20.12.23 | Planning Submission | cm |

CLIENT
Riverhills Health Club & Spa
 [Mosaic Group]

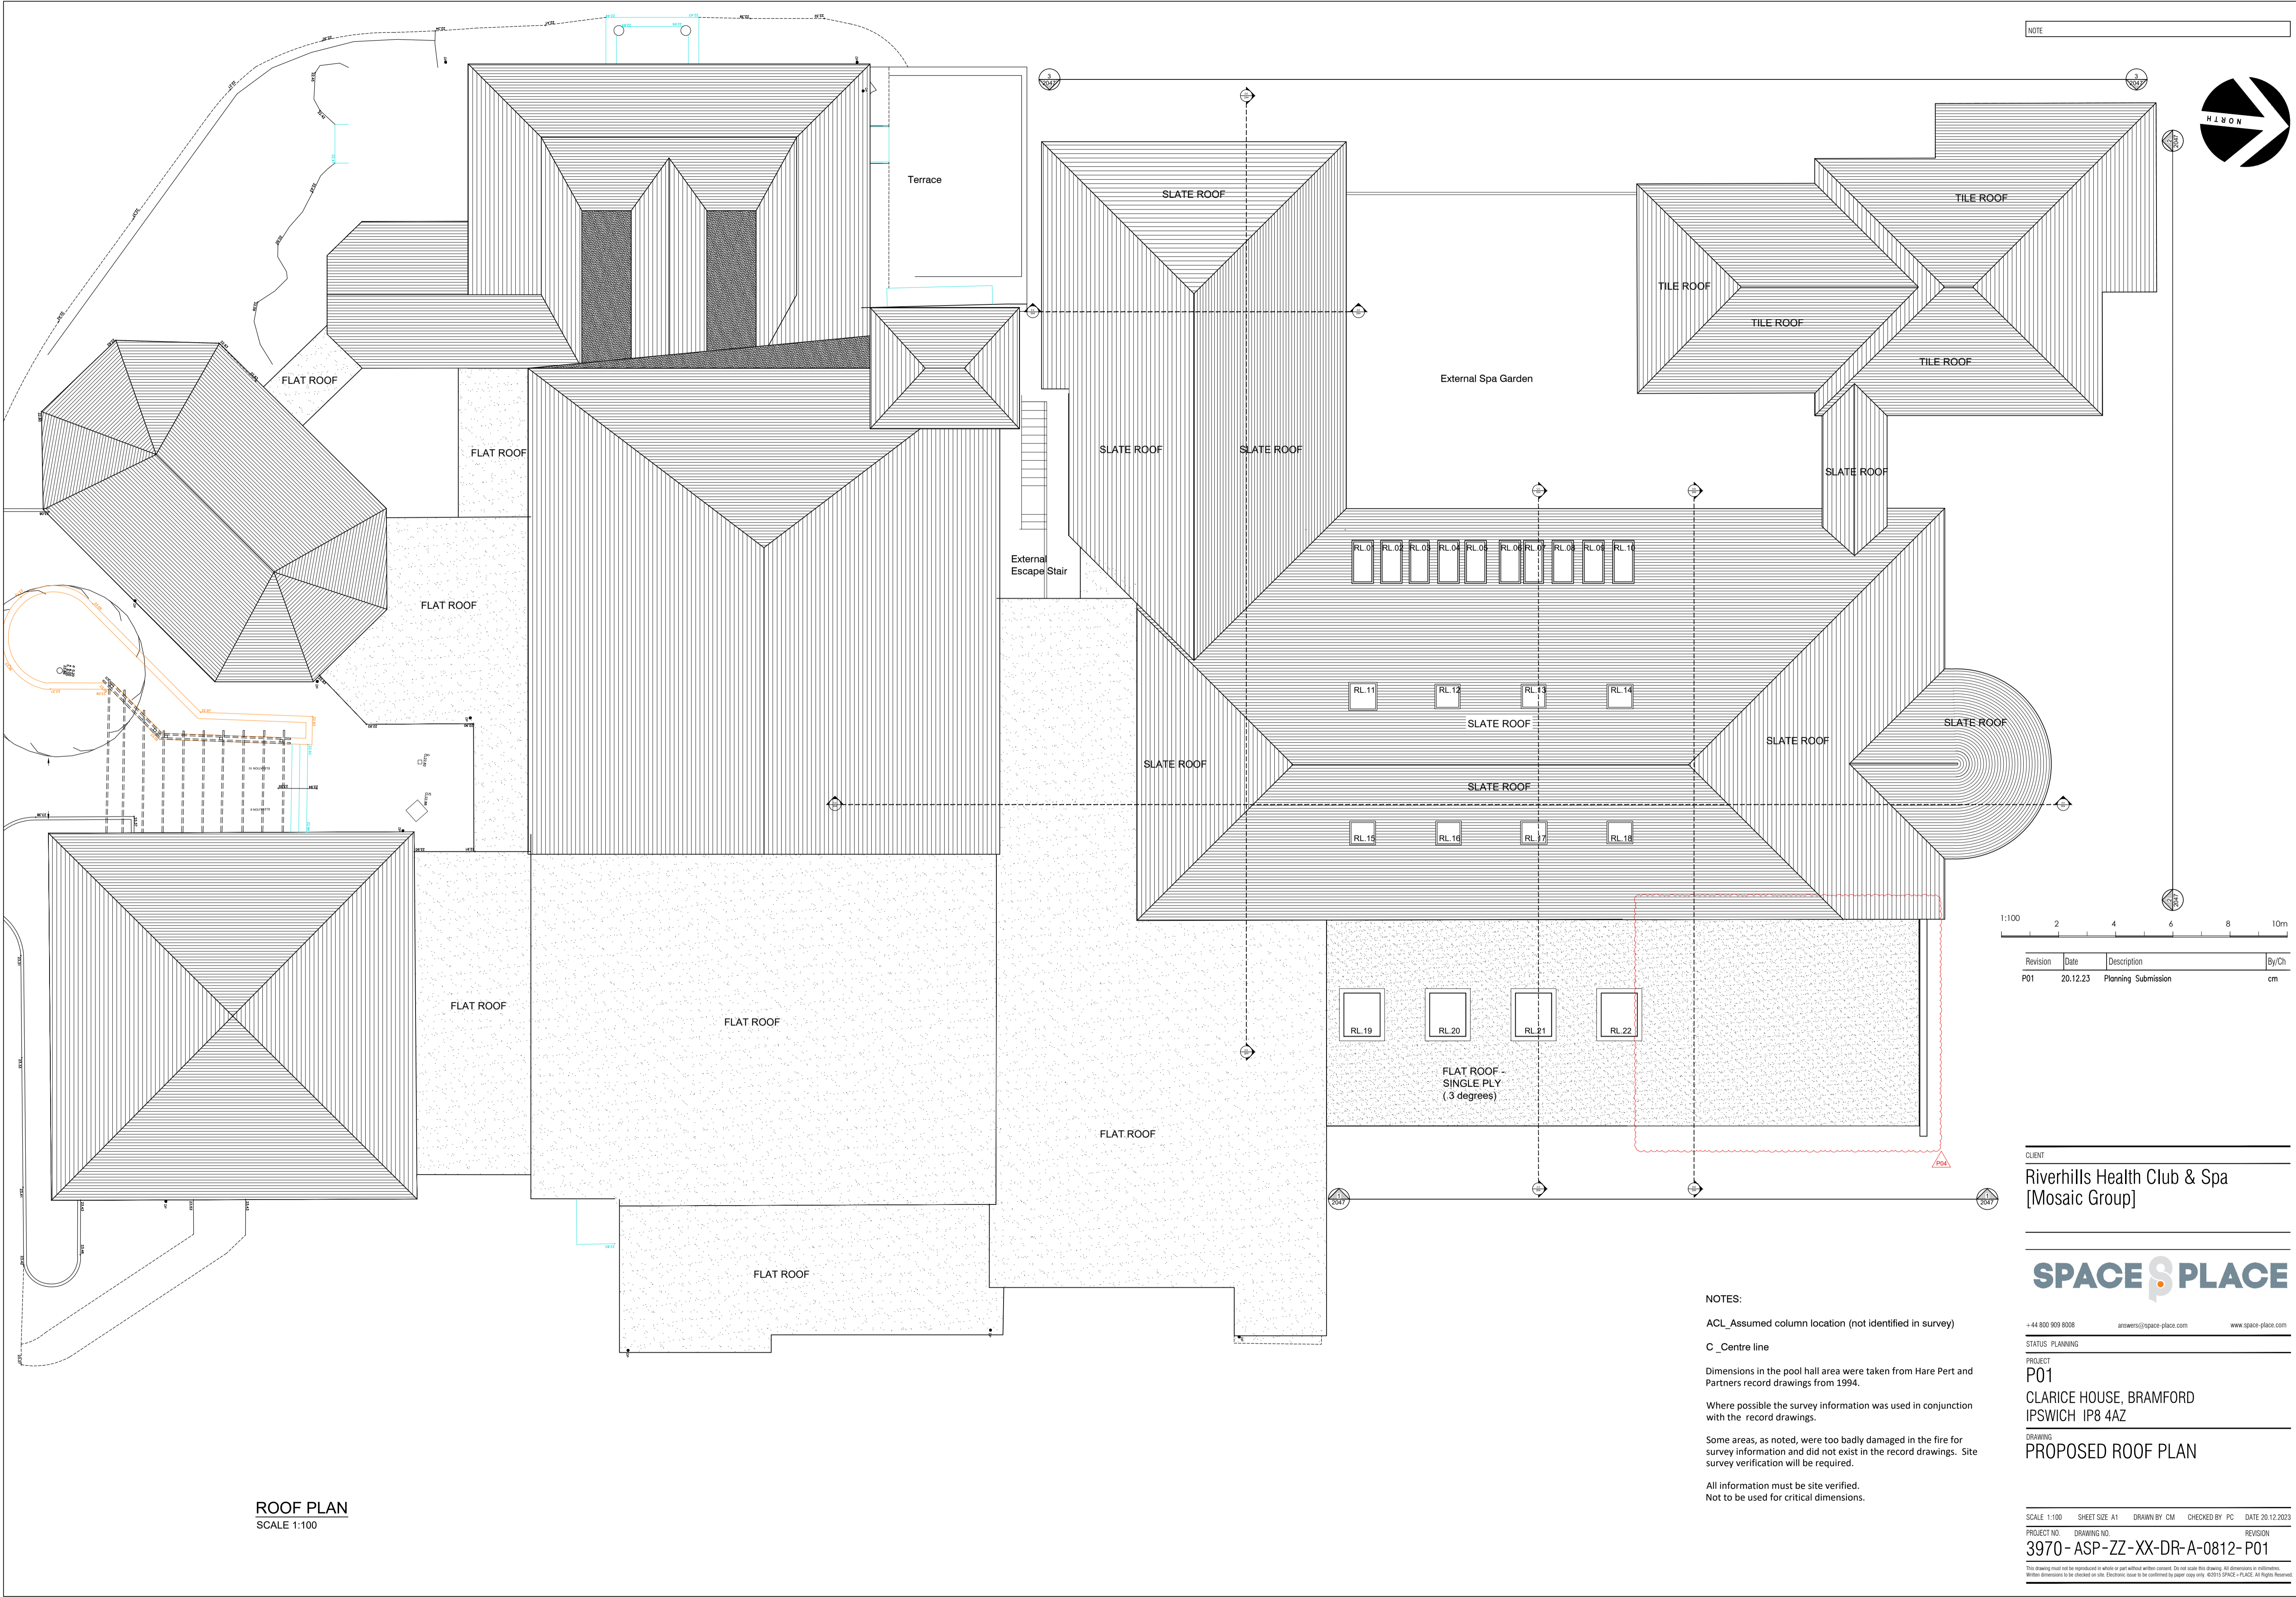

+44 800 909 8008 answers@space-place.com www.space-place.com

STATUS: PLANNING
 PROJECT
P01
 CLARICE HOUSE, BRAMFORD
 IPSWICH IP8 4AZ
 DRAWING
PROPOSED ROOF PLAN

NOTES:
 ACL Assumed column location (not identified in survey)
 C_Centre line
 Dimensions in the pool hall area were taken from Hare Pert and Partners record drawings from 1994.
 Where possible the survey information was used in conjunction with the record drawings.
 Some areas, as noted, were too badly damaged in the fire for survey information and did not exist in the record drawings. Site survey verification will be required.
 All information must be site verified.
 Not to be used for critical dimensions.

ROOF PLAN
 SCALE 1:100