



EPR Architects Limited
30 Millbank, London SW1P 4DU
Tel 020 7932 7600, Fax 020 7932 7601
www.epr.co.uk, architects@epr.co.uk

Notes:
Building management of car park space no.17 required to provide access as necessary to plant room 2
For all services and structure refer to specialist's information

For all services and structure refer to specialist's information

RECORD DRAWING

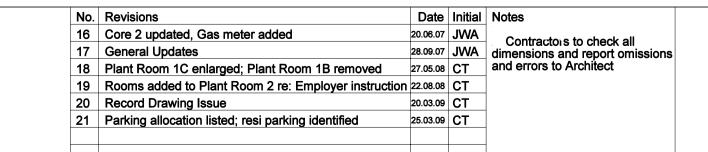

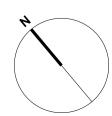

Project	
TEMPLE BACK BRISTOL	
Title	
LOWER GROUND PLAN - Existing	
Drg No	Revision
9616.LO.0999	21
Scale	Date
1:200 @ A1	07.06.06

