




extension walls
rendered to match
existing

Rear Elevation
as built

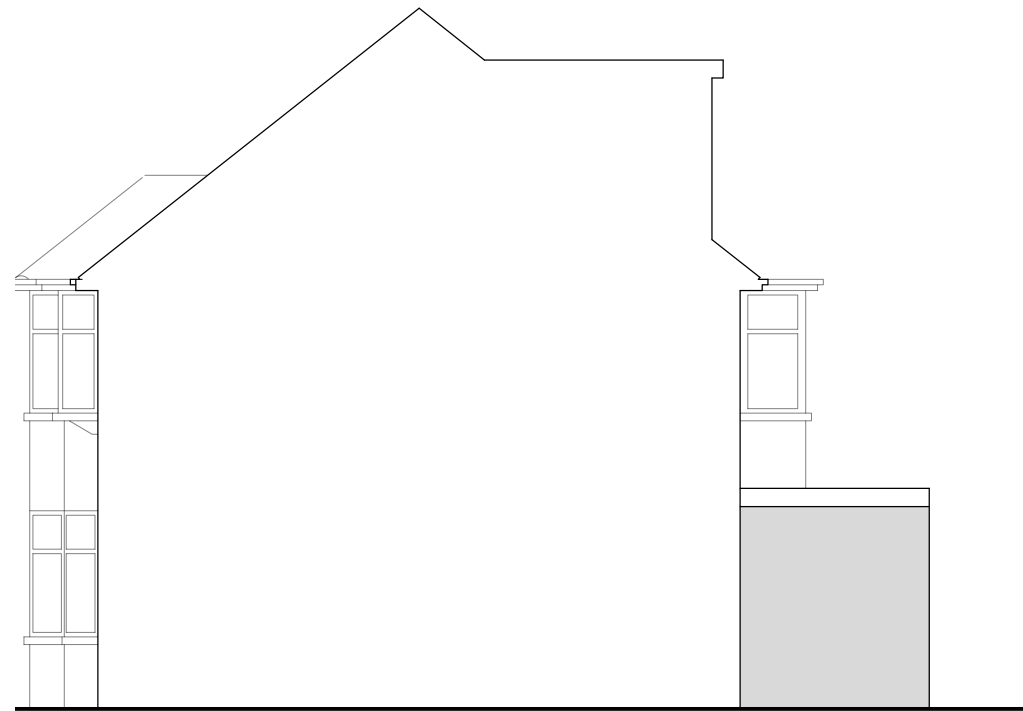

Side Elevation
as built



Side Elevation
as built

Rev:

Drawing Title: Proposed Elevations
Scale: 1:100@A3
Drwn: tdo

Project: Retention of rear extension
Date: Dec 2023

Location:
6 Hall Lane
London NW4 4TN

Drawing No:
4335 12

STUART HENLEY & PARTNERS
Chartered Surveyors & Planning Consultants

2a Wrotham Business Park
Hadley, Barnet
Herts EN5 4SB

t: 020 8275 1080
f: 0800 007 3003
e: info@planningconsent.com
w: www.planningconsent.com

Copyright and design right held by Stuart Henley & Partners Ltd. No unauthorised reproduction permitted.