


Ground Floor Plan  
Original



Ground Floor Plan  
as built

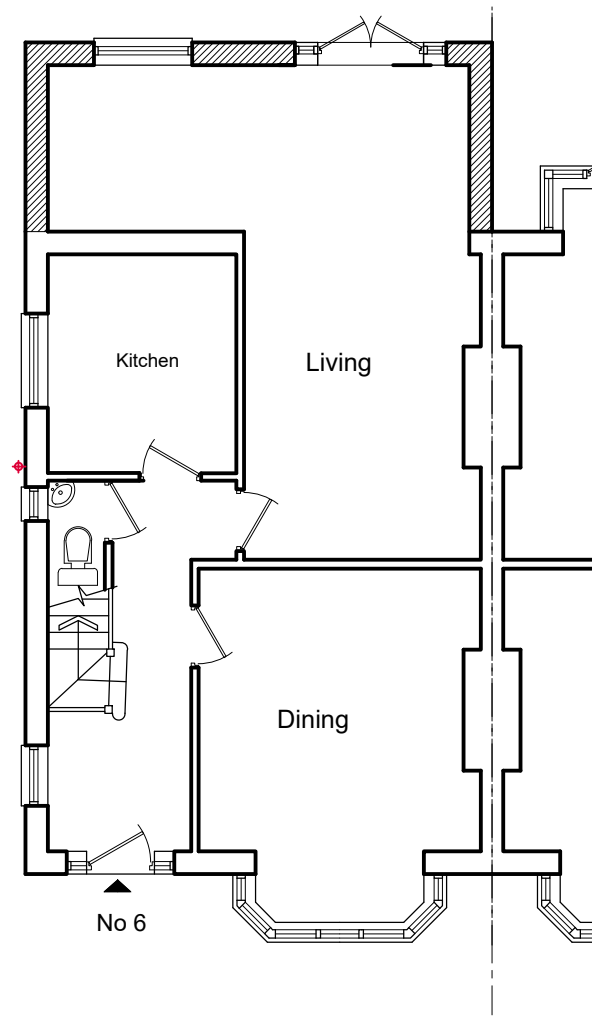

**STUART HENLEY & PARTNERS**  
Chartered Surveyors & Planning Consultants

2a Wrotham Business Park  
Hadley, Barnet  
Herts EN5 4SB  
t: 020 8275 1080  
f: 0800 007 3003  
e: [info@planningconsent.com](mailto:info@planningconsent.com)  
w: [www.planningconsent.com](http://www.planningconsent.com)

Rev:

Drawing Title:	Scale: 1:100@A3
Original and as built ground floor plans	Drwn: tdo
Project:	Date: Dec 2023
Retention of single storey rear extension	Drawing No:
Location:	<b>4335 10</b>
6 Hall Lane London NW4 4TN	