


Do not scale off this drawing. All dimensions to be checked on site prior to manufacture and construction. This drawing is the property of Just H Architects and should not be reproduced without permission. All discrepancies to be brought to the attention of the architect immediately. This drawing to be read in conjunction with the specification / bill of quantities and related drawings.

REVISION			
-	FIRST ISSUE	00.00.00	xx
A	DRAWING UPDATED TO BUILDING OFFICER COMMENT	17.09.21	JL
B	GENERAL UPDATE	18.11.21	JG
C	AS BUILT	07.04.22	LS
D	BIKE RACK MOVED	24.05.23	JG

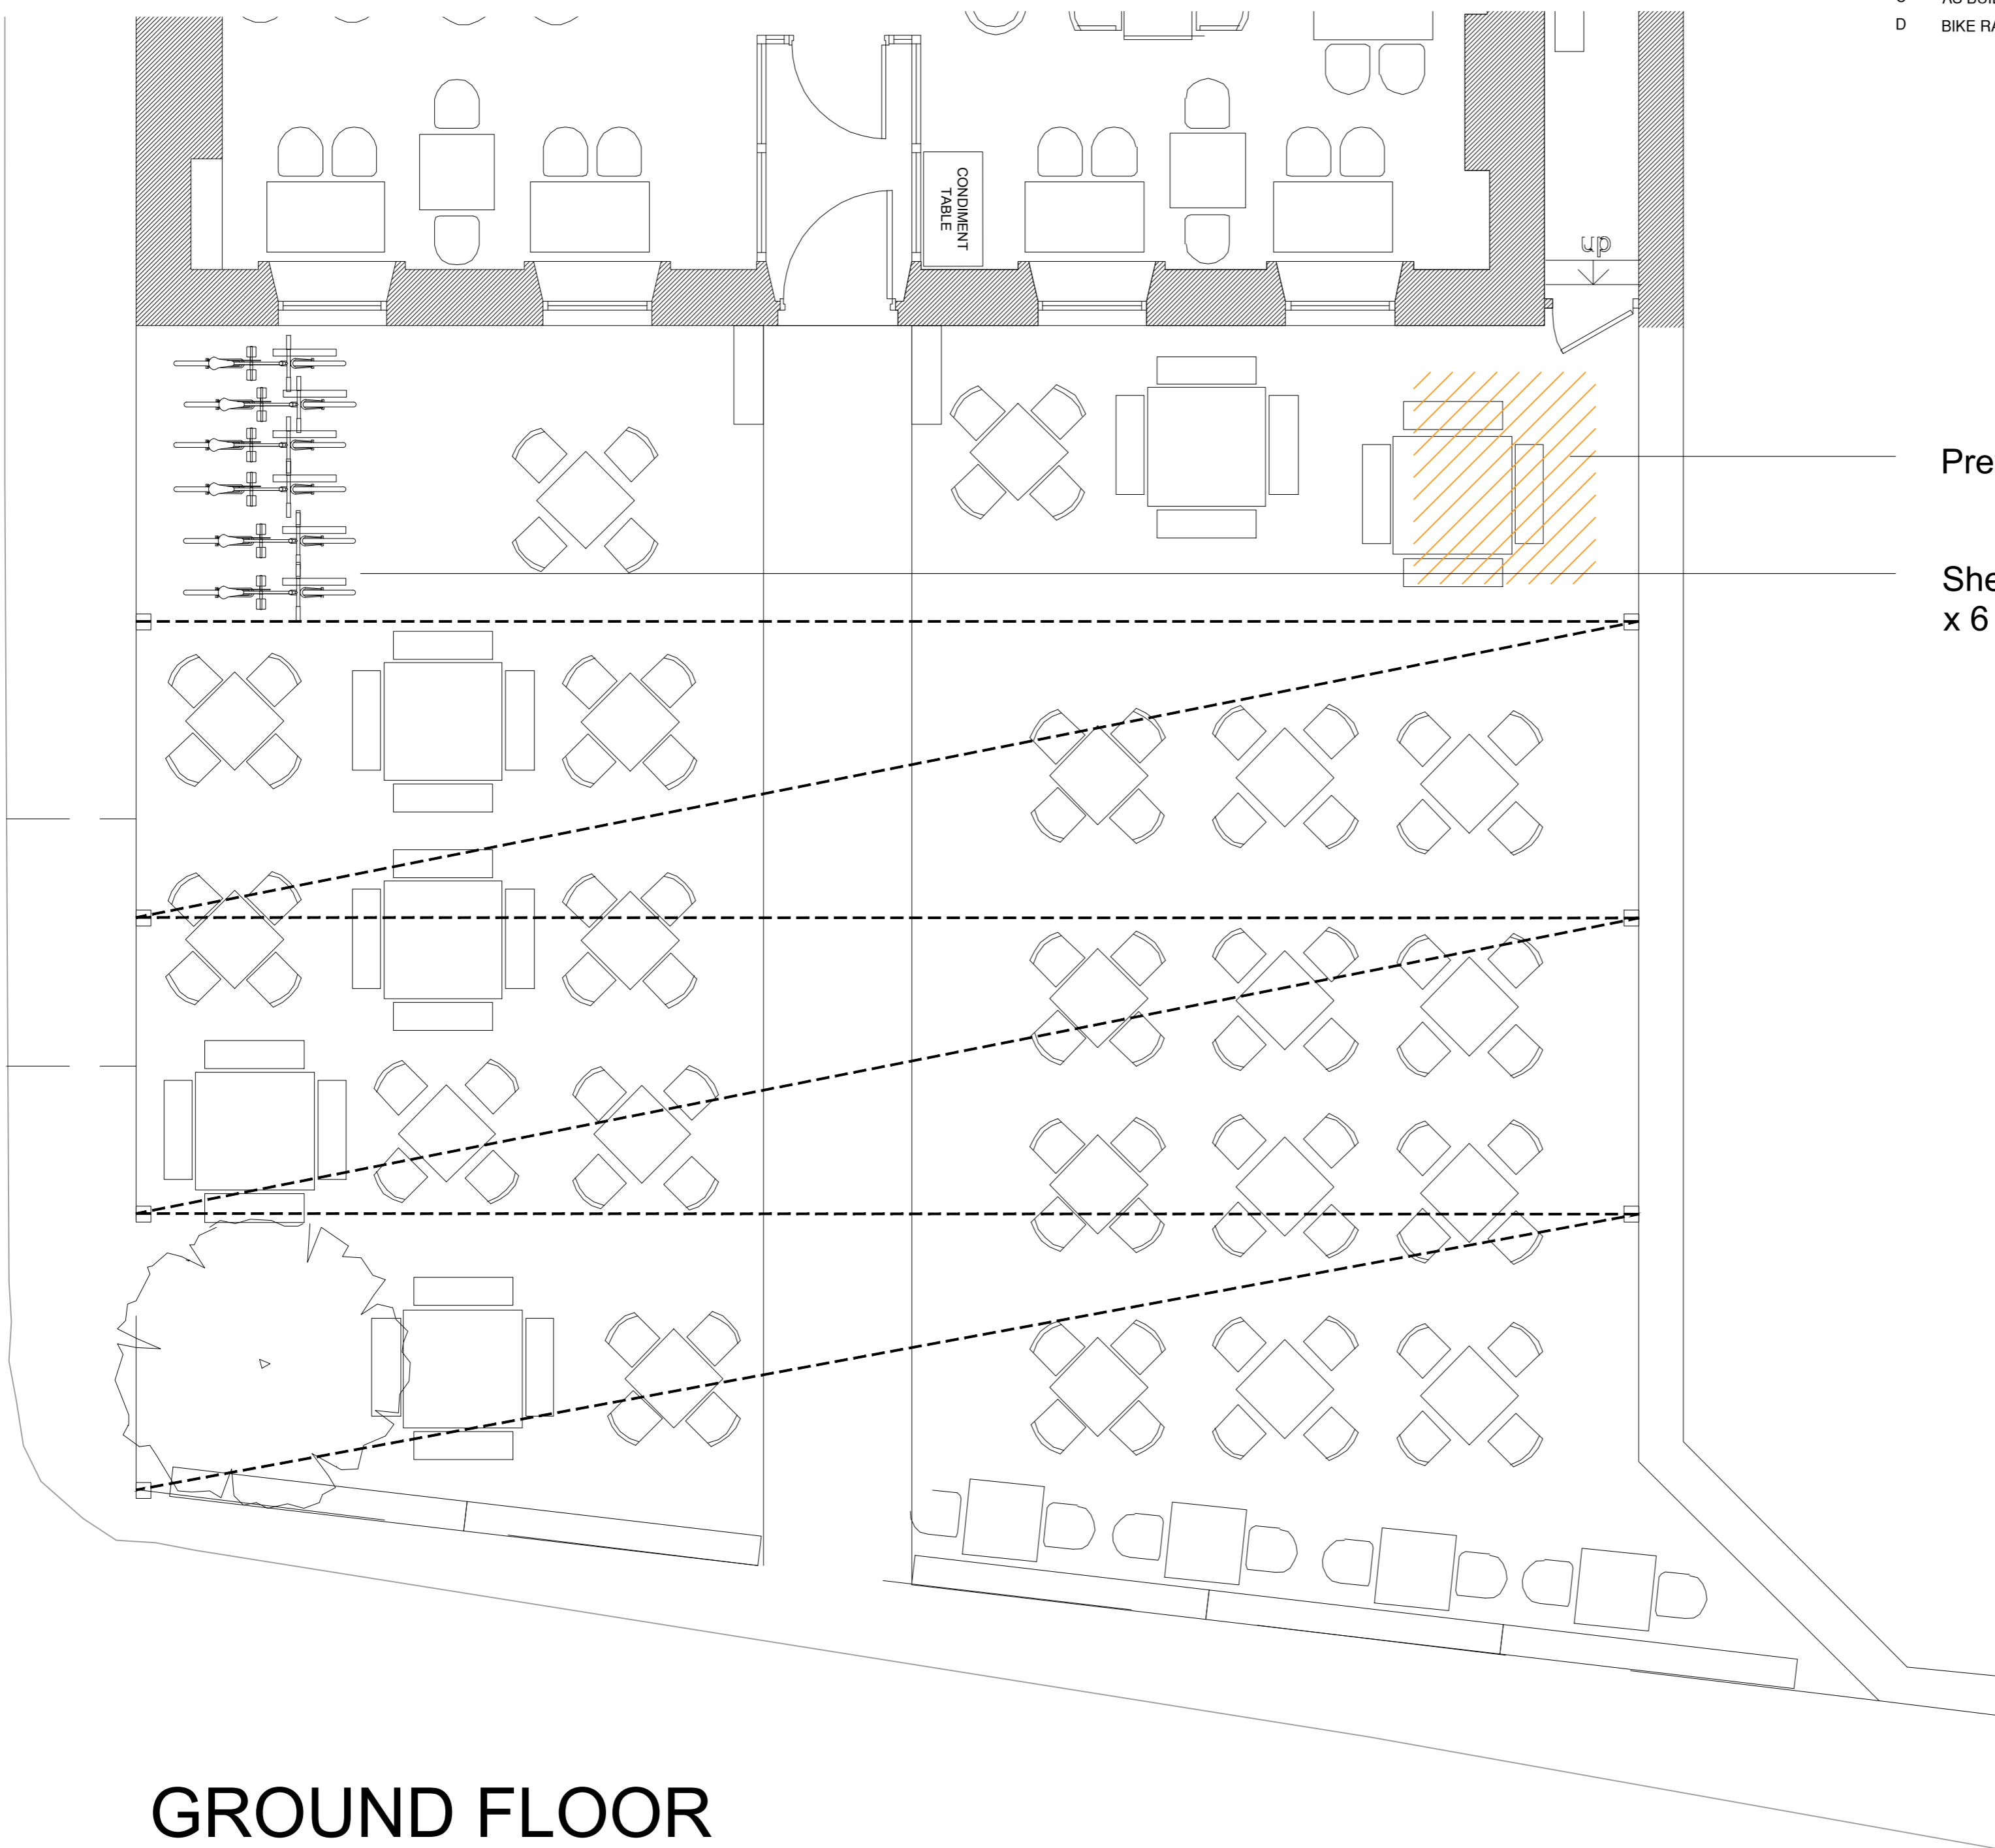

GROUND FLOOR

0 1 2 3 4 5

JD WETHERSPOON PLC	client
THE BOWLING GREEN 18 BONDGATE - OTLEY LS21 3AB	project
PROPOSED BEER GARDEN GA PLAN	title
JDW27	job No.
AL1.03/A	dwg No.
1:50 @ A1	scale



Just H
Architects

107 Timber Wharf
32 Worsley Street
Castlefield, Manchester
M15 4NX
0161 237 5500
justh@justharchitects.co.uk