



AS BUILT FRONT ELEVATION



AS BUILT SIDE ELEVATION

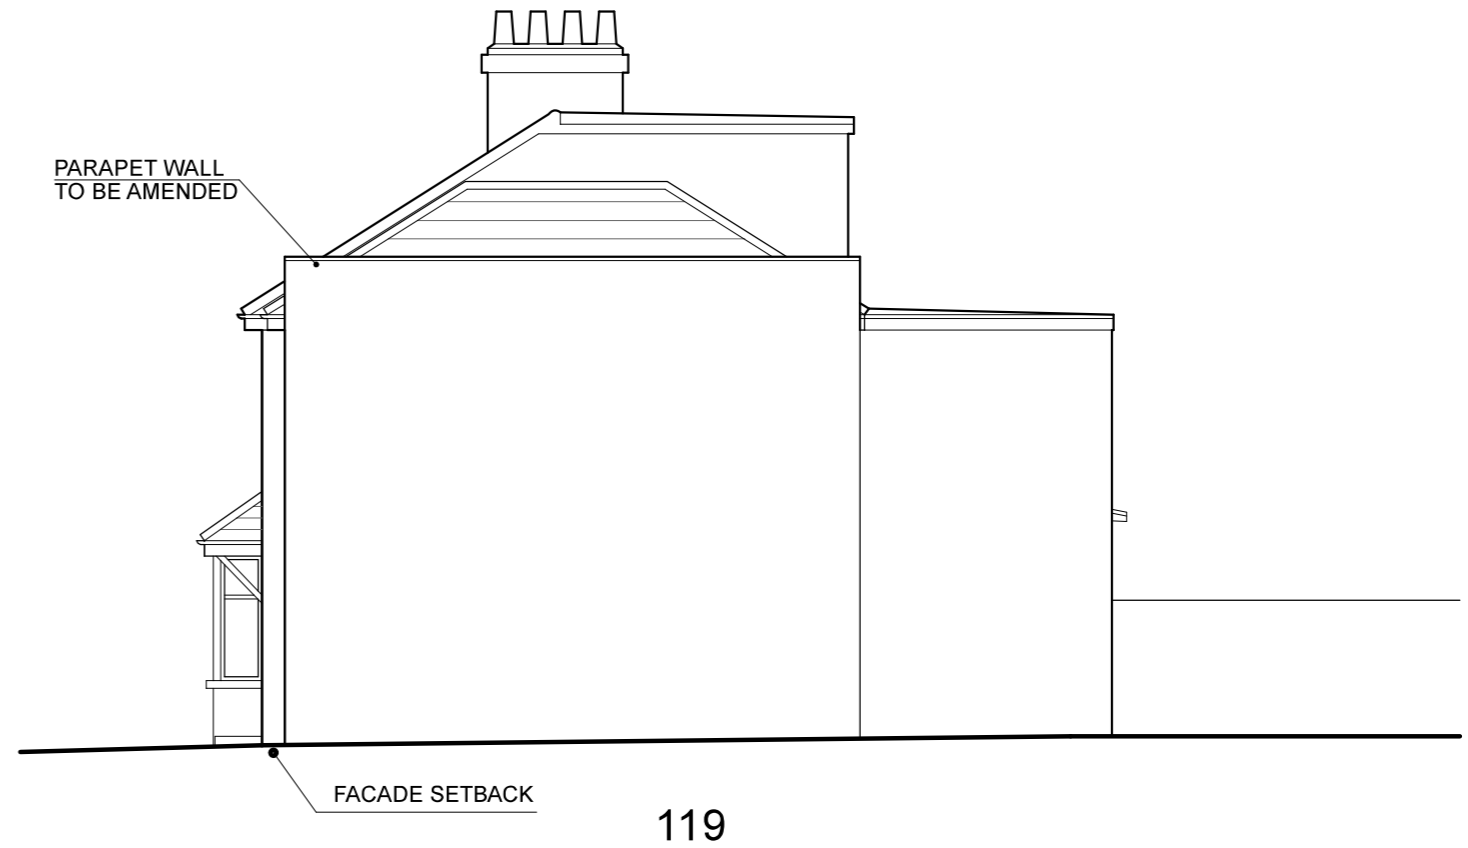

AS BUILT REAR ELEVATION

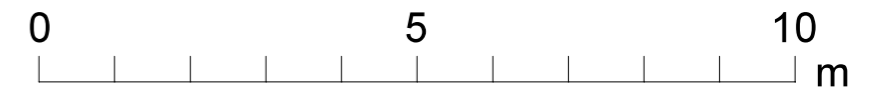

CANTALE DESIGN ARCHITECTS LTD

CANTALEDESIGN
ARCHITECTS



Architects
Registration
Board

studio@cantaledesign.com
Tel: 0800 644 6419
123 Trafalgar Road, Greenwich - LONDON SE10 9TX

RETROSPECTIVE PLANNING APPLICATION

119 MYPLACE ROAD
BEXLEYHEATH - KENT - DA7 6ER

AS BUILT ELEVATIONS

12

SCALE 1:100 @ A3

JAN - 2024