


DORMER VOLUME 27.5m<sup>3</sup>

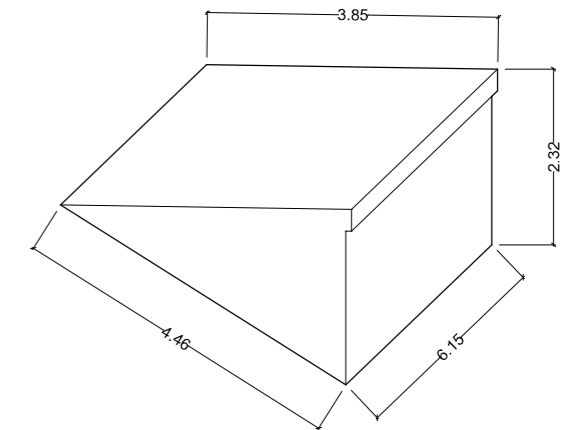



PERMITTED DEVELOPMENT

APPROVED EXTENSION

(REF: 22/01770/FUL)


APPROVED EXTENSION

(REF: 21/02902/FUL)

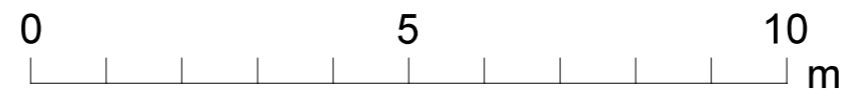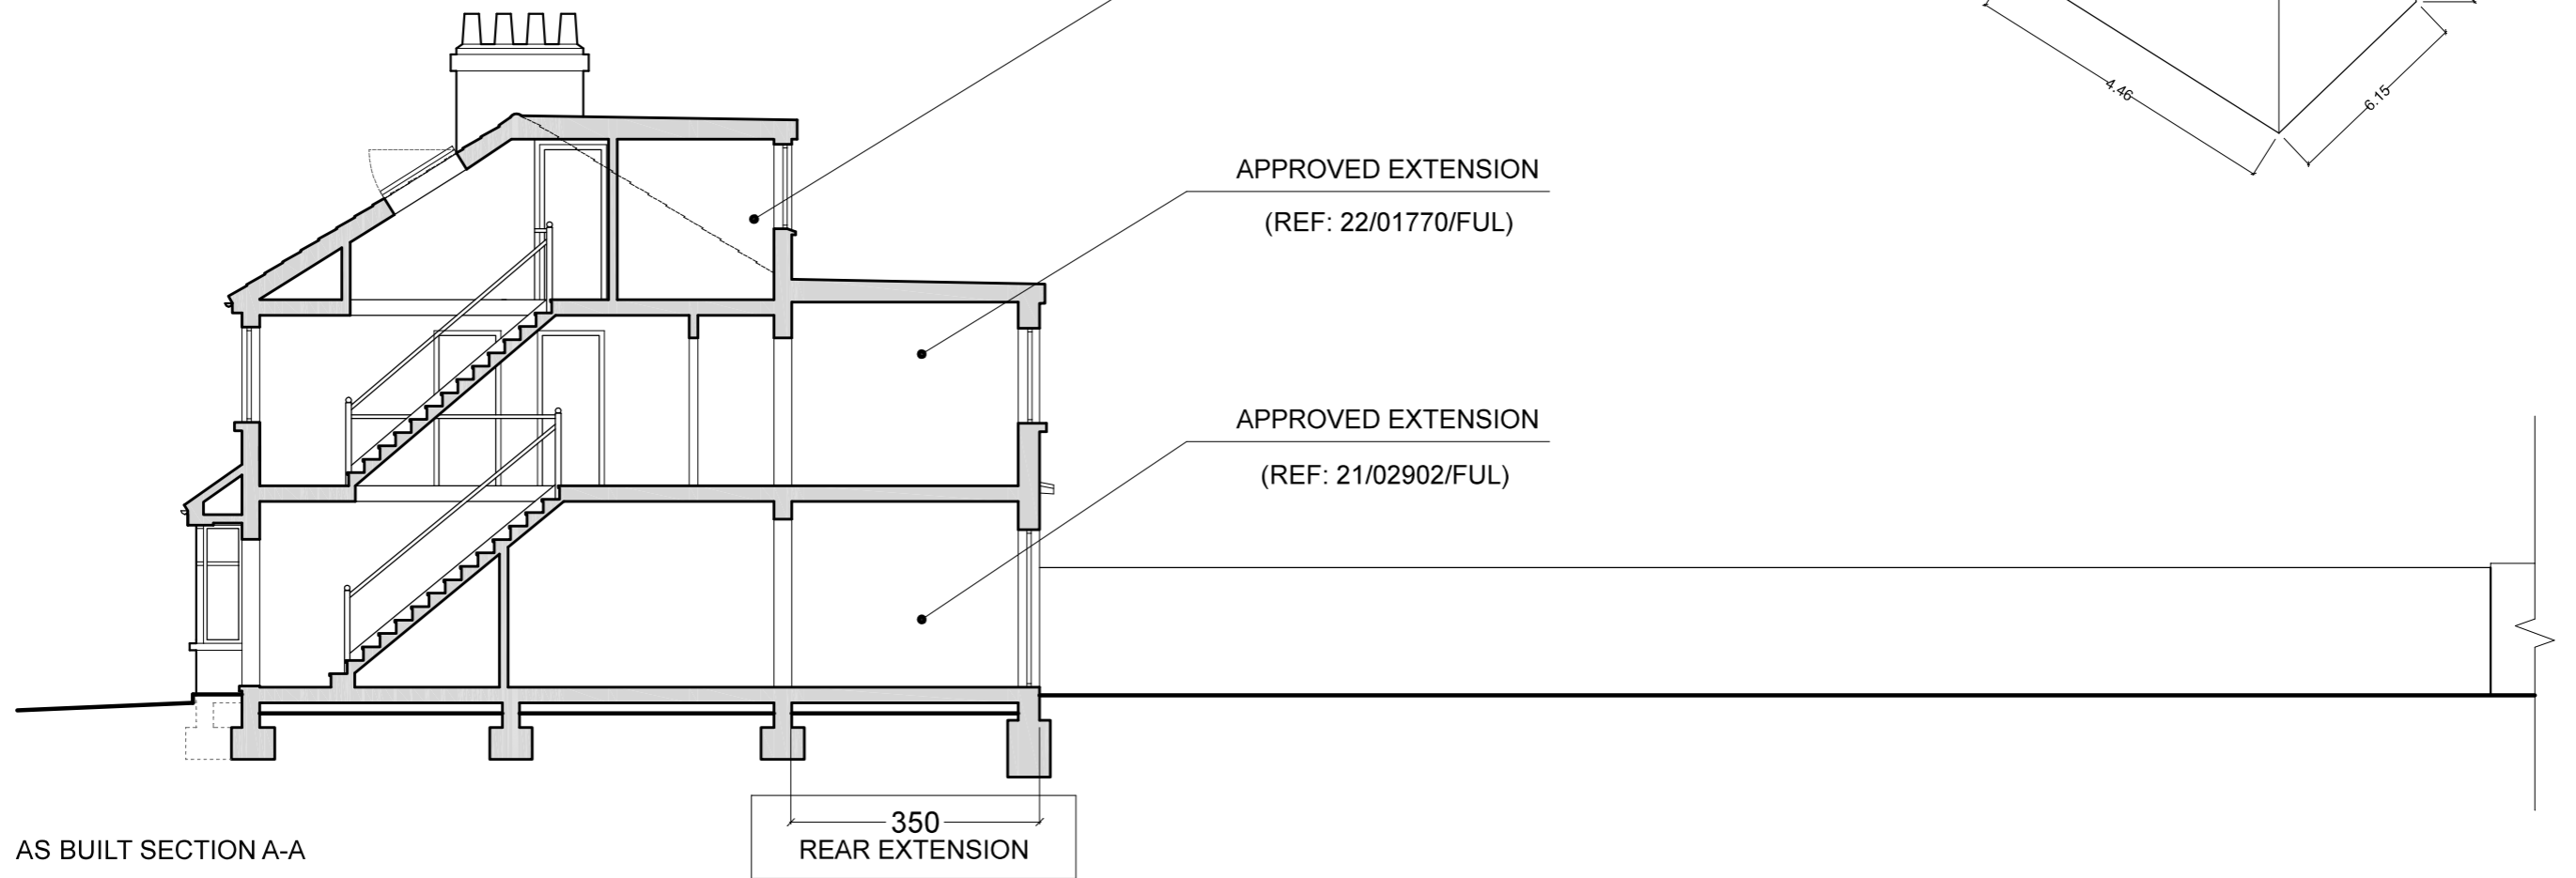

**CANTALEDESIGN**  
ARCHITECTS

CANTALE DESIGN ARCHITECTS LTD

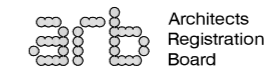

studio@cantaledesign.com  
Tel: 0800 644 6419  
123 Trafalgar Road, Greenwich - LONDON SE10 9TX

RETROSPECTIVE PLANNING APPLICATION

119 MYPLACE ROAD  
BEXLEYHEATH - KENT - DA7 6ER

AS BUILT SECTION

13

SCALE 1:100 @ A3

JAN - 2024