



AS BUILT GROUND FLOOR PLAN


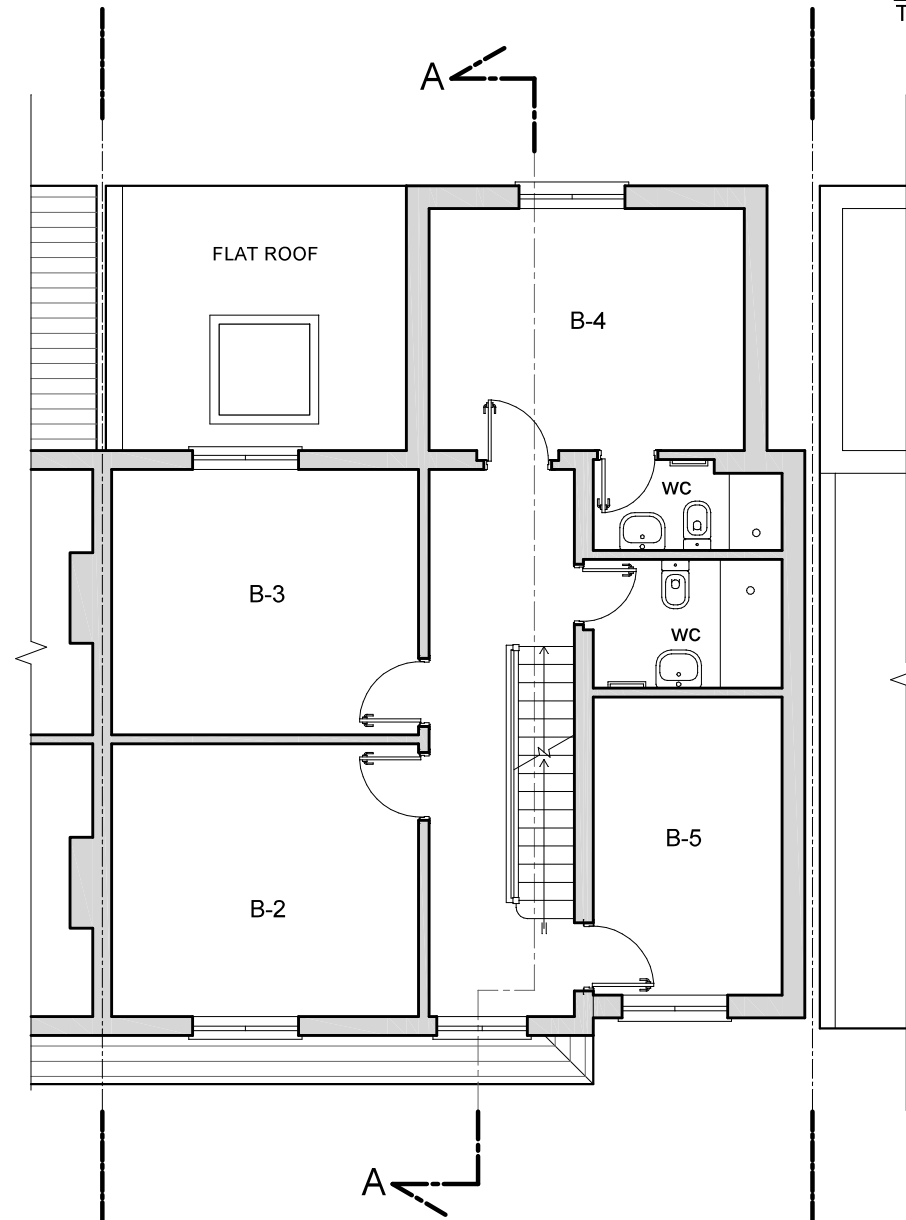


AS BUILT UPPER FLOOR PLAN

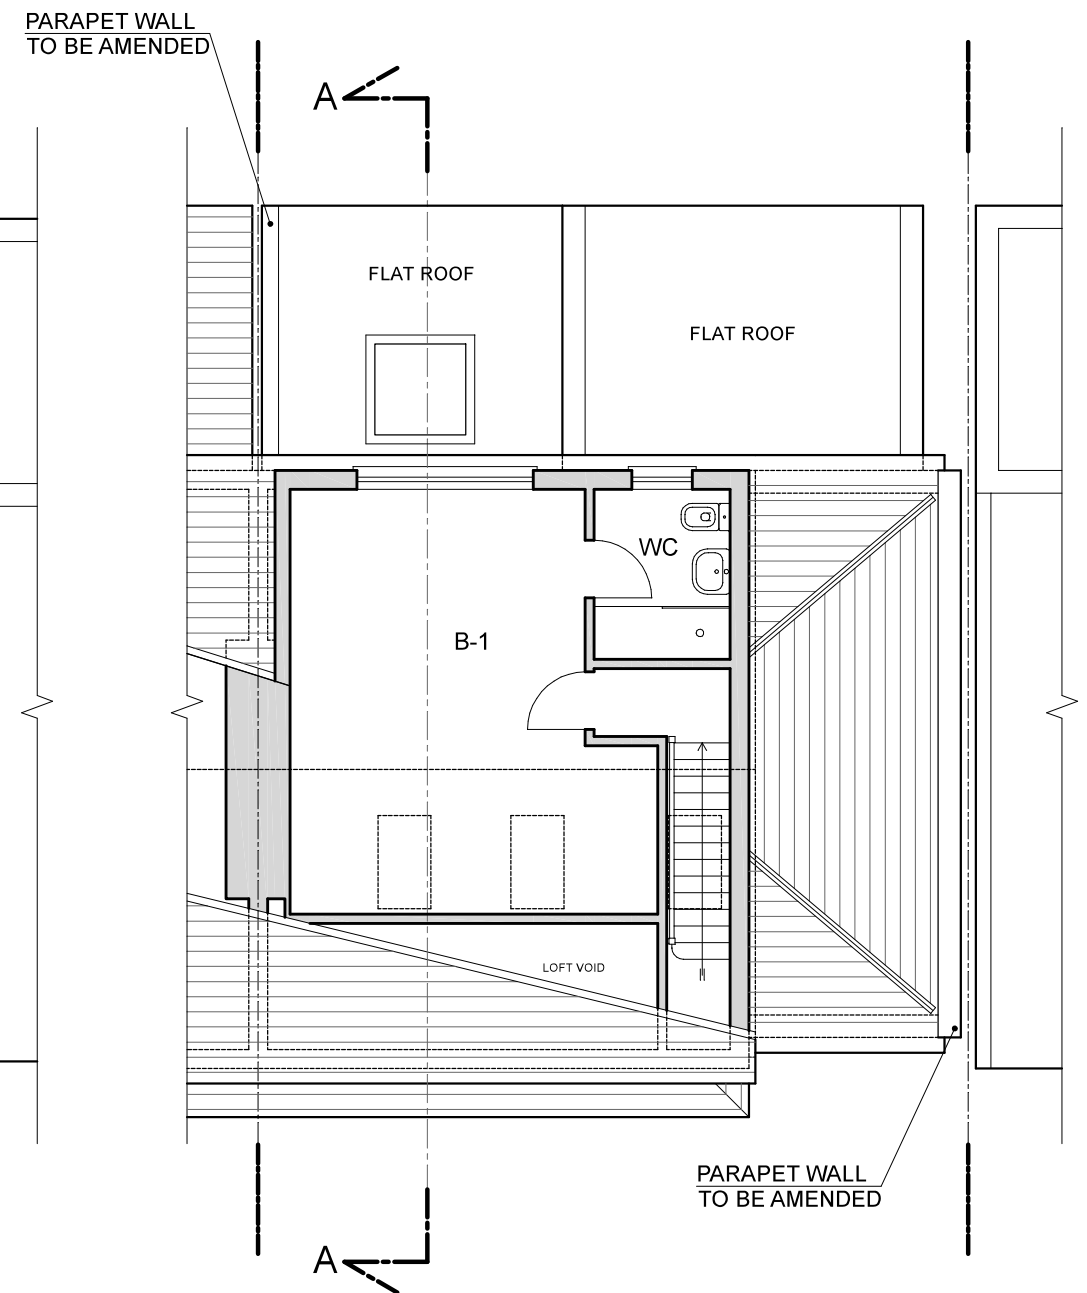


AS BUILT LOFT FLOOR PLAN

HIP-TO-GABLE ROOF, LOFT CONVERSION AND DORMER EXTENSION
BUILT AS PERMITTED DEVELOPMENT

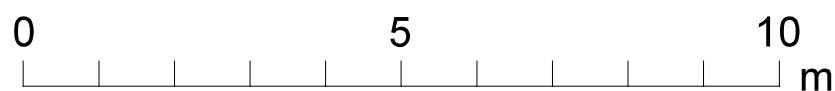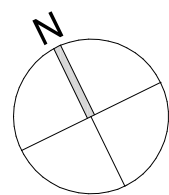

CANTALEDESIGN
ARCHITECTS

CANTALE DESIGN ARCHITECTS LTD

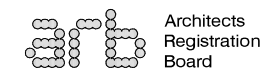

studio@cantaledesign.com
Tel: 0800 644 6419
123 Trafalgar Road, Greenwich - LONDON SE10 9TX

RETROSPECTIVE PLANNING APPLICATION

119 MYPLACE ROAD
BEXLEYHEATH - KENT - DA7 6ER

AS BUILT FLOOR PLANS

11

SCALE 1:100 @ A3

JAN - 2024

All dimensions to be checked on site • Any indication of services is approximate only and full investigation should be carried out prior to commencing the works • It is the responsibility of the contractor to comply with building regulations whether or not wholly depicted on this drawing • This drawing is to be read in conjunction with any specialist structural, geotechnical or mechanical design by others © Bruno Cantale