



Side Elevation to Bridge Street (as built)

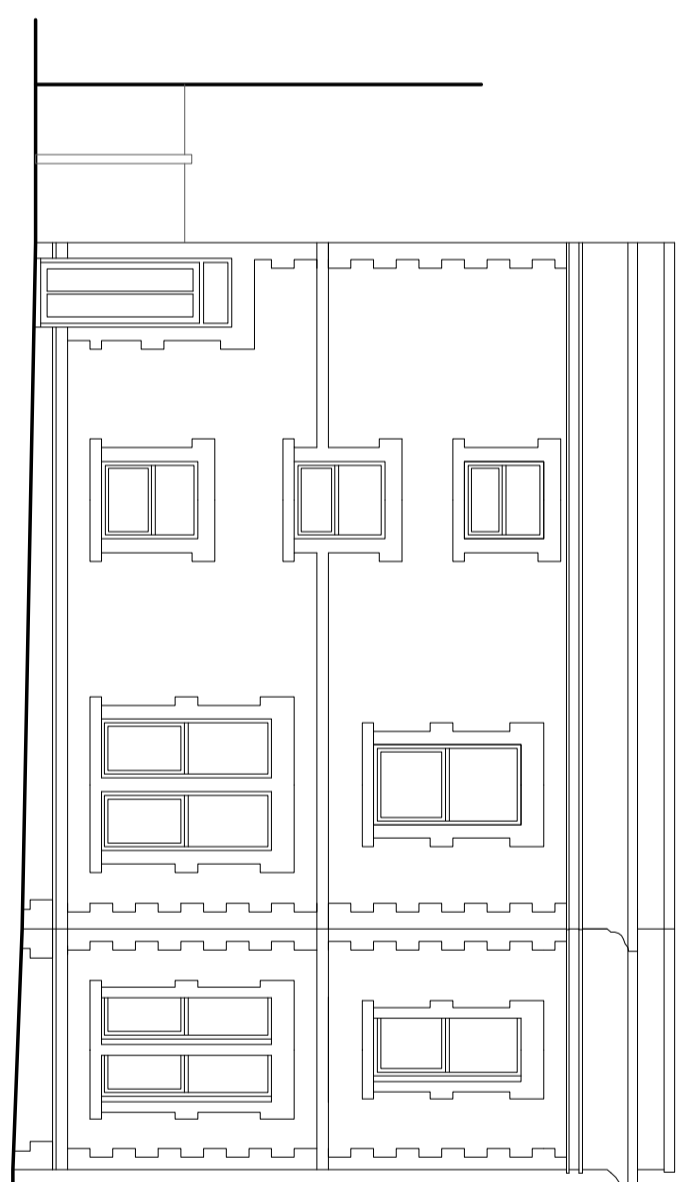


Side Elevation to Salisbury Street (as built)

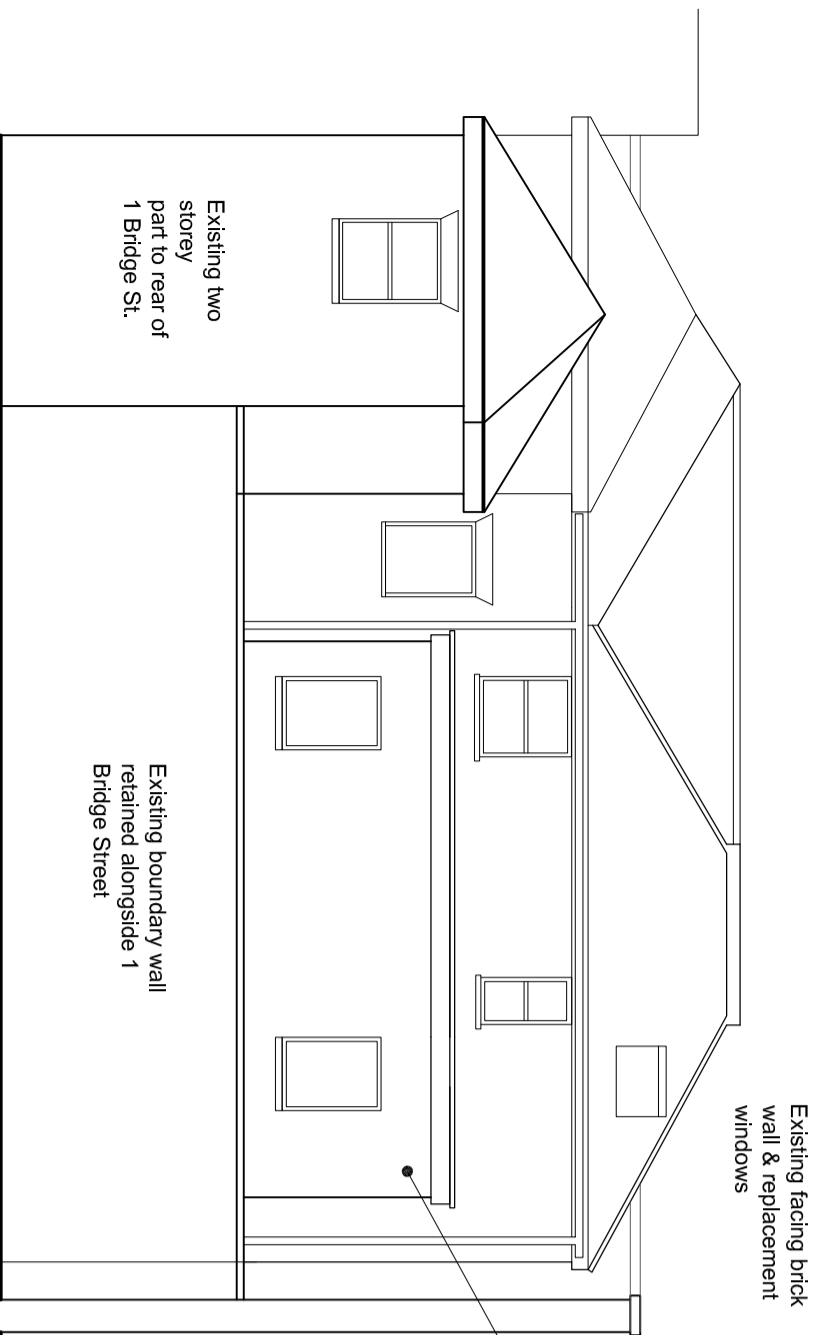

Internal Courtyard Side Elevation (as built)




Internal Courtyard Sectional Elevation on X - X - as-built

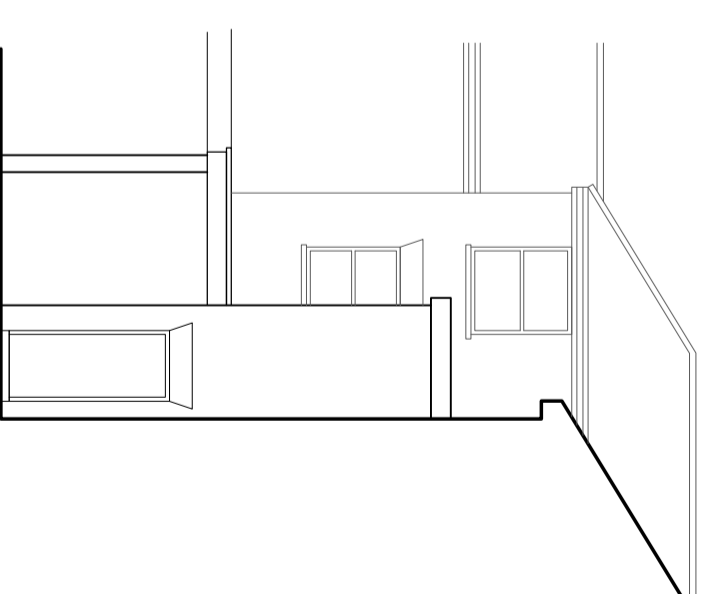

Internal Courtyard Front Elevation (as built)



South East (Front) Elevation of Bungalow (as built)

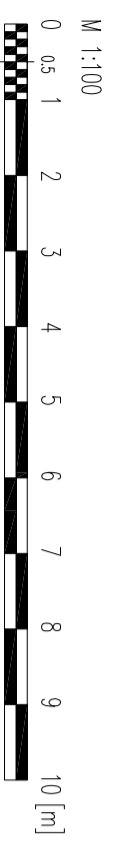

1:100 scale @ A2

Do not scale off this drawing. All Dimensions to be checked on site by the contractor.

PLANNING

Architectural & Design Development

23 First Glen Road
7 Talbot Park
Barnet, London
Middlesex
DN22 9LS

Tel:01202 . 527426
Mobile: 0781 1282136
Email : architecturaldesign_63@yahoo.co.uk

Client : Hornt's Developments Ltd,
18 Neale Corner,
2 Both Road,
Hounslow,
Middlesex. TW3 3HU

Project
1 Bridge Street,
Fordingbridge,
Hampshire
SP6 1AH

Dwg Title:	Job No.
Elevations As built	A/535
	Dwg No. 04
	Drawn: PN

Scale: 1:100 @ A2 Date: Nov 2023