




Scale Bar

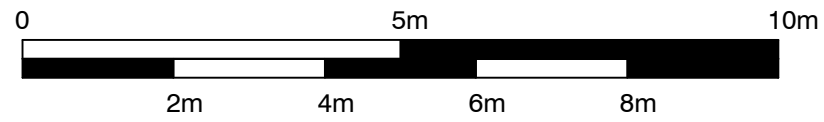

Do not scale, use figured dimensions only. All discrepancies to be notified to Artech Designs Limited. This drawing remains the copyright of Artech Designs Limited.

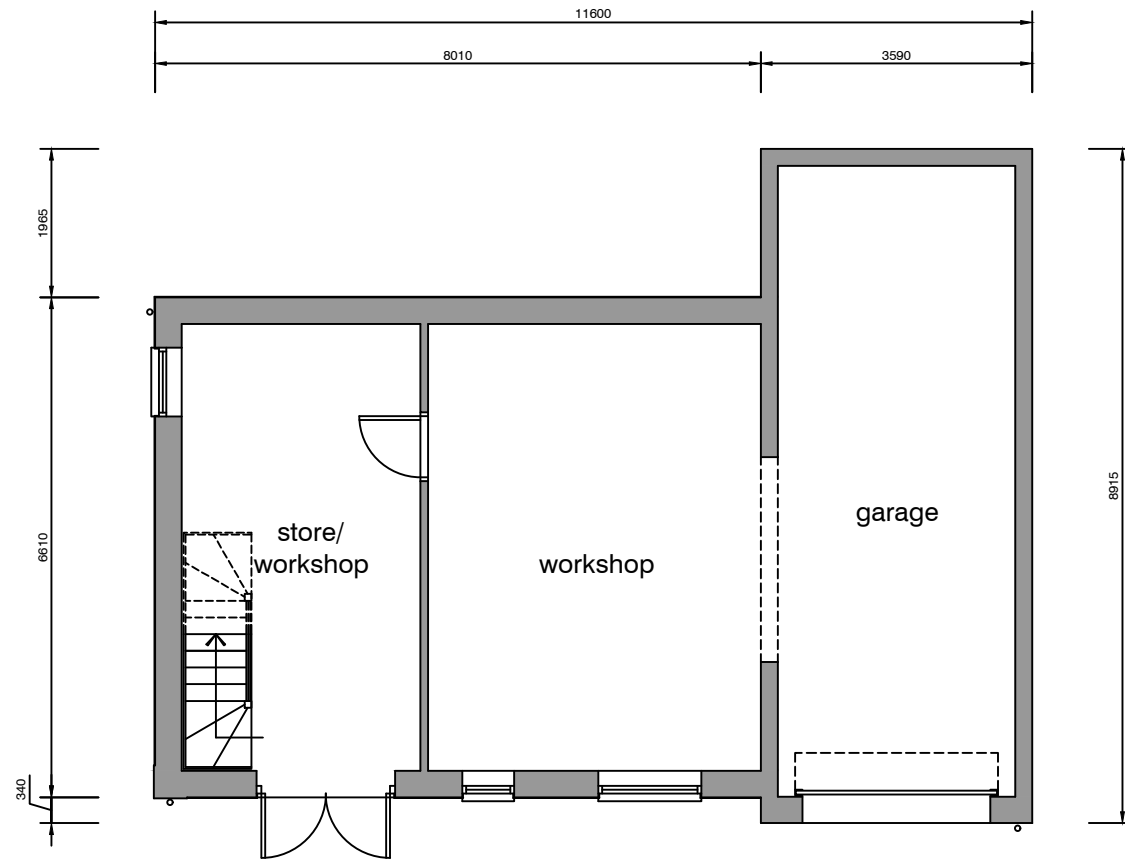


Ground Floor Plan

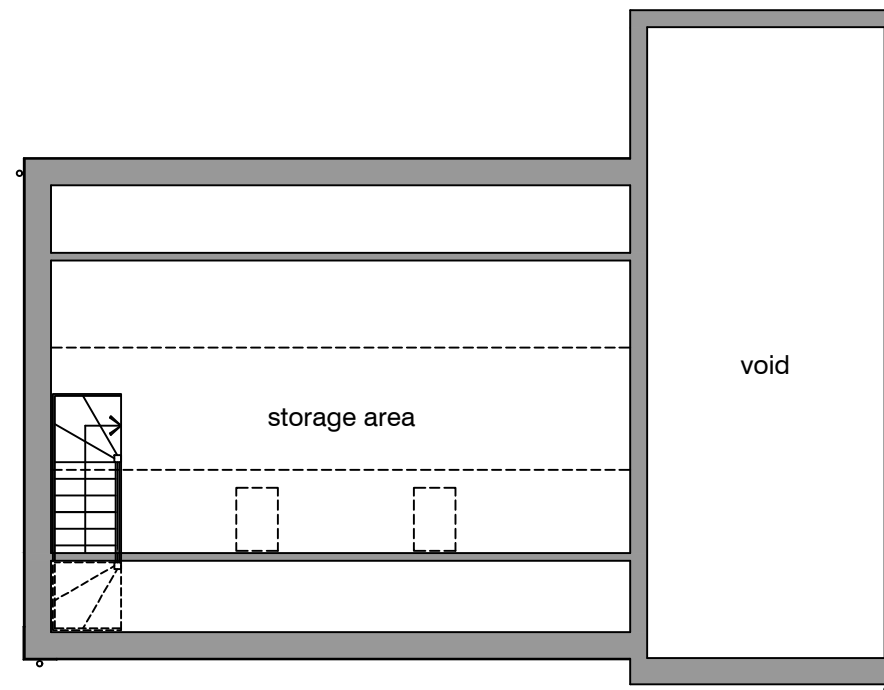

First Floor Plan

A	Minor amendments to 'as built'	23-01-24
Revision	Description	Date
Mr J Foster		
Replacement Garage & Workshop 92 Jerusalem Road, Skellingthorpe Lincoln, Lincolnshire		
Drawing: Proposals - Floor Plans		
Status:	Planning	
Scale:	1:100 @ A3	
Date:	November 2022	
Drwg. No:	1305H/102	
Revision: A	Drawn by .	



Artech Designs Ltd
Architectural Consultants
6 Meadow Rise · Saxilby
Lincoln · LN1 2HW
Tel 01522 803362
Mob 07808 815366
martin@artechdesigns.co.uk
www.artechdesigns.co.uk