



Scale Bar

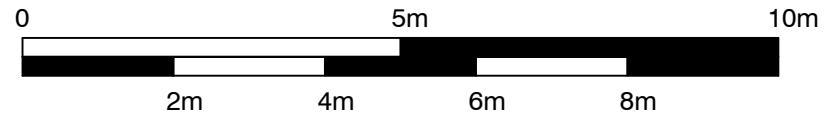


Do not scale, use figured dimensions only. All discrepancies to be notified to Artech Designs Limited. This drawing remains the copyright of Artech Designs Limited.




Front Elevation

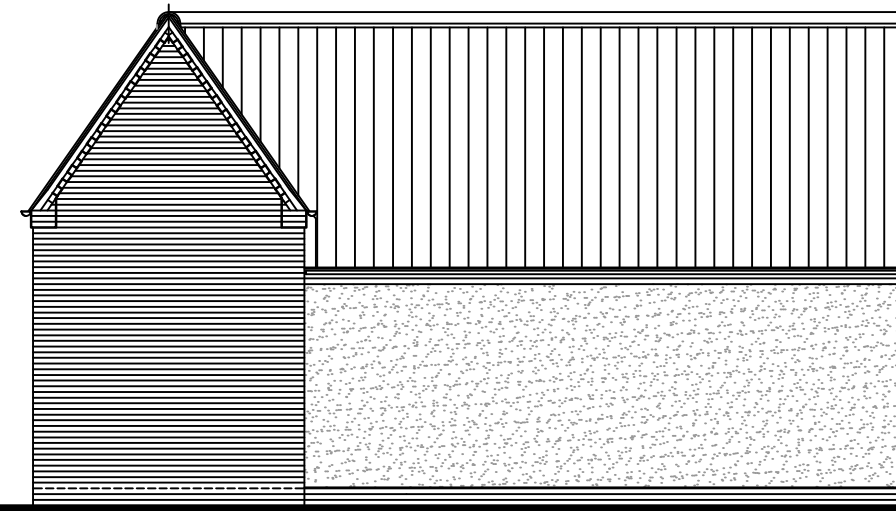

Rear Elevation

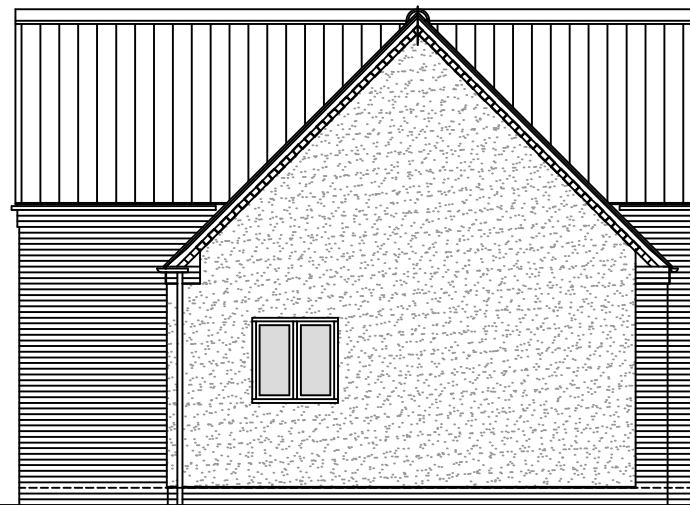


Side Elevation

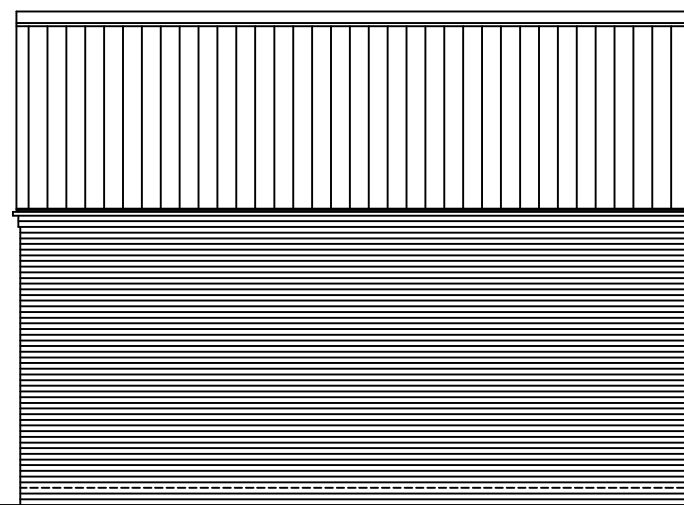

Side Elevation

B	Minor amendments to 'as built'	23-01-24
A	Dims Added	18-01-23
Revision	Description	Date
<b>Mr J Foster</b>		
Replacement Garage & Workshop 92 Jerusalem Road, Skellingthorpe Lincoln, Lincolnshire		
Drawing: Proposals - Elevations		
Status:	Planning	
Scale:	1:100 @ A3	
Date:	November 2022	
Dwg. No:	1305H/103	
Revision:	B	Drawn by .



**Artech Designs Ltd**  
Architectural Consultants  
6 Meadow Rise · Saxilby  
Lincoln · LN1 2HW  
Tel 01522 803362  
Mob 07808 815366  
martin@artechdesigns.co.uk  
[www.artechdesigns.co.uk](http://www.artechdesigns.co.uk)