



Do not scale from this drawing except for planning purposes  
Only figured dimensions are to be used  
Report any discrepancies to the Architect  
If in doubt ask

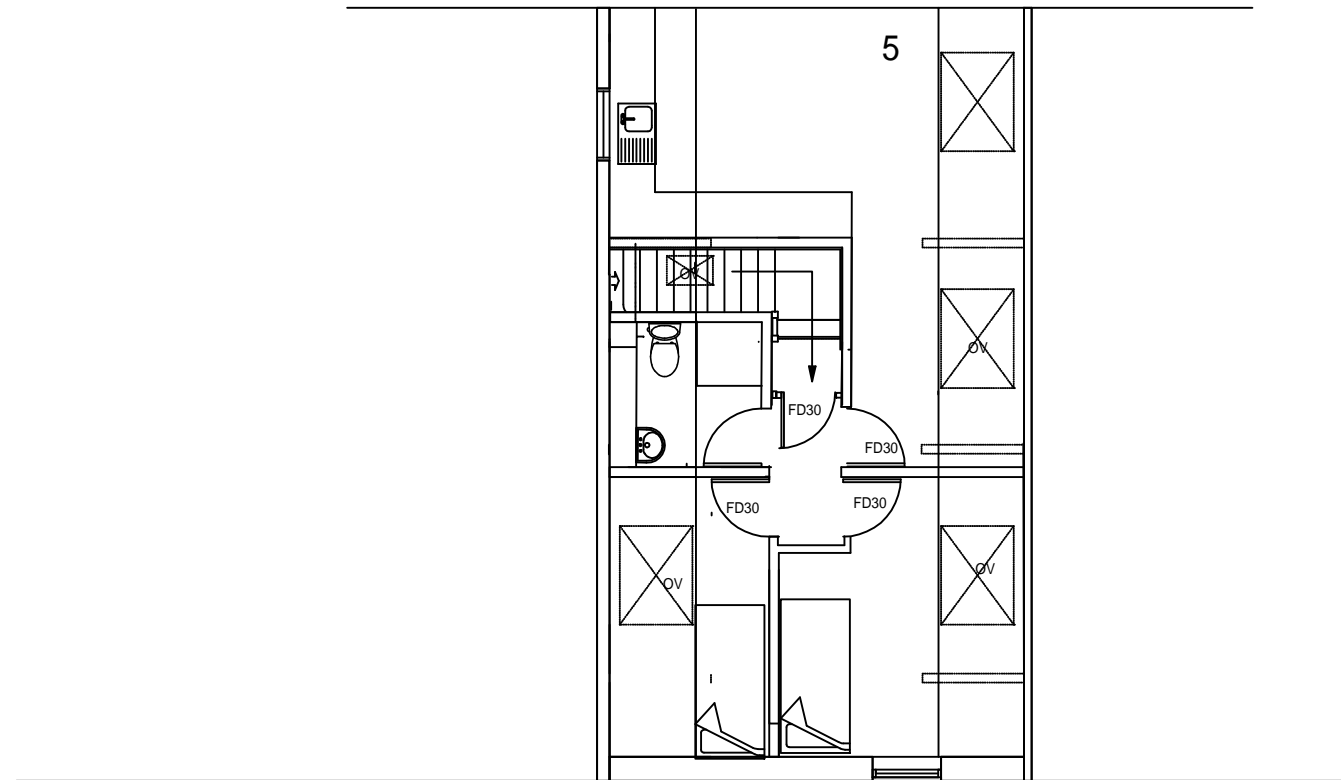

Second Floor Plan

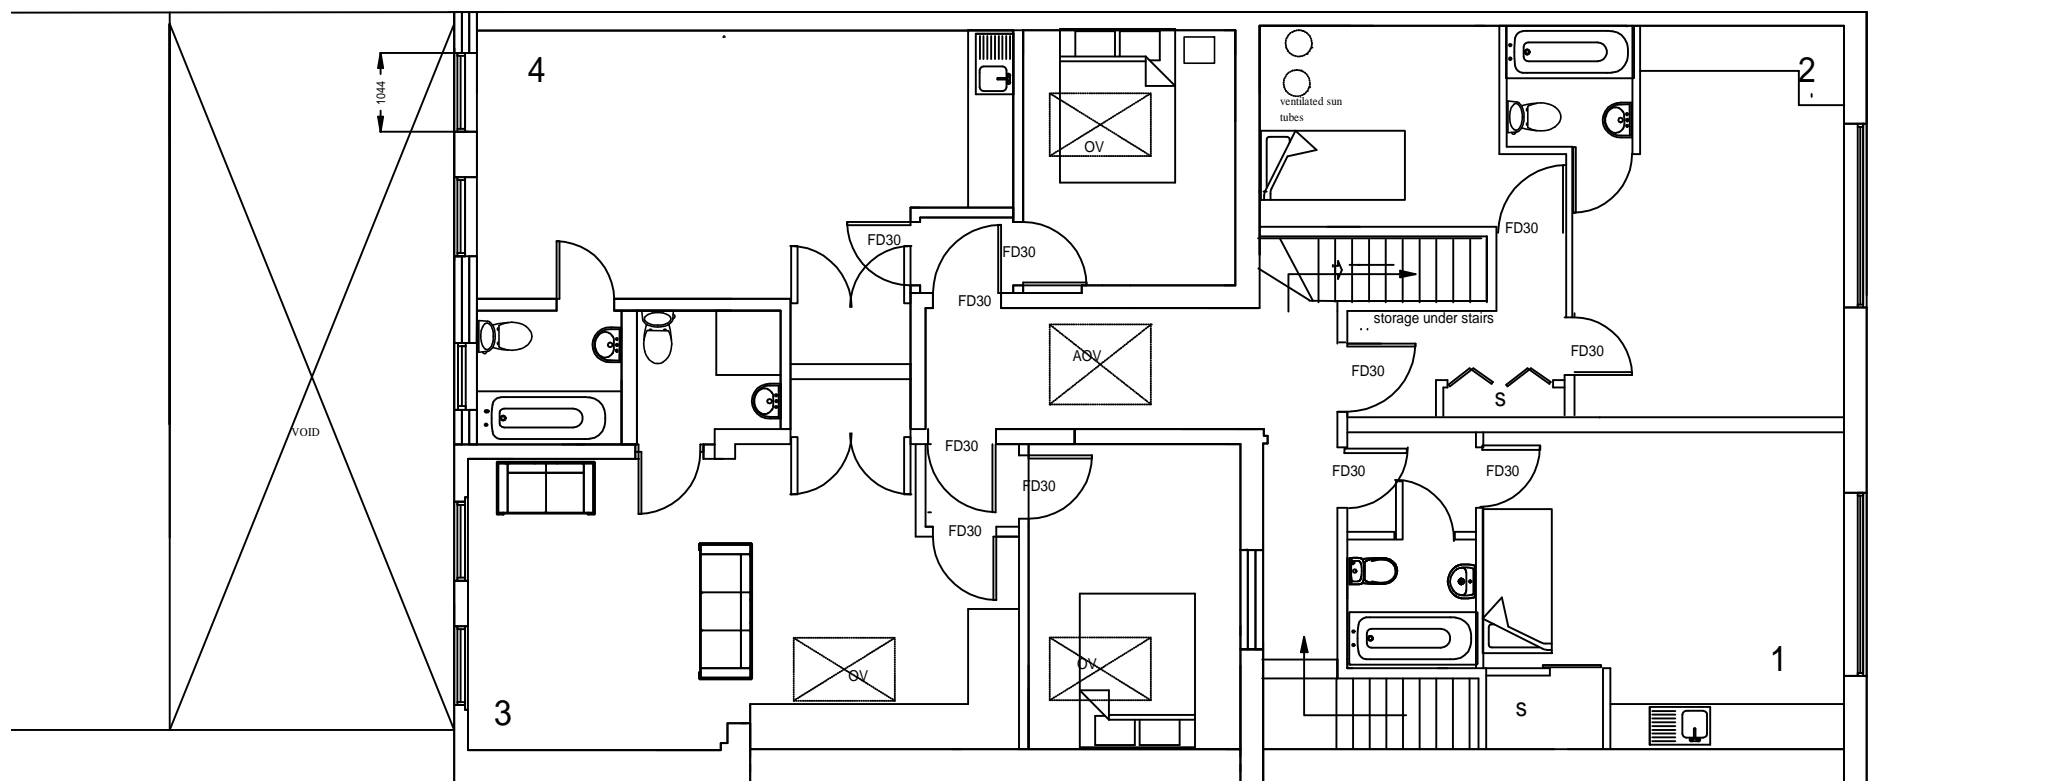

First Floor Plan

**Robin Jones Architectural Consultant**

68 Countess Wear Road

EXETER EX2 6LR

07836 723578

E Mail [robincjones1@outlook.com](mailto:robincjones1@outlook.com)

Project

26 Gold Street Tiverton

Drawing

As Built First and Second Floor Plans

Scale

1:100 @ A3

Number

1050-13D

This drawing is copyright