



MR ROY FLAVIN

17 BROADLAND WAY, LOFTHOUSE. WAKEFIELD.
WF3 3NY

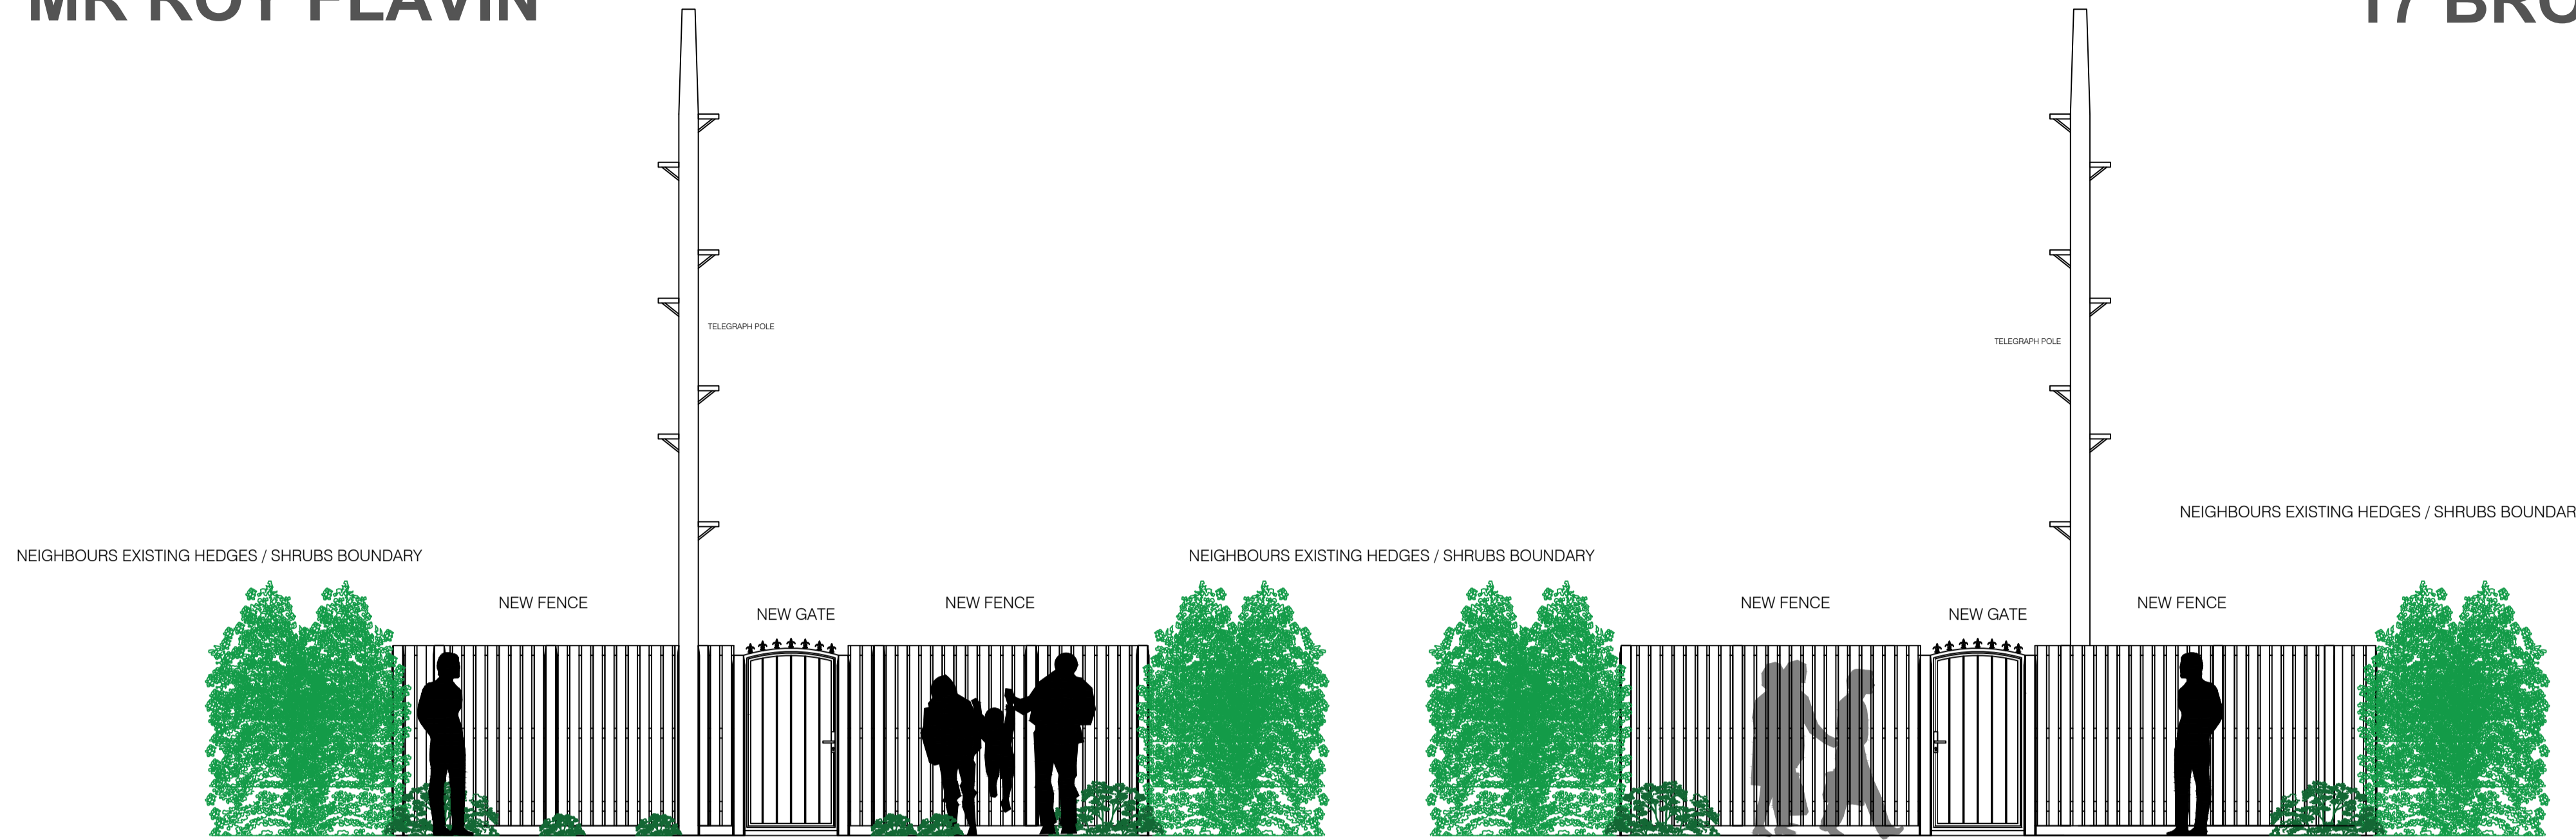


As built Garden Elevation

As built Westgate Lane Elevation

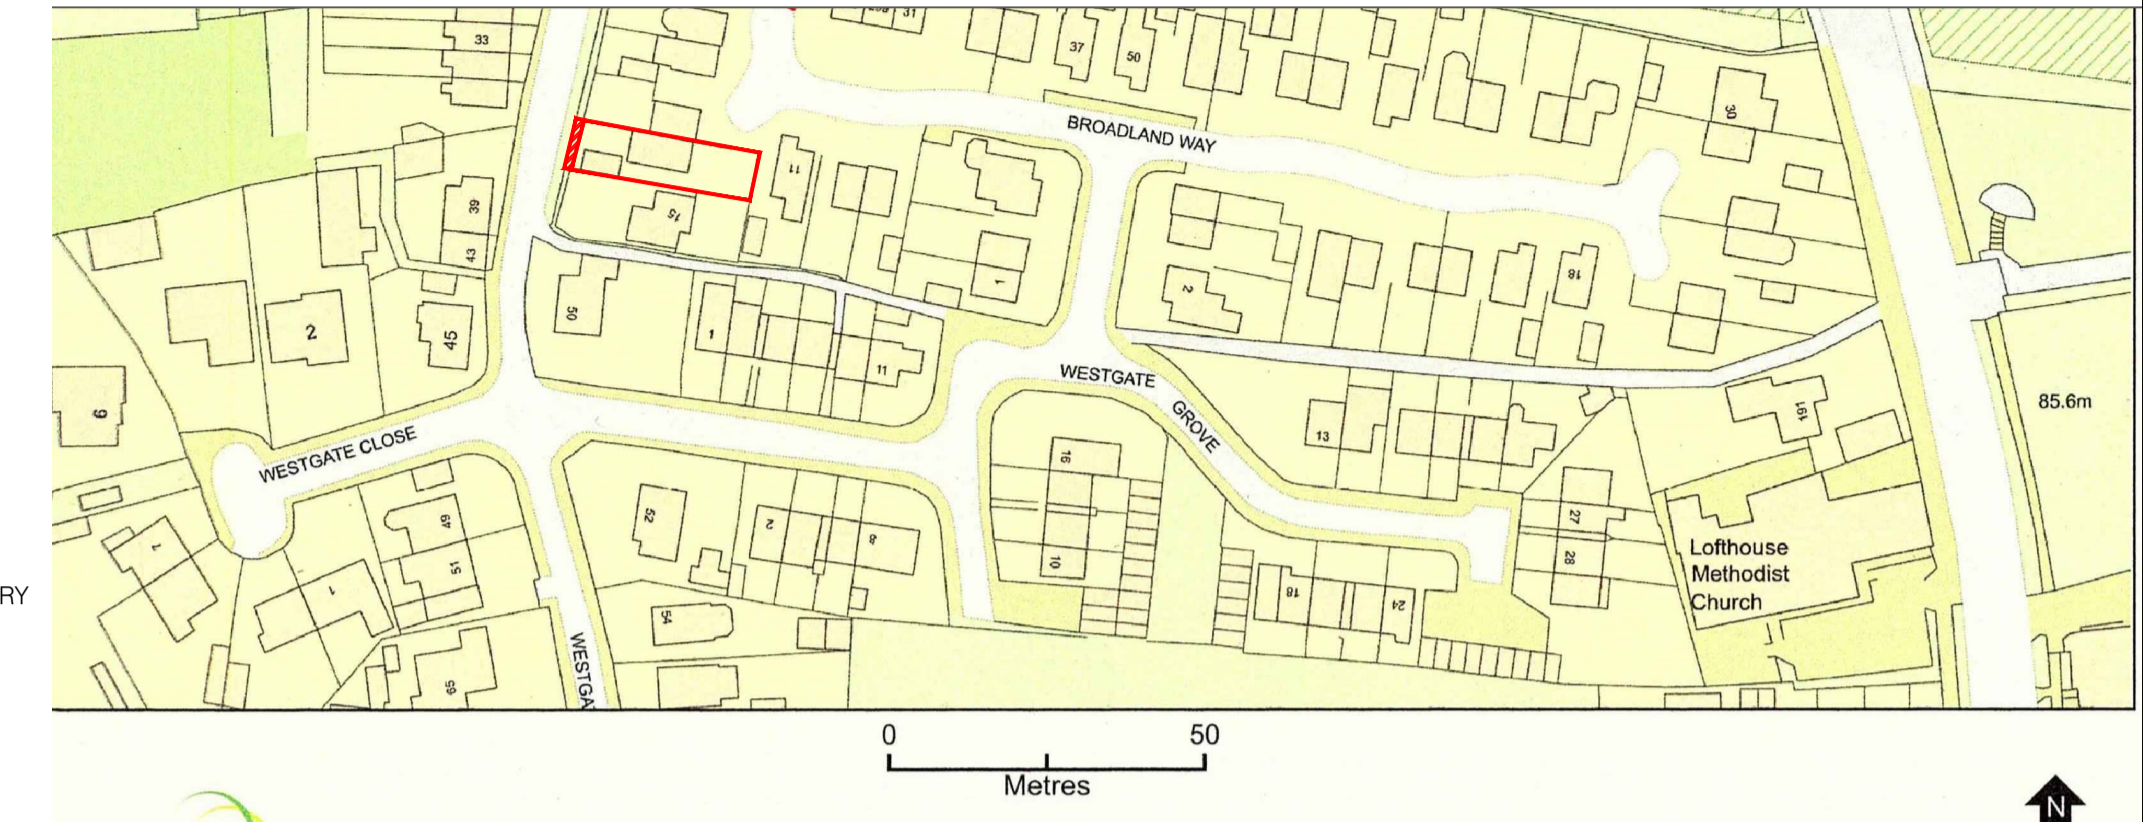

Site location plan
@1:1250 scale

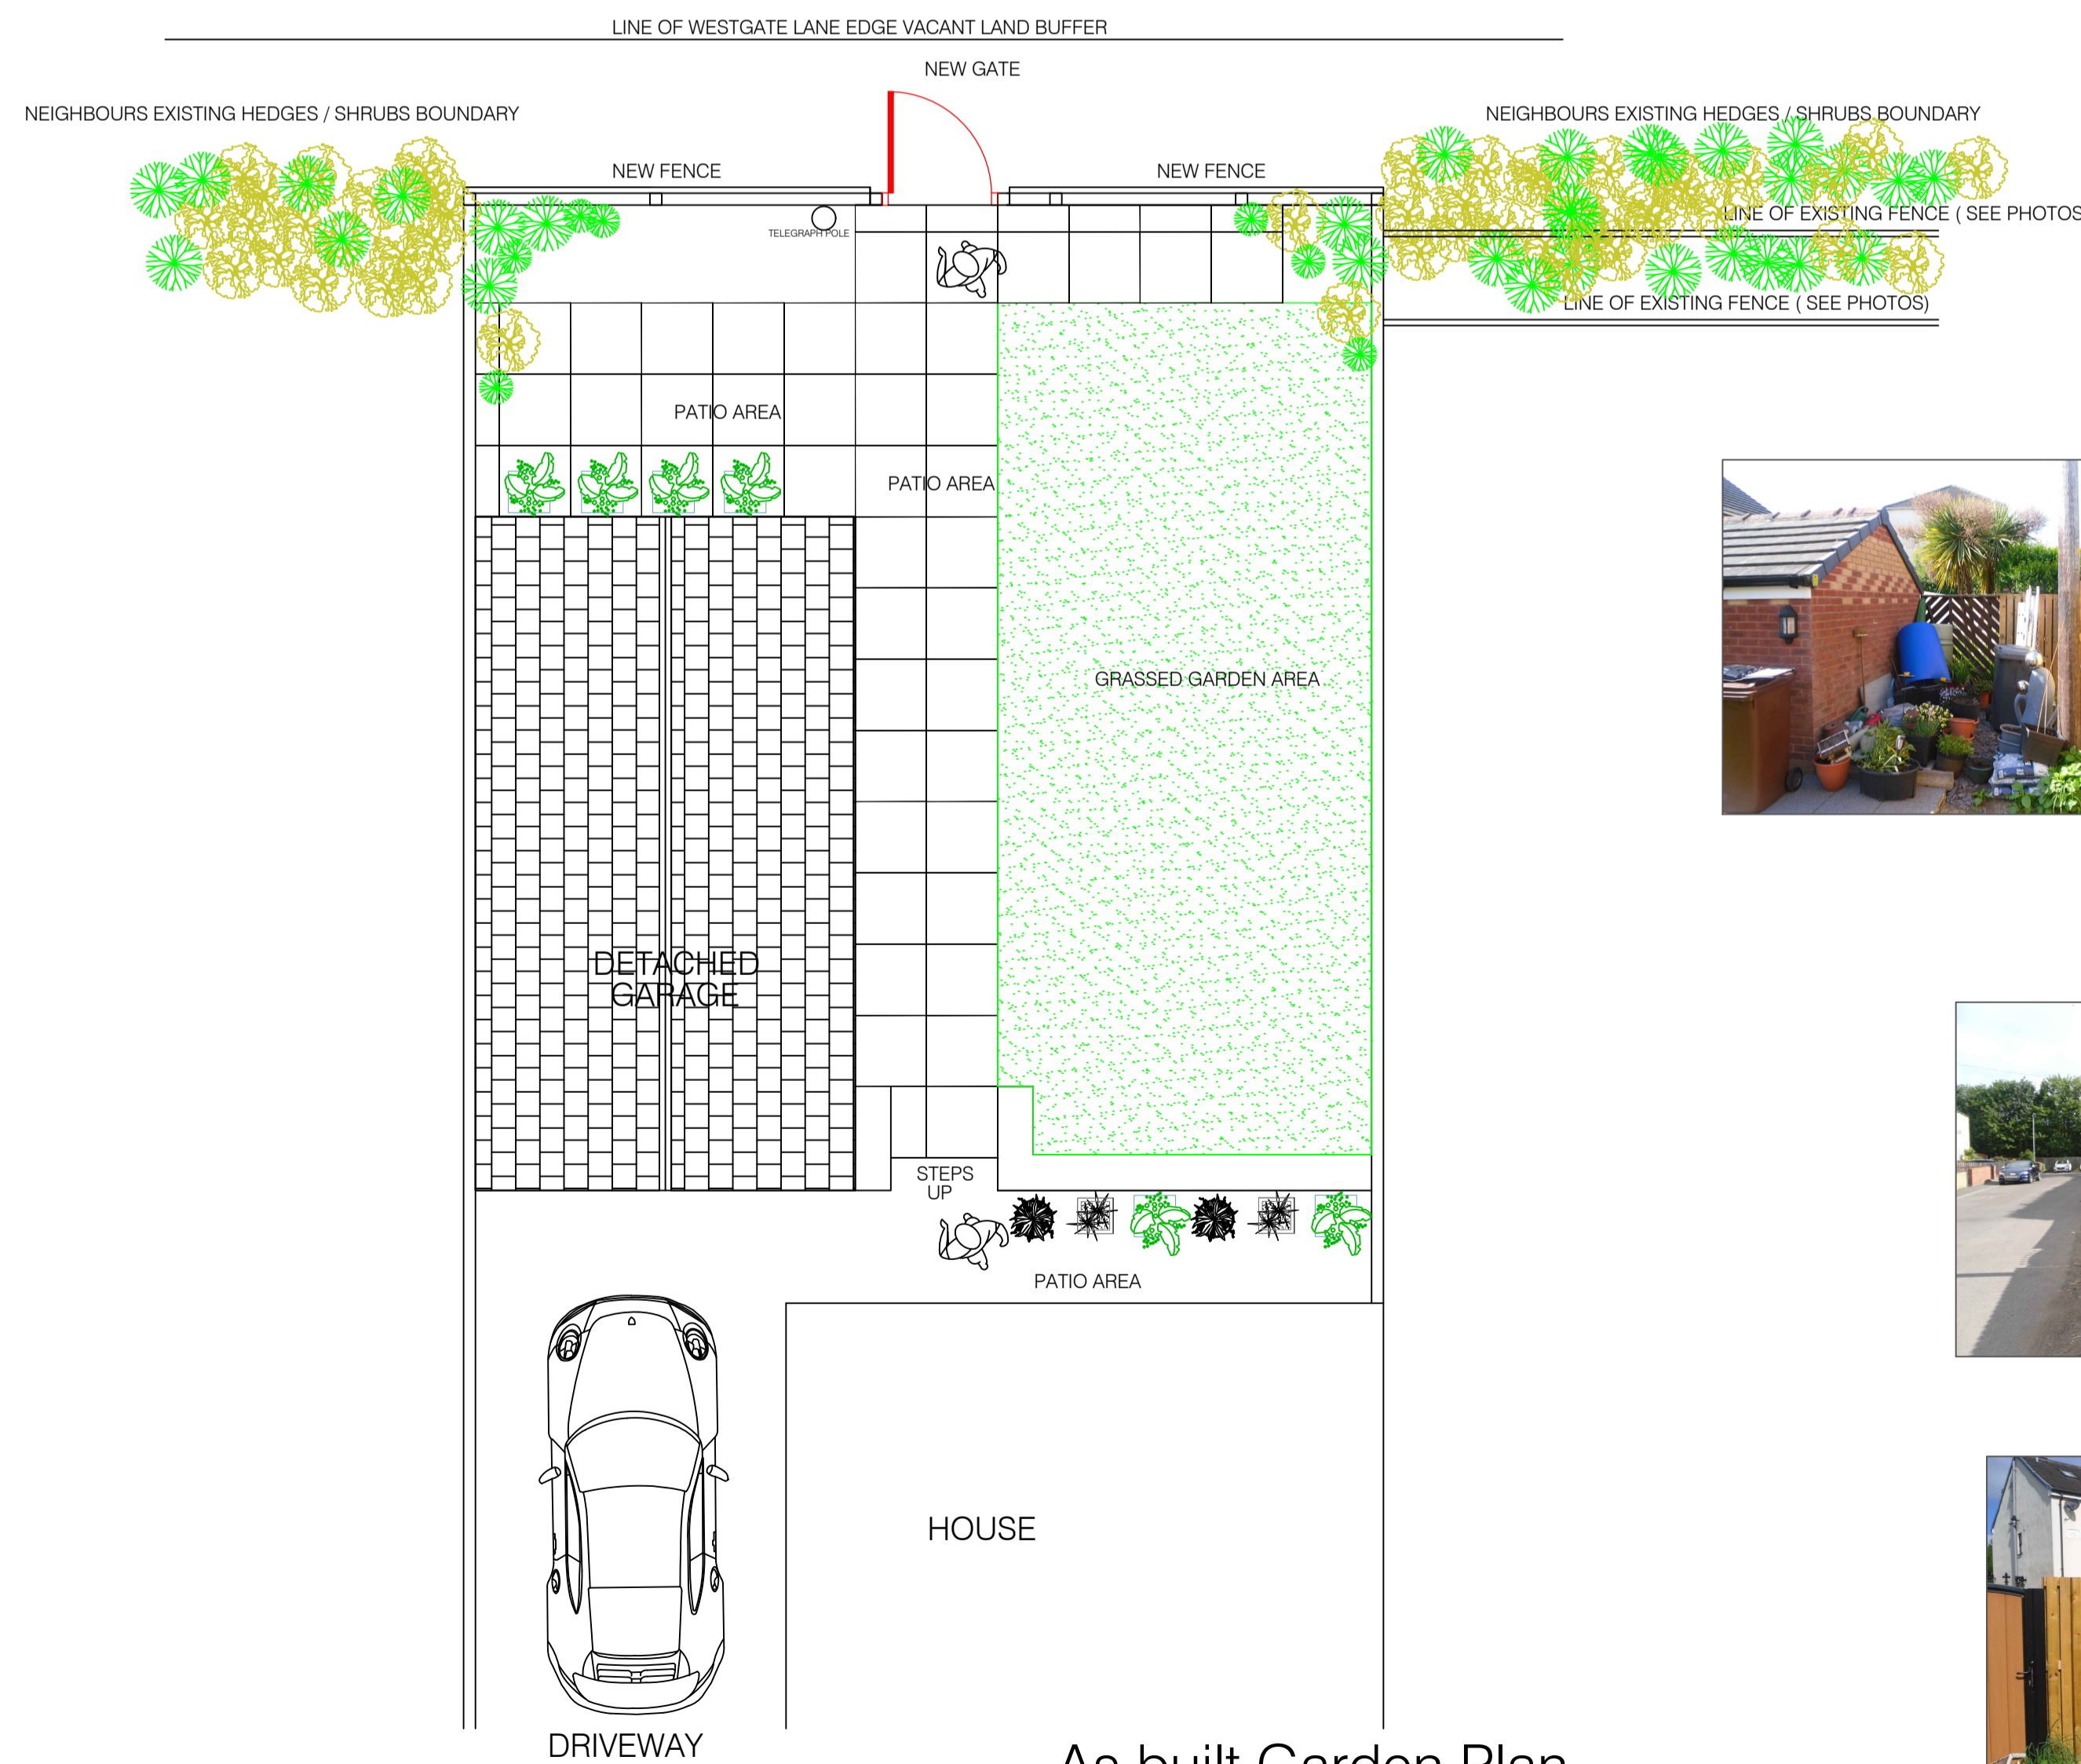

As built Garden Plan



SITE PHOTOS



<ul style="list-style-type: none"> Architectural design Planning & Building Regulations Landscape architecture 3D Visualisation & model making 			
<p>CLIENT</p> <p>MR.ROY.FLAVIN</p>			
<p>17, BROADLAND WAY LOFTHOUSE, WAKEFIELD WF3.3NY</p>			
<p>DRAWING OF</p> <p>RETROSPECTIVE APPLICATION FOR REAR FENCE & GATE TO REAR GARDEN CHANGE OF USE APPLICATION FOR BOUNDARY TREATMENT TO VACANT LAND</p>			
<p>PROPOSED/EXISTING PLANS & ELEVATIONS</p>			
drawing no	rev	date	
DWG-001	A	JAN-2024	
scale	drawn	checked by	checked date
1:50@A1	SMT	RF	JAN-2024

PROPOSED PLANS & ELEVATIONS @ 1:50 SCALE