



Boundary line  
Downtakings in red

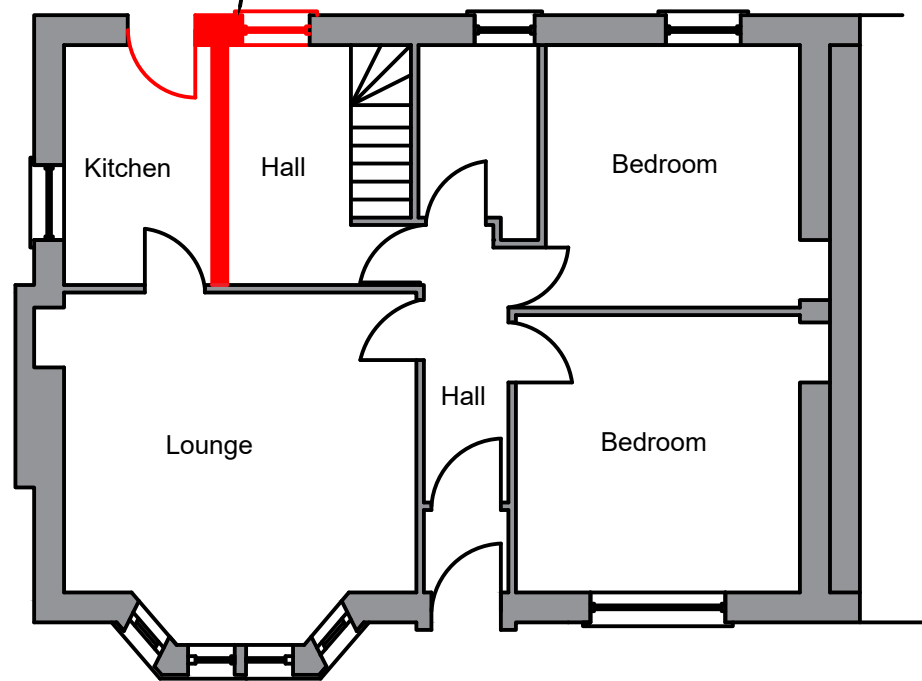

GROUND FLOOR PLAN AS EXISTING  
SCALE 1:100  
DOWN TAKINGS SHOWN IN RED

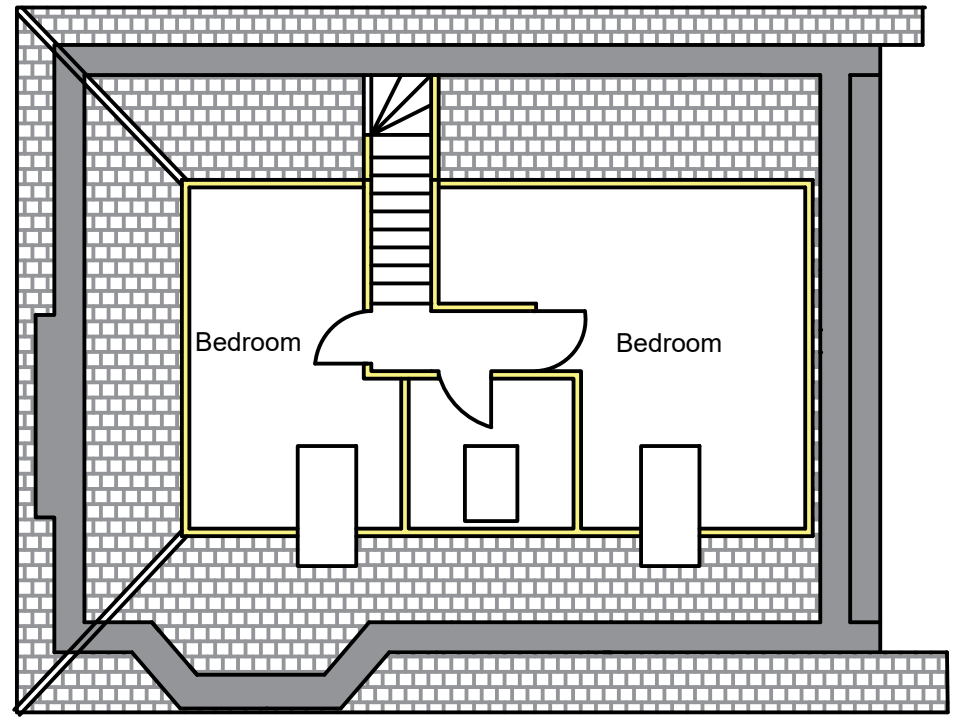

FIRST FLOOR PLAN AS EXISTING  
SCALE 1:100



NOTES:

1. The contractor/subcontractors and suppliers are to verify all dimensions and levels on site prior to making fabrication drawings or commencing manufacture.
2. Do not scale from this drawing, only use figured dimensions.
3. All works to conform to relevant British Standards.
4. When required this drawing is to be read in conjunction with all relevant design drawings and specifications.

Client		Mr R. McKelvie
Address		38 Birkhall Avenue Glasgow G52 2PN
Title		Floor plans as existing.
Issue status		Planning application
Drawn by	Date	CAMLEM Nov. 2023
Drawing No.	Revision	201 -