

195 Holderness Road, Hull, HU8 8TA
Tel: 01482 707499 Mob: 07402 070779


CLIENT
Mrs D Brett
3 Mill Walk
Cottingham
HU16 4RP

JOB TITLE
**Proposed Retrospective
Application For Conservatory**

DWG. TITLE
Existing & As Built Block Plans

SCALE		DRN	
1:200		TP	
DATE	ALTERATION	BY	REV

DWG. NUMBER	DATE	REV
N2762-24-02	Jan 24	-

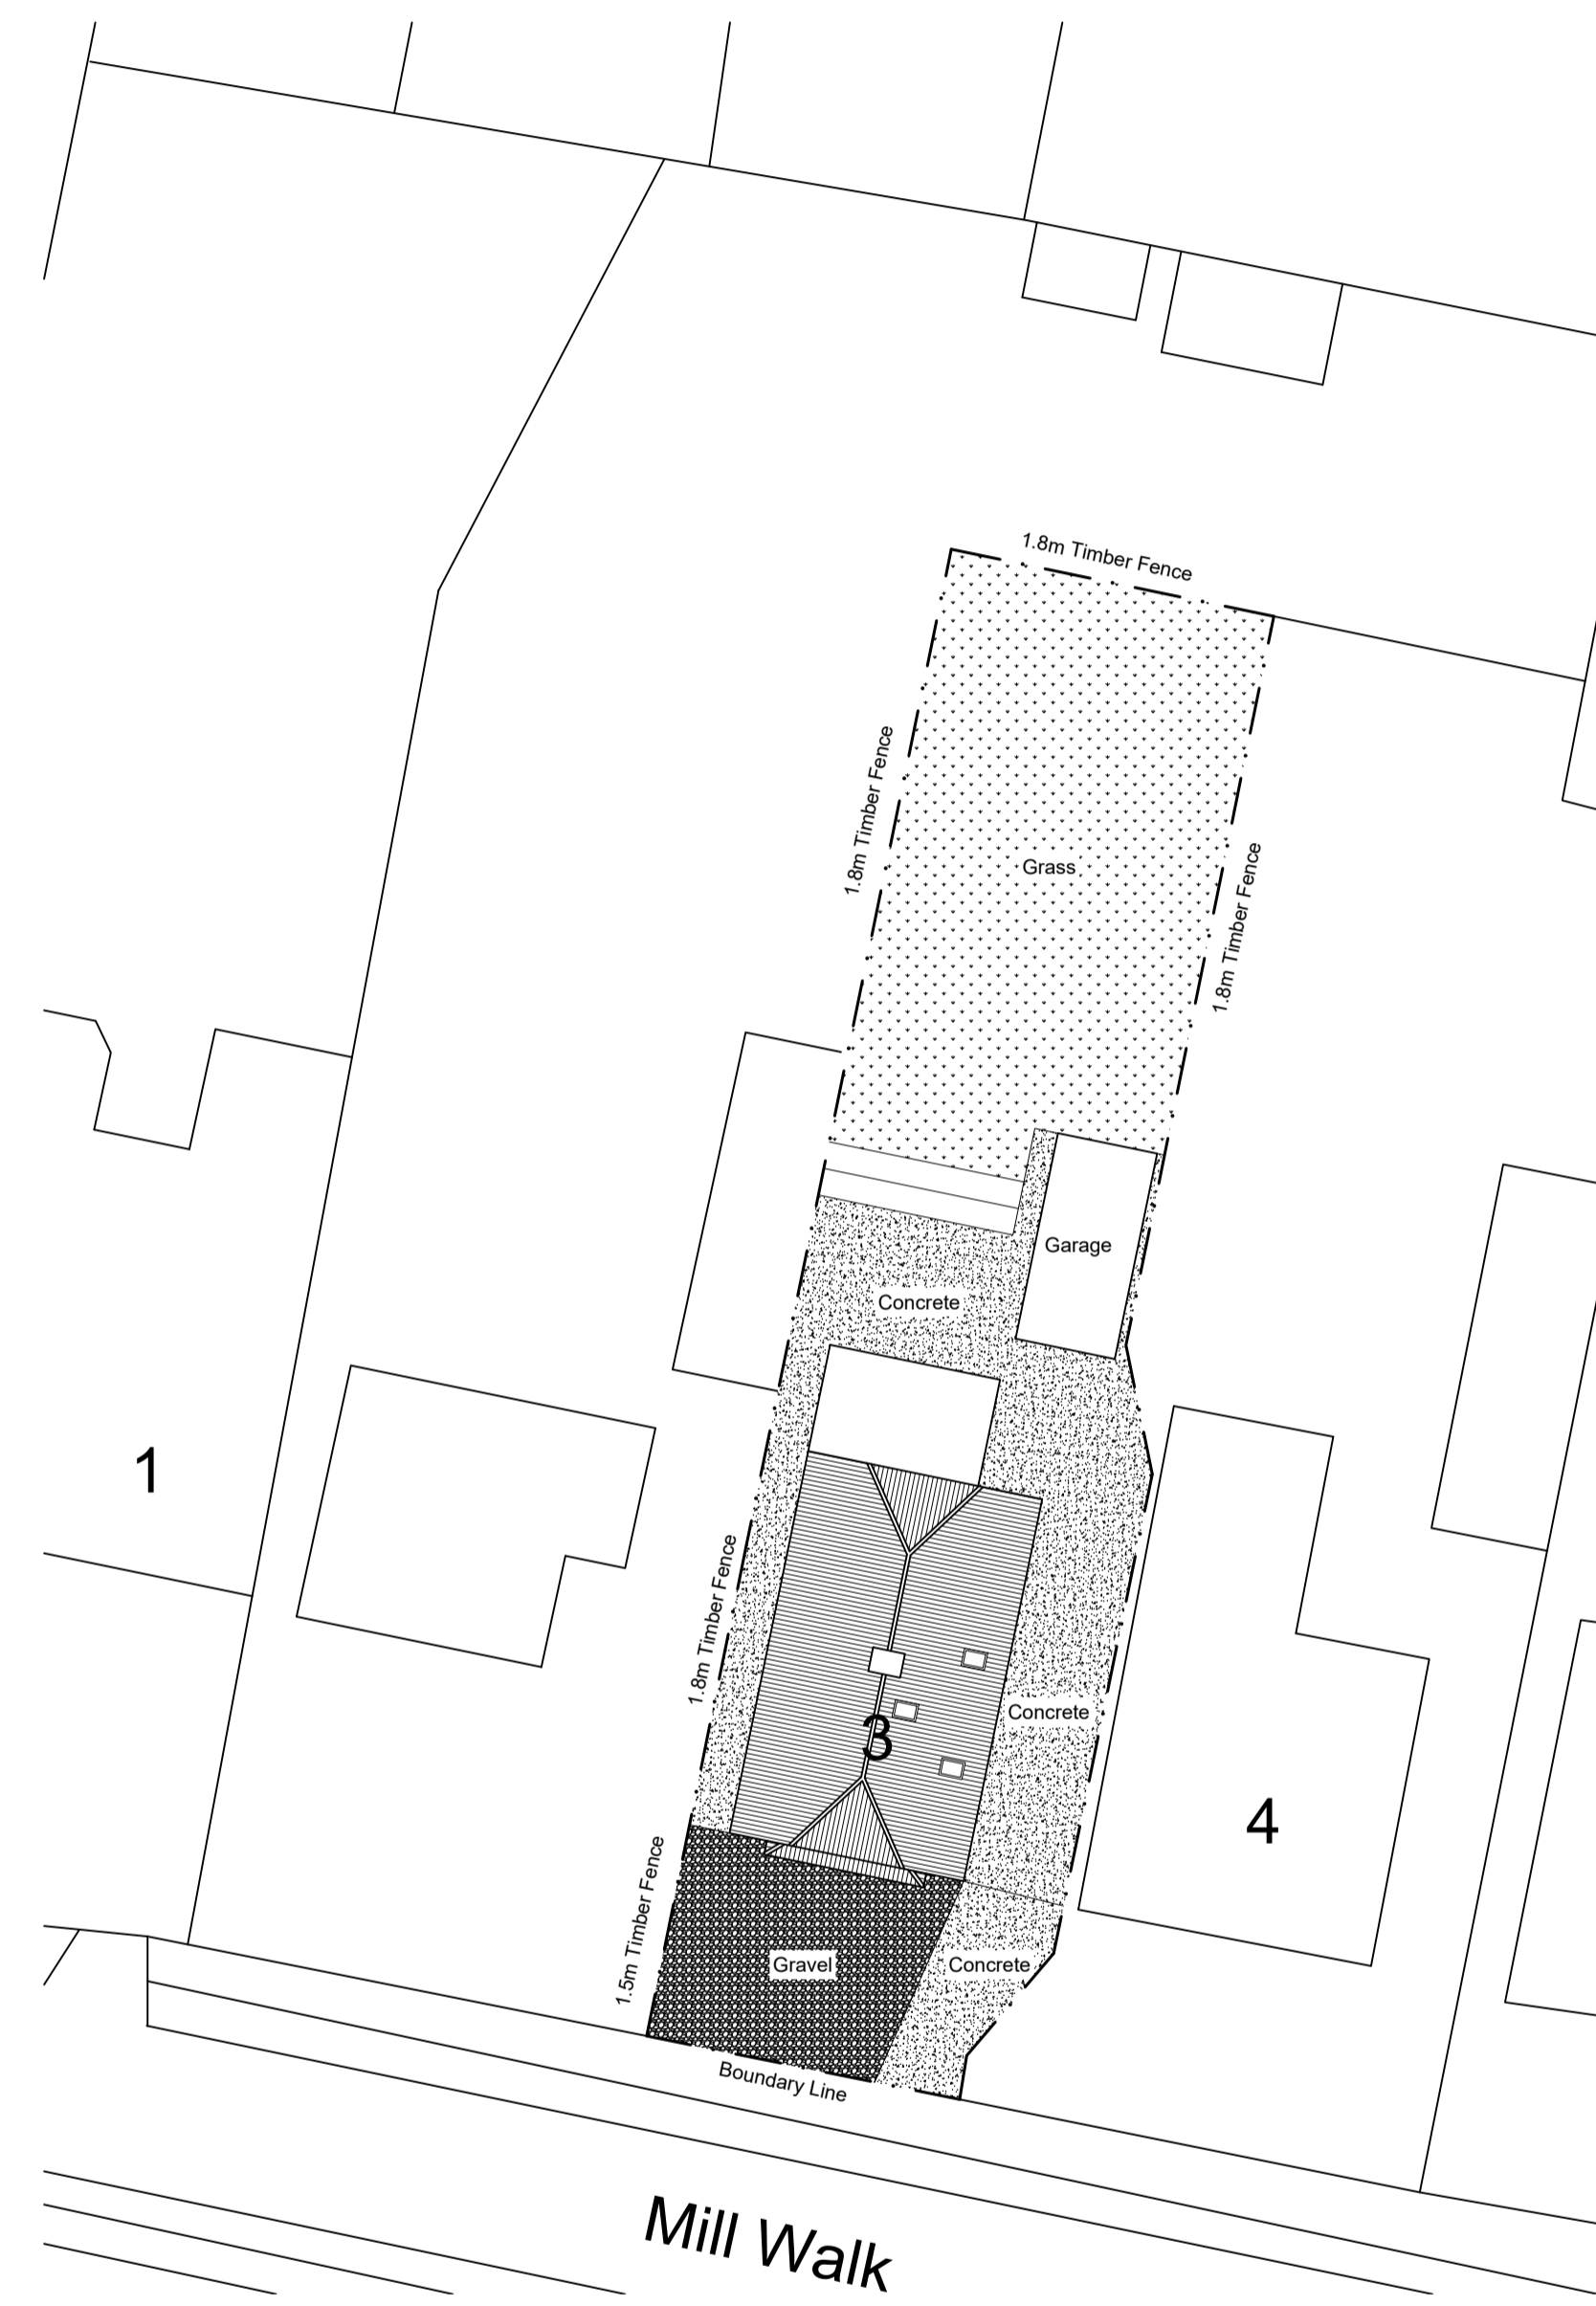

Existing Block Plan - 1:200



As Built Block Plan - 1:200