

NOTE
DRAWINGS TO BE SUBMITTED TO BUILDING CONTROL,
TO AWAIT BUILDING CONTROL COMMENTS / APPROVAL

NOTE
CONTRACTOR IS TO UNDERTAKE A TRIAL HOLE FOR
INSPECTION TO CONFIRM FOUNDATION DESIGN PRIOR
TO ANY COMMENCEMENT OF WORKS ON SITE

NOTE
CLIENT TO ENSURE THAT ALL RELEVANT PARTY WALL
ACT NOTIFICATIONS ARE IN PLACE PRIOR TO THE
COMMENCEMENT OF WORKS ON SITE


Private sewers & Lateral Drainage
On commencement of building works a thorough investigation
of drainage should be undertaken on site to establish if any
Private sewers & Lateral Drainage owned by the Local
Sewerage Undertake (Yorkshire Water) will be affected by the
proposed building work



Existing Rear Elevation -1:100 A1




Existing Side Elevation

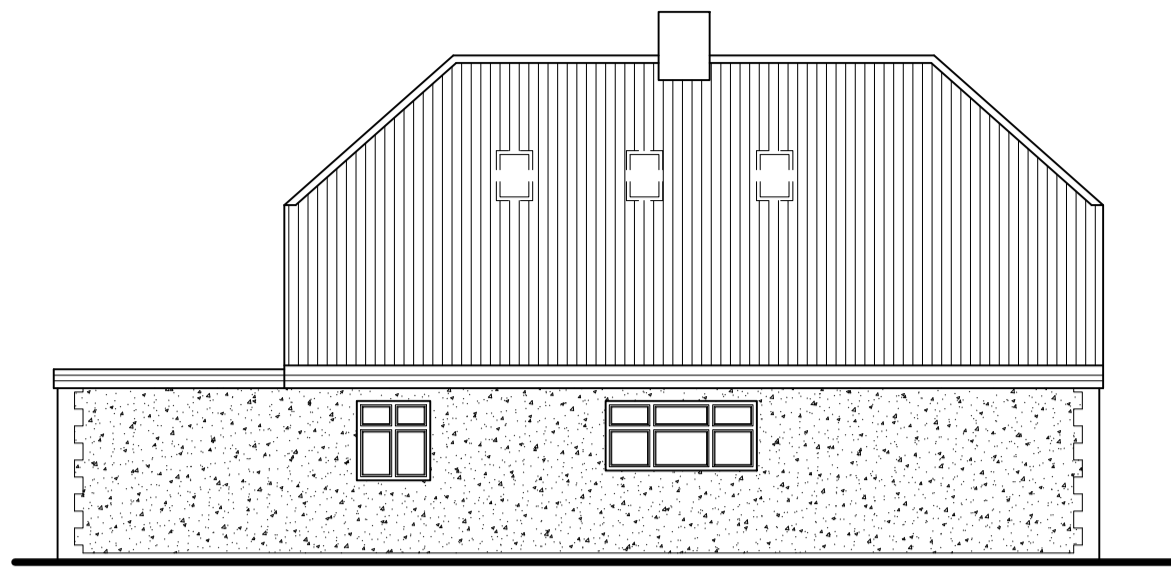


Existing Side Elevation




As Built Rear Elevation -1:100 A1

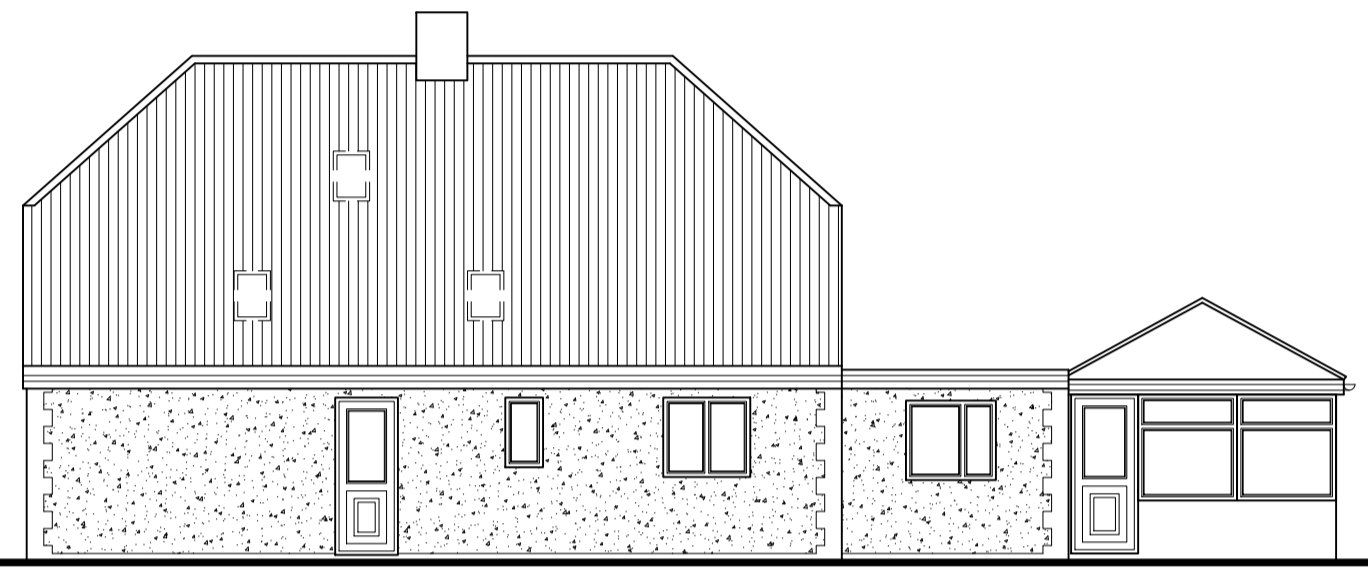


As Built Side Elevation

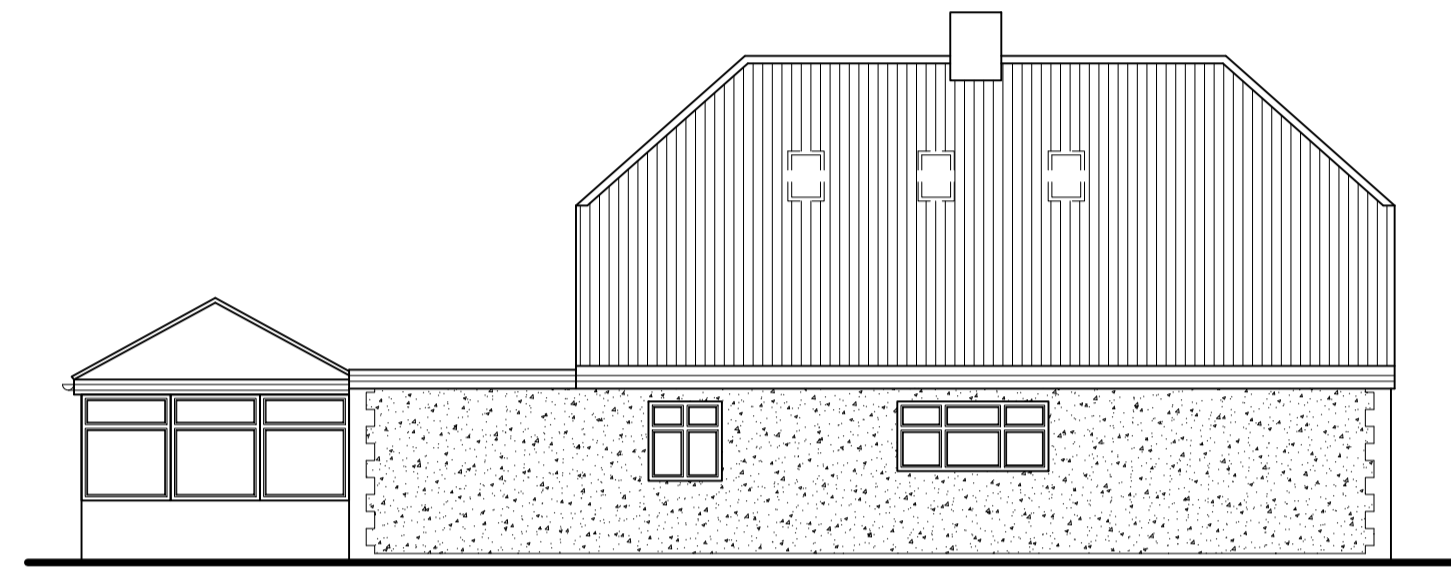

As Built Side Elevation

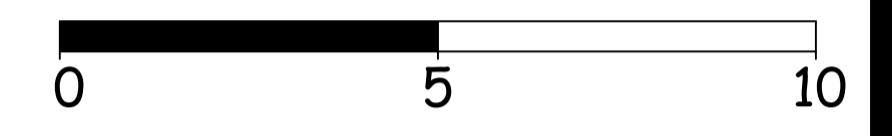

Scale Bar - 1:100

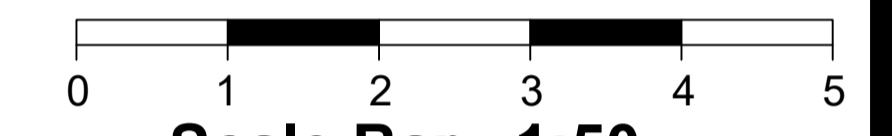

Scale Bar - 1:50



195 Holderness Road, Hull, HU8 8TA
Tel: 01482 707499 Mob: 07402 070779


CLIENT
Mrs D Brett
3 Mill Walk
Cottingham
HU16 4RP

JOB TITLE
Proposed Retrospective
Application For Conservatory


DWG. TITLE
Existing & As Built Ground Floor
Plans and Elevations

SCALE		DRN	
1:50 1:100		TP	
DATE	ALTERATION	BY	REV

DWG. NUMBER	DATE	REV
N2762-24-01	Jan 24	-

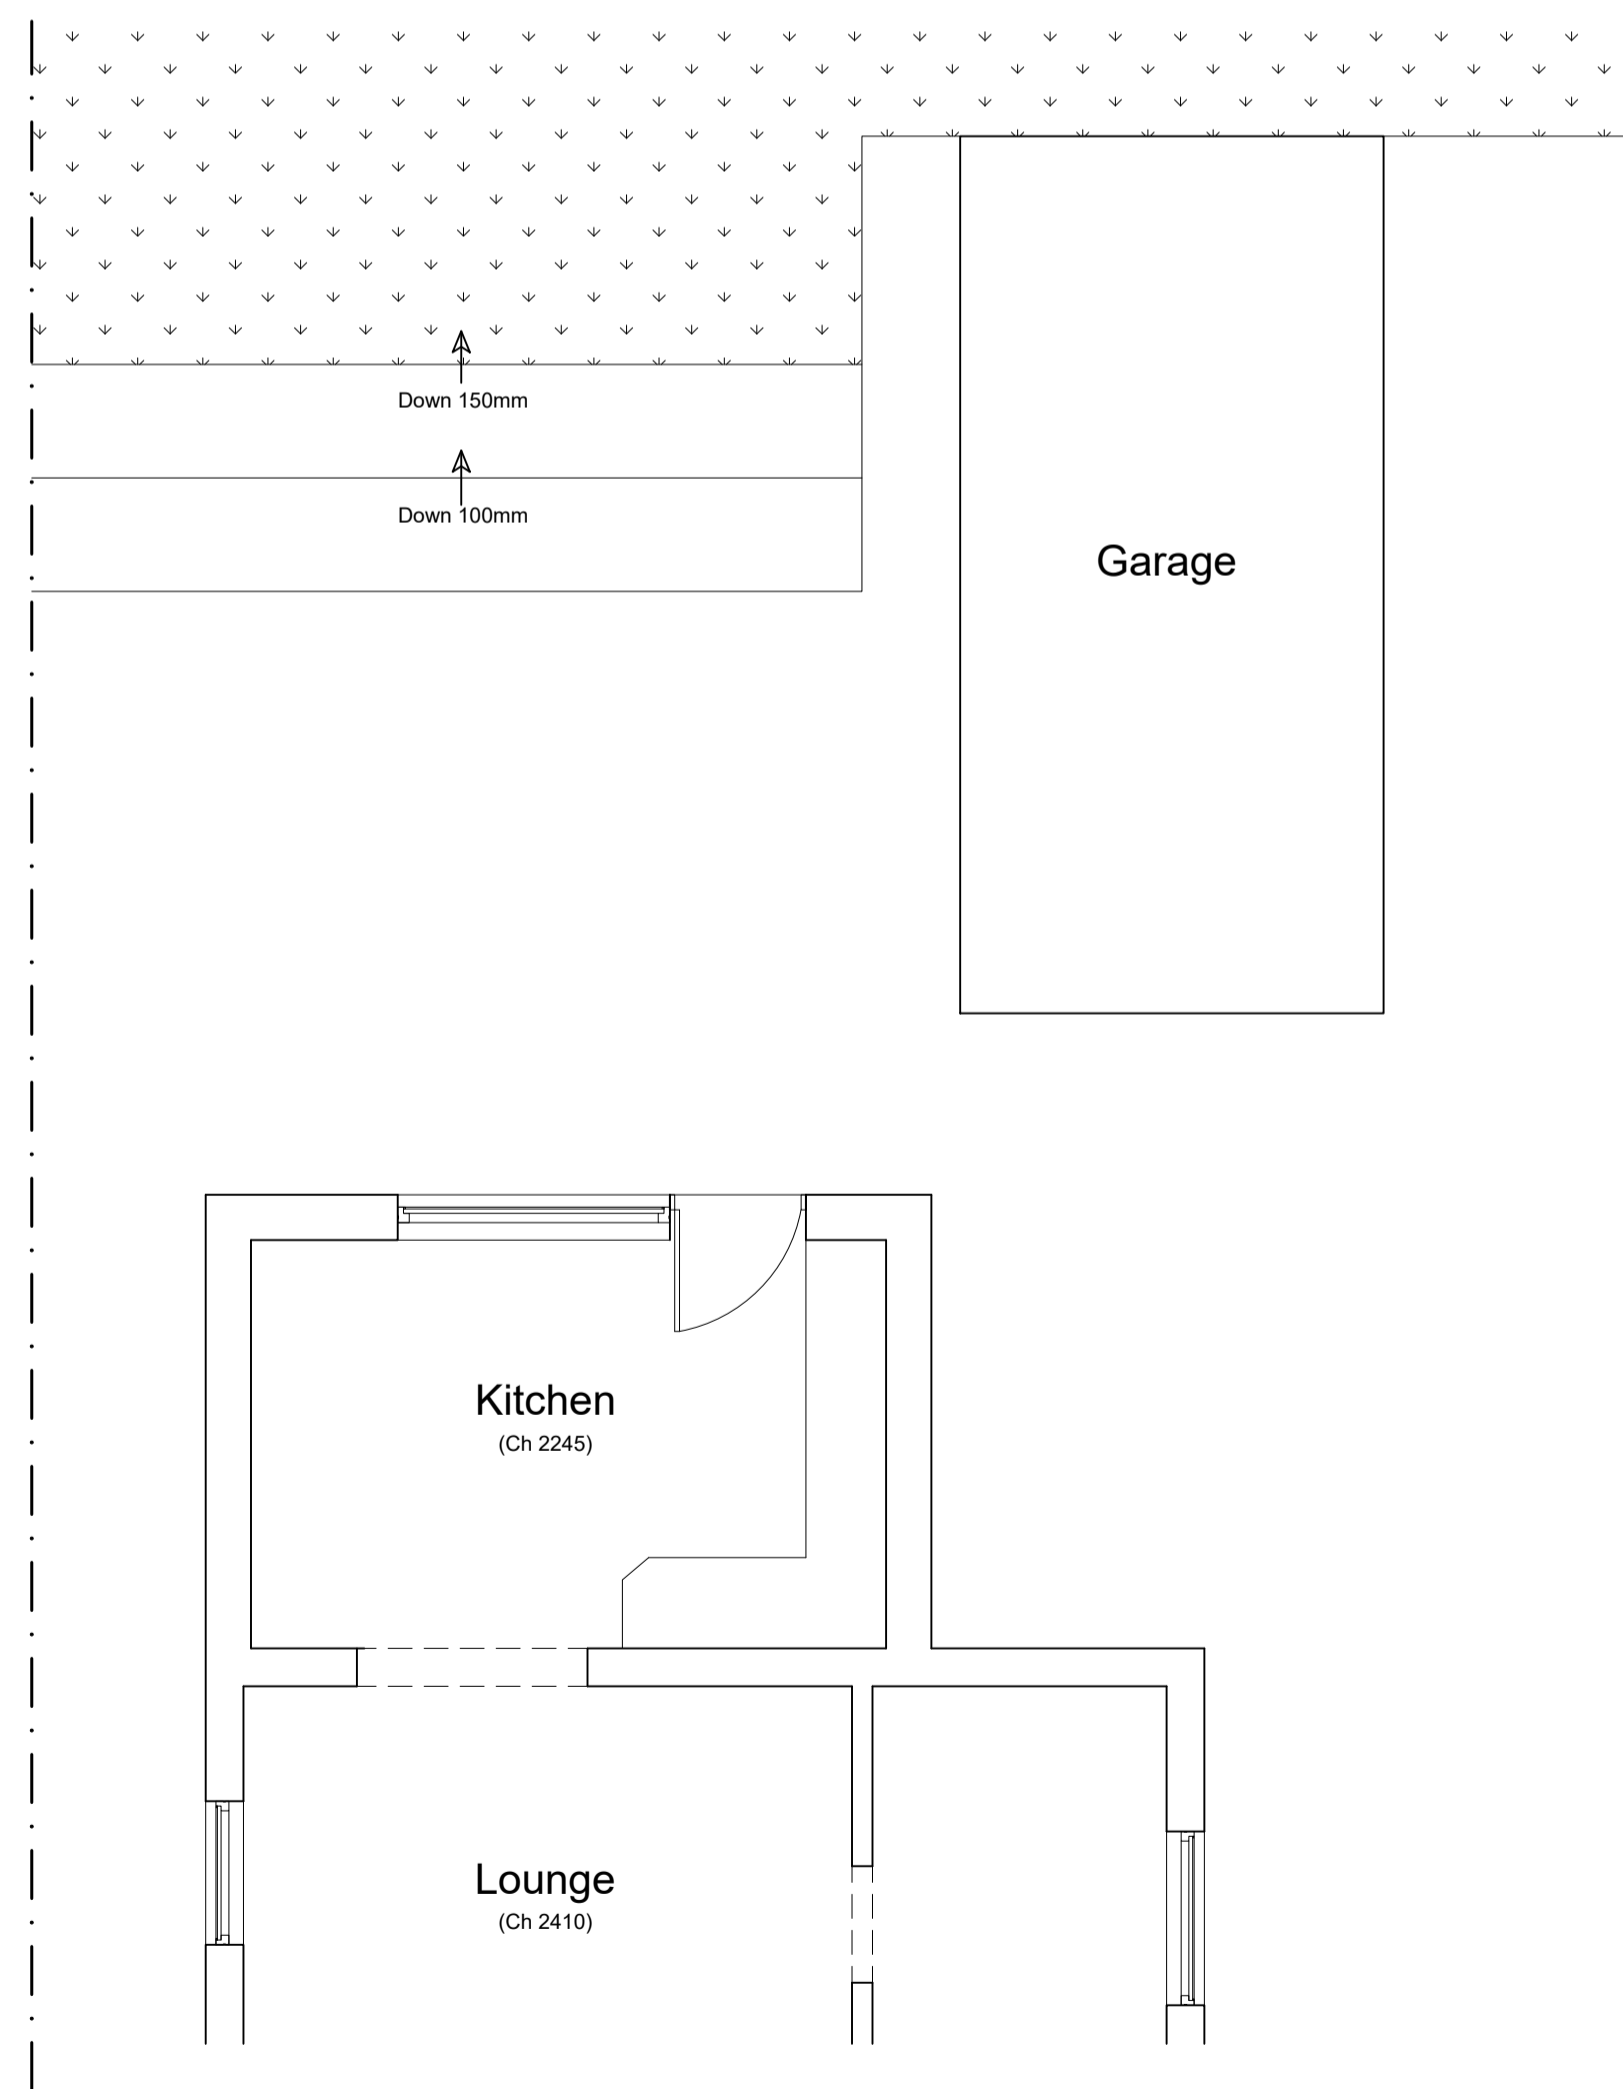

Existing Ground Floor Plan -1:50 A1

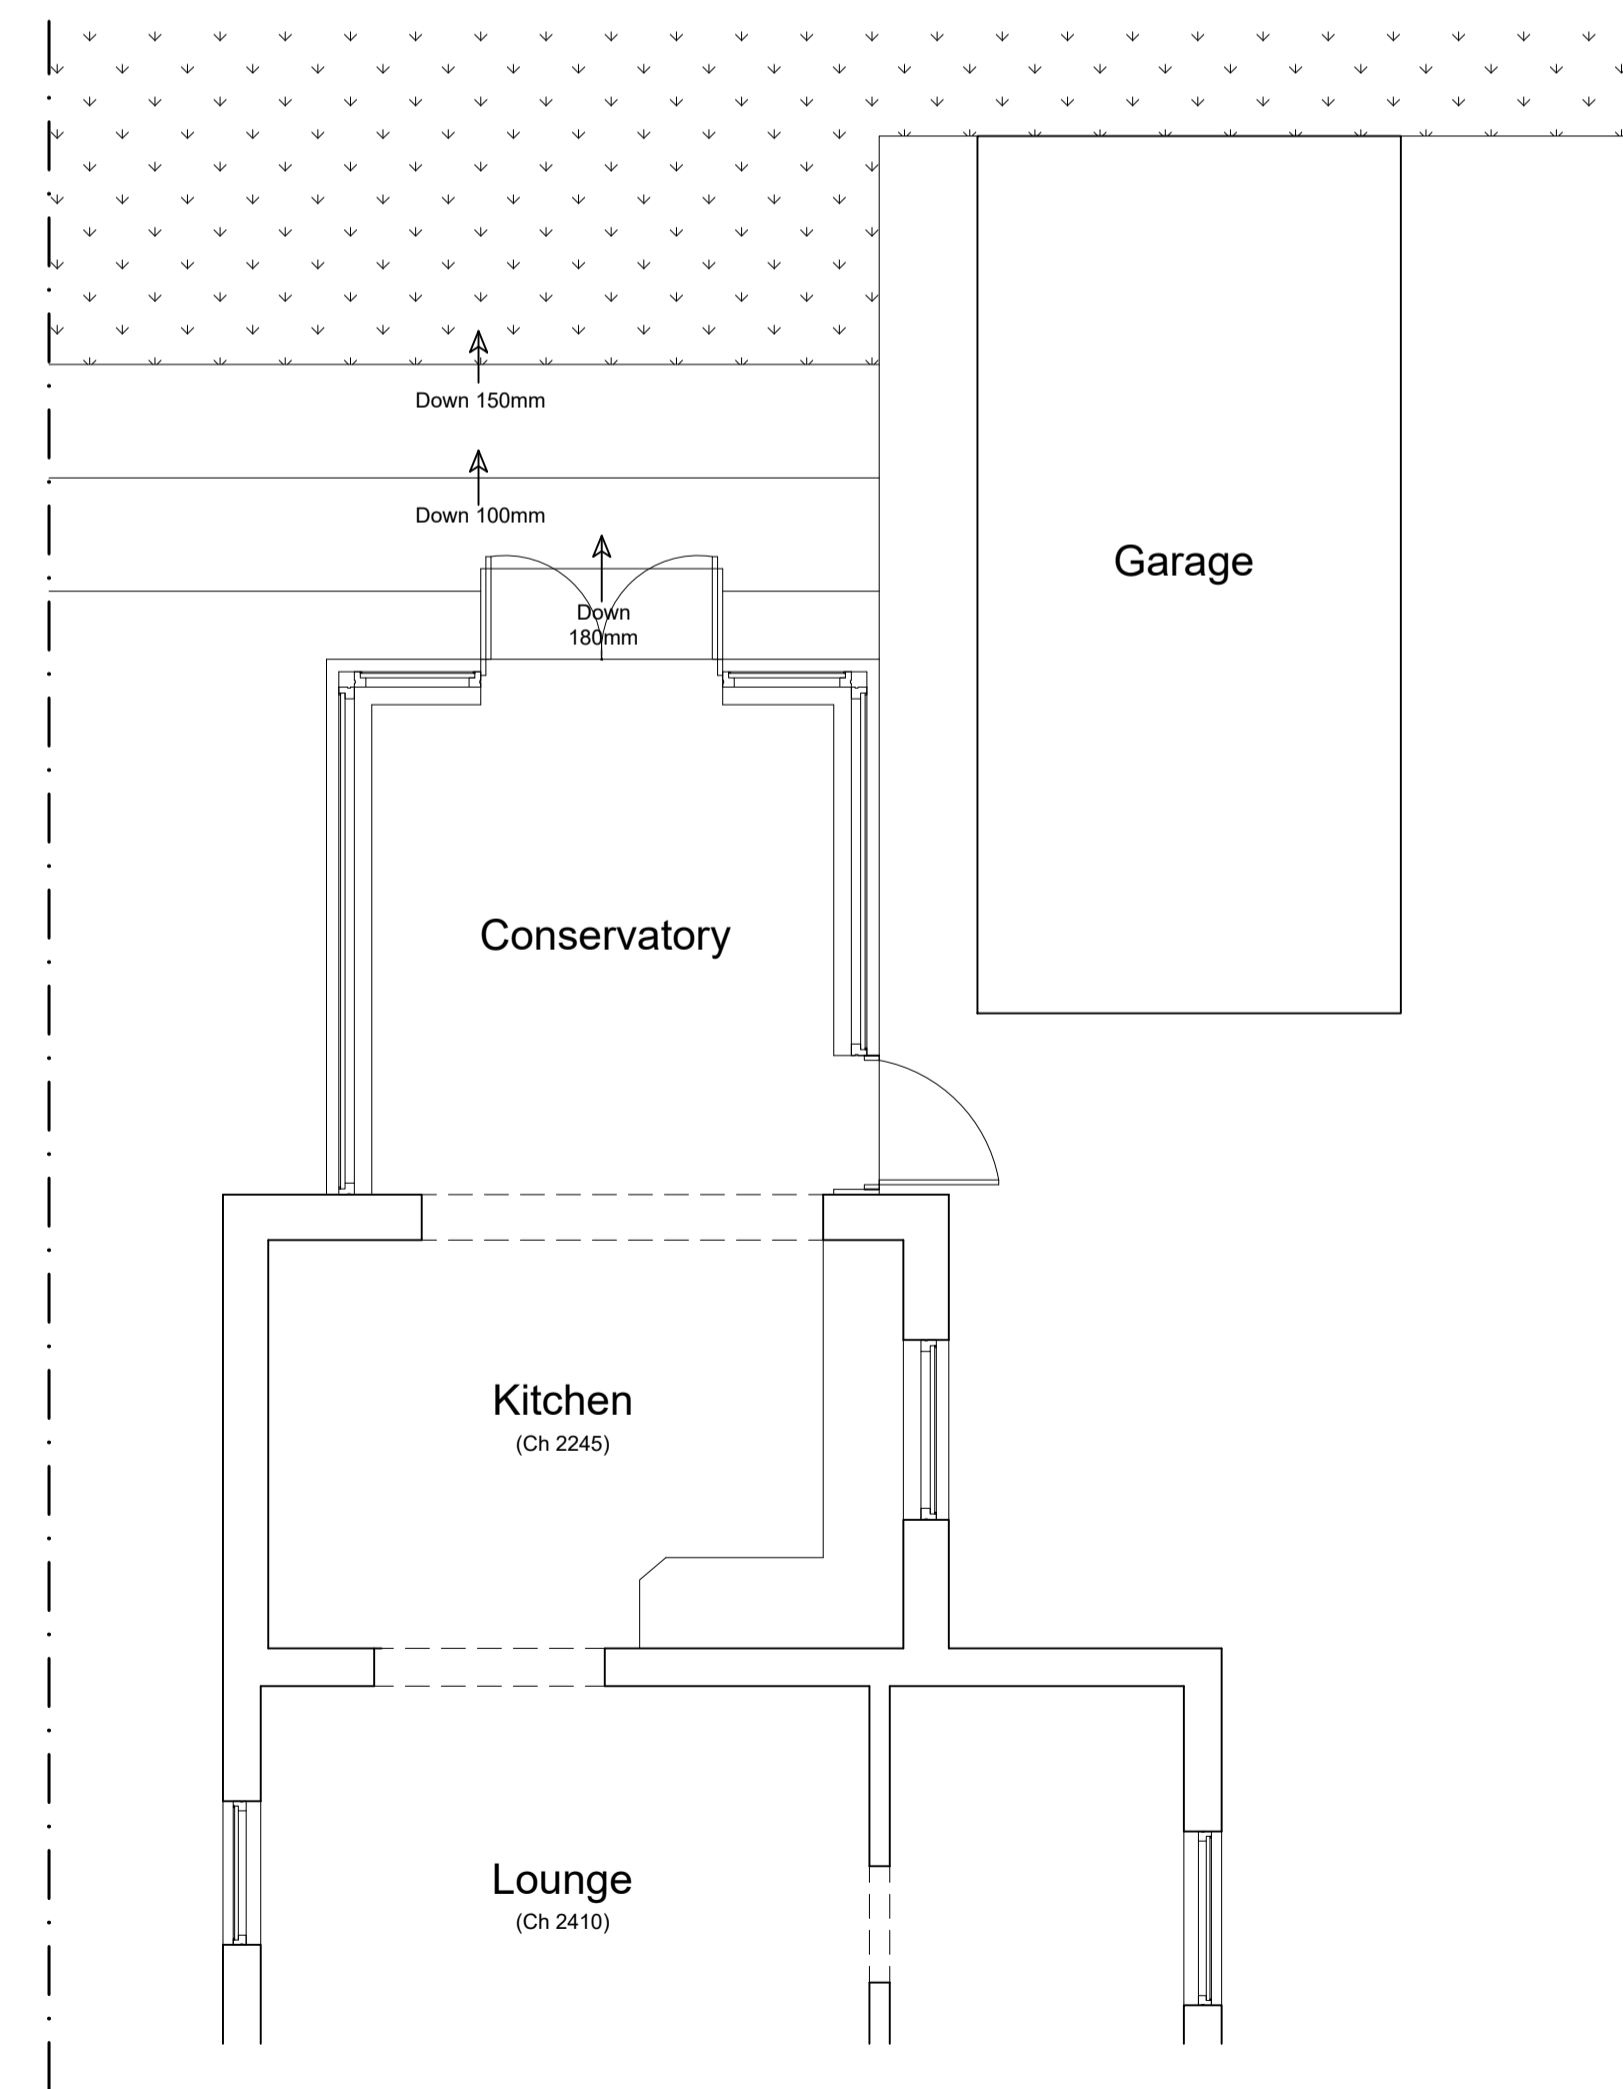

As Built Ground Floor Plan -1:50 A1