

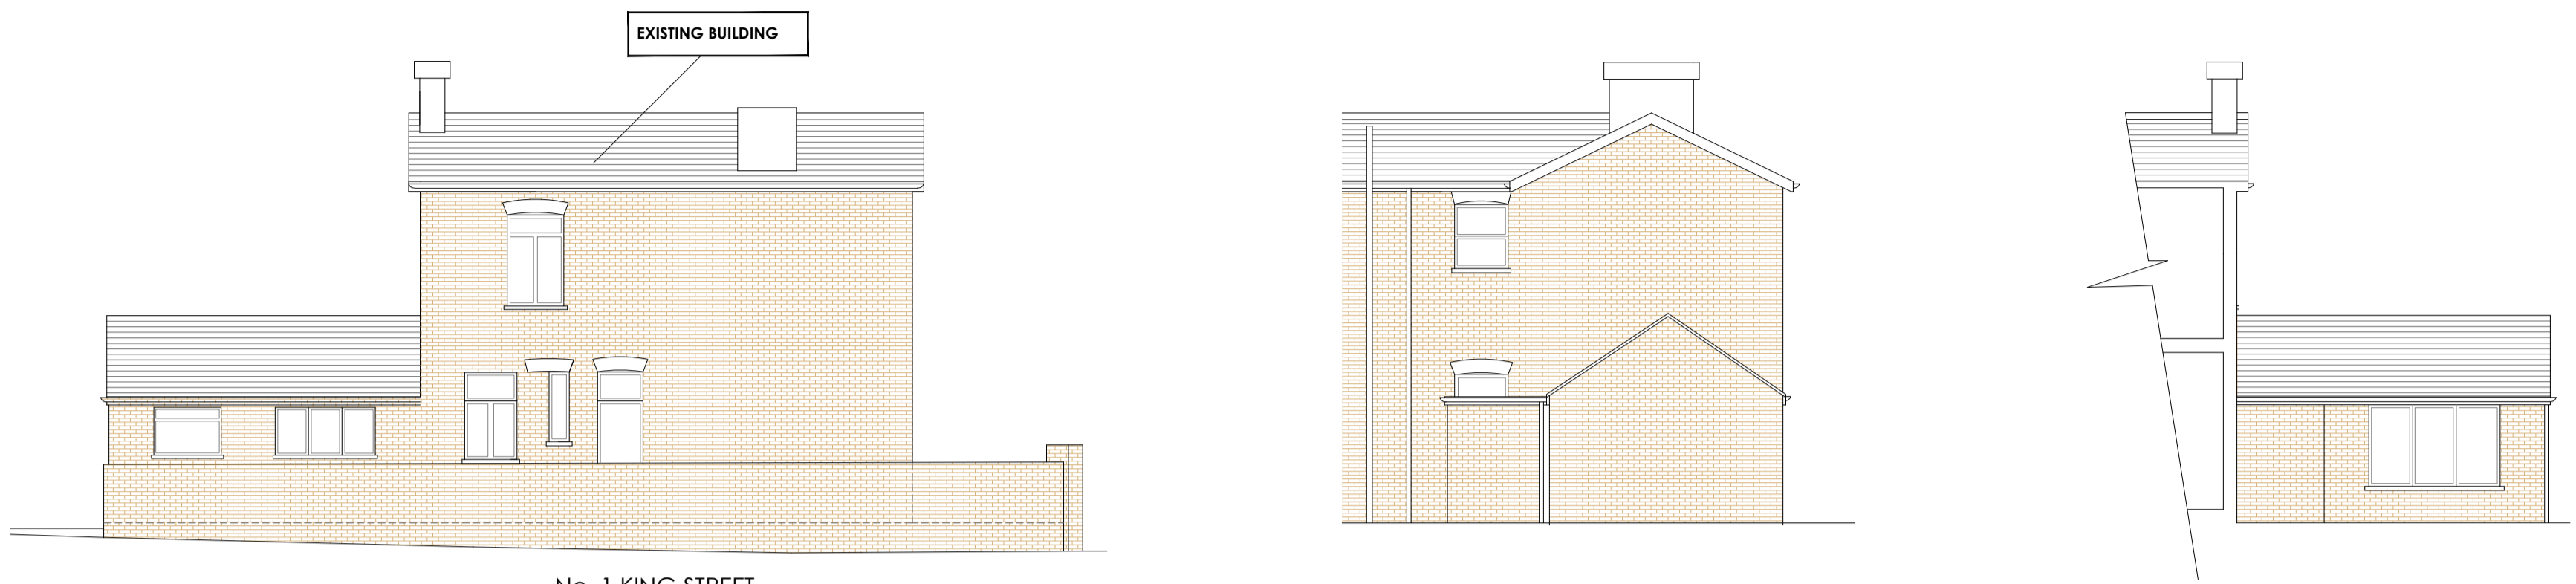


NOTES
 THIS DRAWING IS THE SUBJECT OF
 COPYRIGHT AND DESIGN RIGHTS
 AND SHALL NOT BE REPRODUCED,
 LOANED, COPIED OR SUBMITTED
 TO ANY OTHER PARTY WITHOUT
 CONSENT.

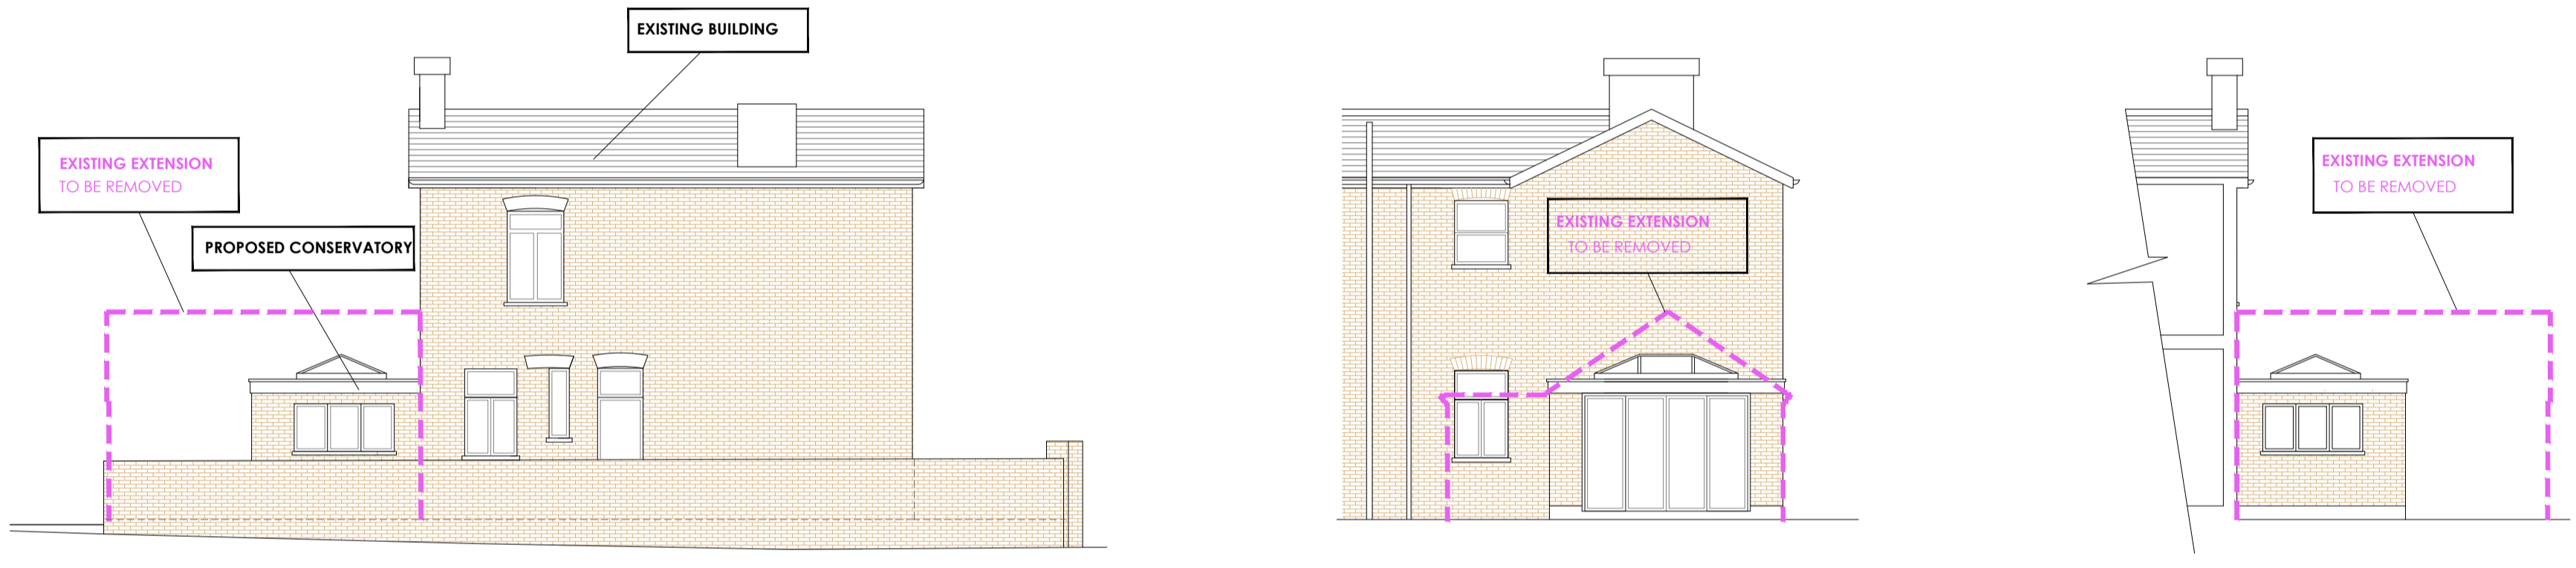



No. 1 KING STREET

PRE-EXISTING ELEVATIONS OF EXISTING HOUSE

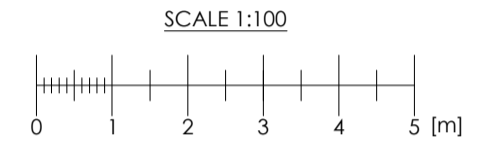


No. 1 KING STREET

APPROVED ELEVATIONS OF EXISTING HOUSE
APP/N5090/A/13/2200572

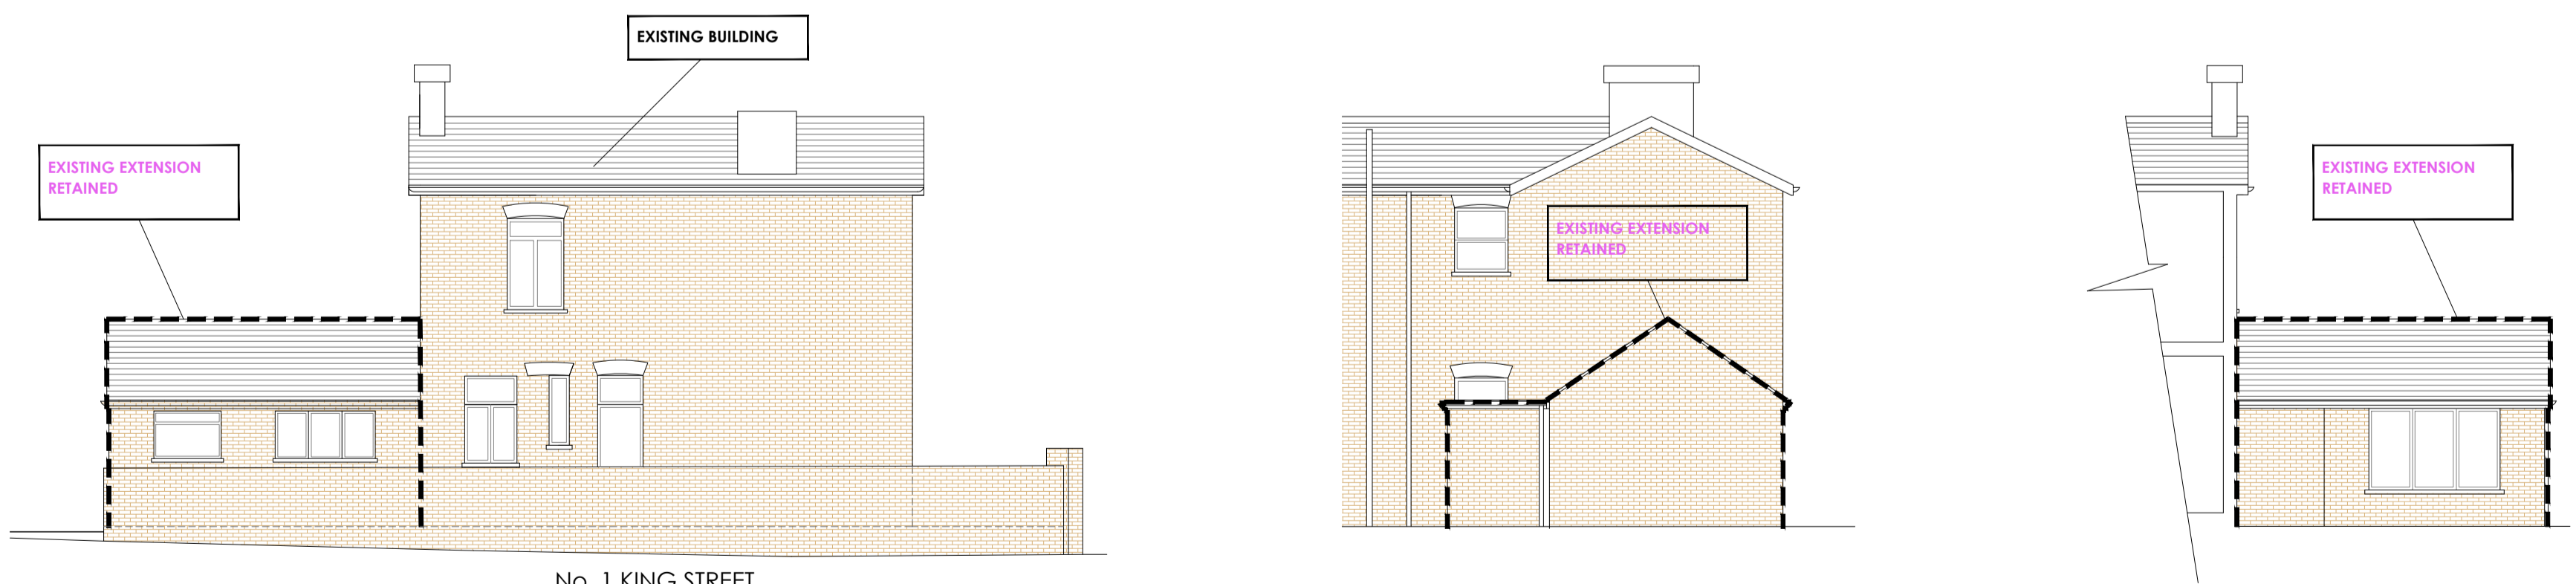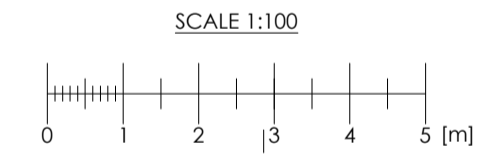

No. 1 KING STREET

AS-BUILT - ELEVATIONS OF EXISTING HOUSE

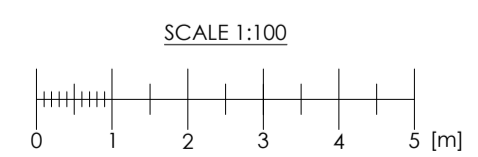

NO.	DR.	INFO
DATE		
REVISION		
PROJECT	1 KING STREET EAST FINCHLEY, LONDON N2	
CLIENT		
DRAWING TITLE	PRE-EXISTING, APPROVED, AS-BUILT ELEVATIONS OF EXISTING HOUSE	
SCALE	1:50	1:100
SIZE	A1	A3
JOB NO.	202389	
STAGE	BR	
DWG NO.	202389.BR.103	
REVISION		
DATE	SEPTEMBER 2023	
DRAWN	MB	
CHECKED	MB	