

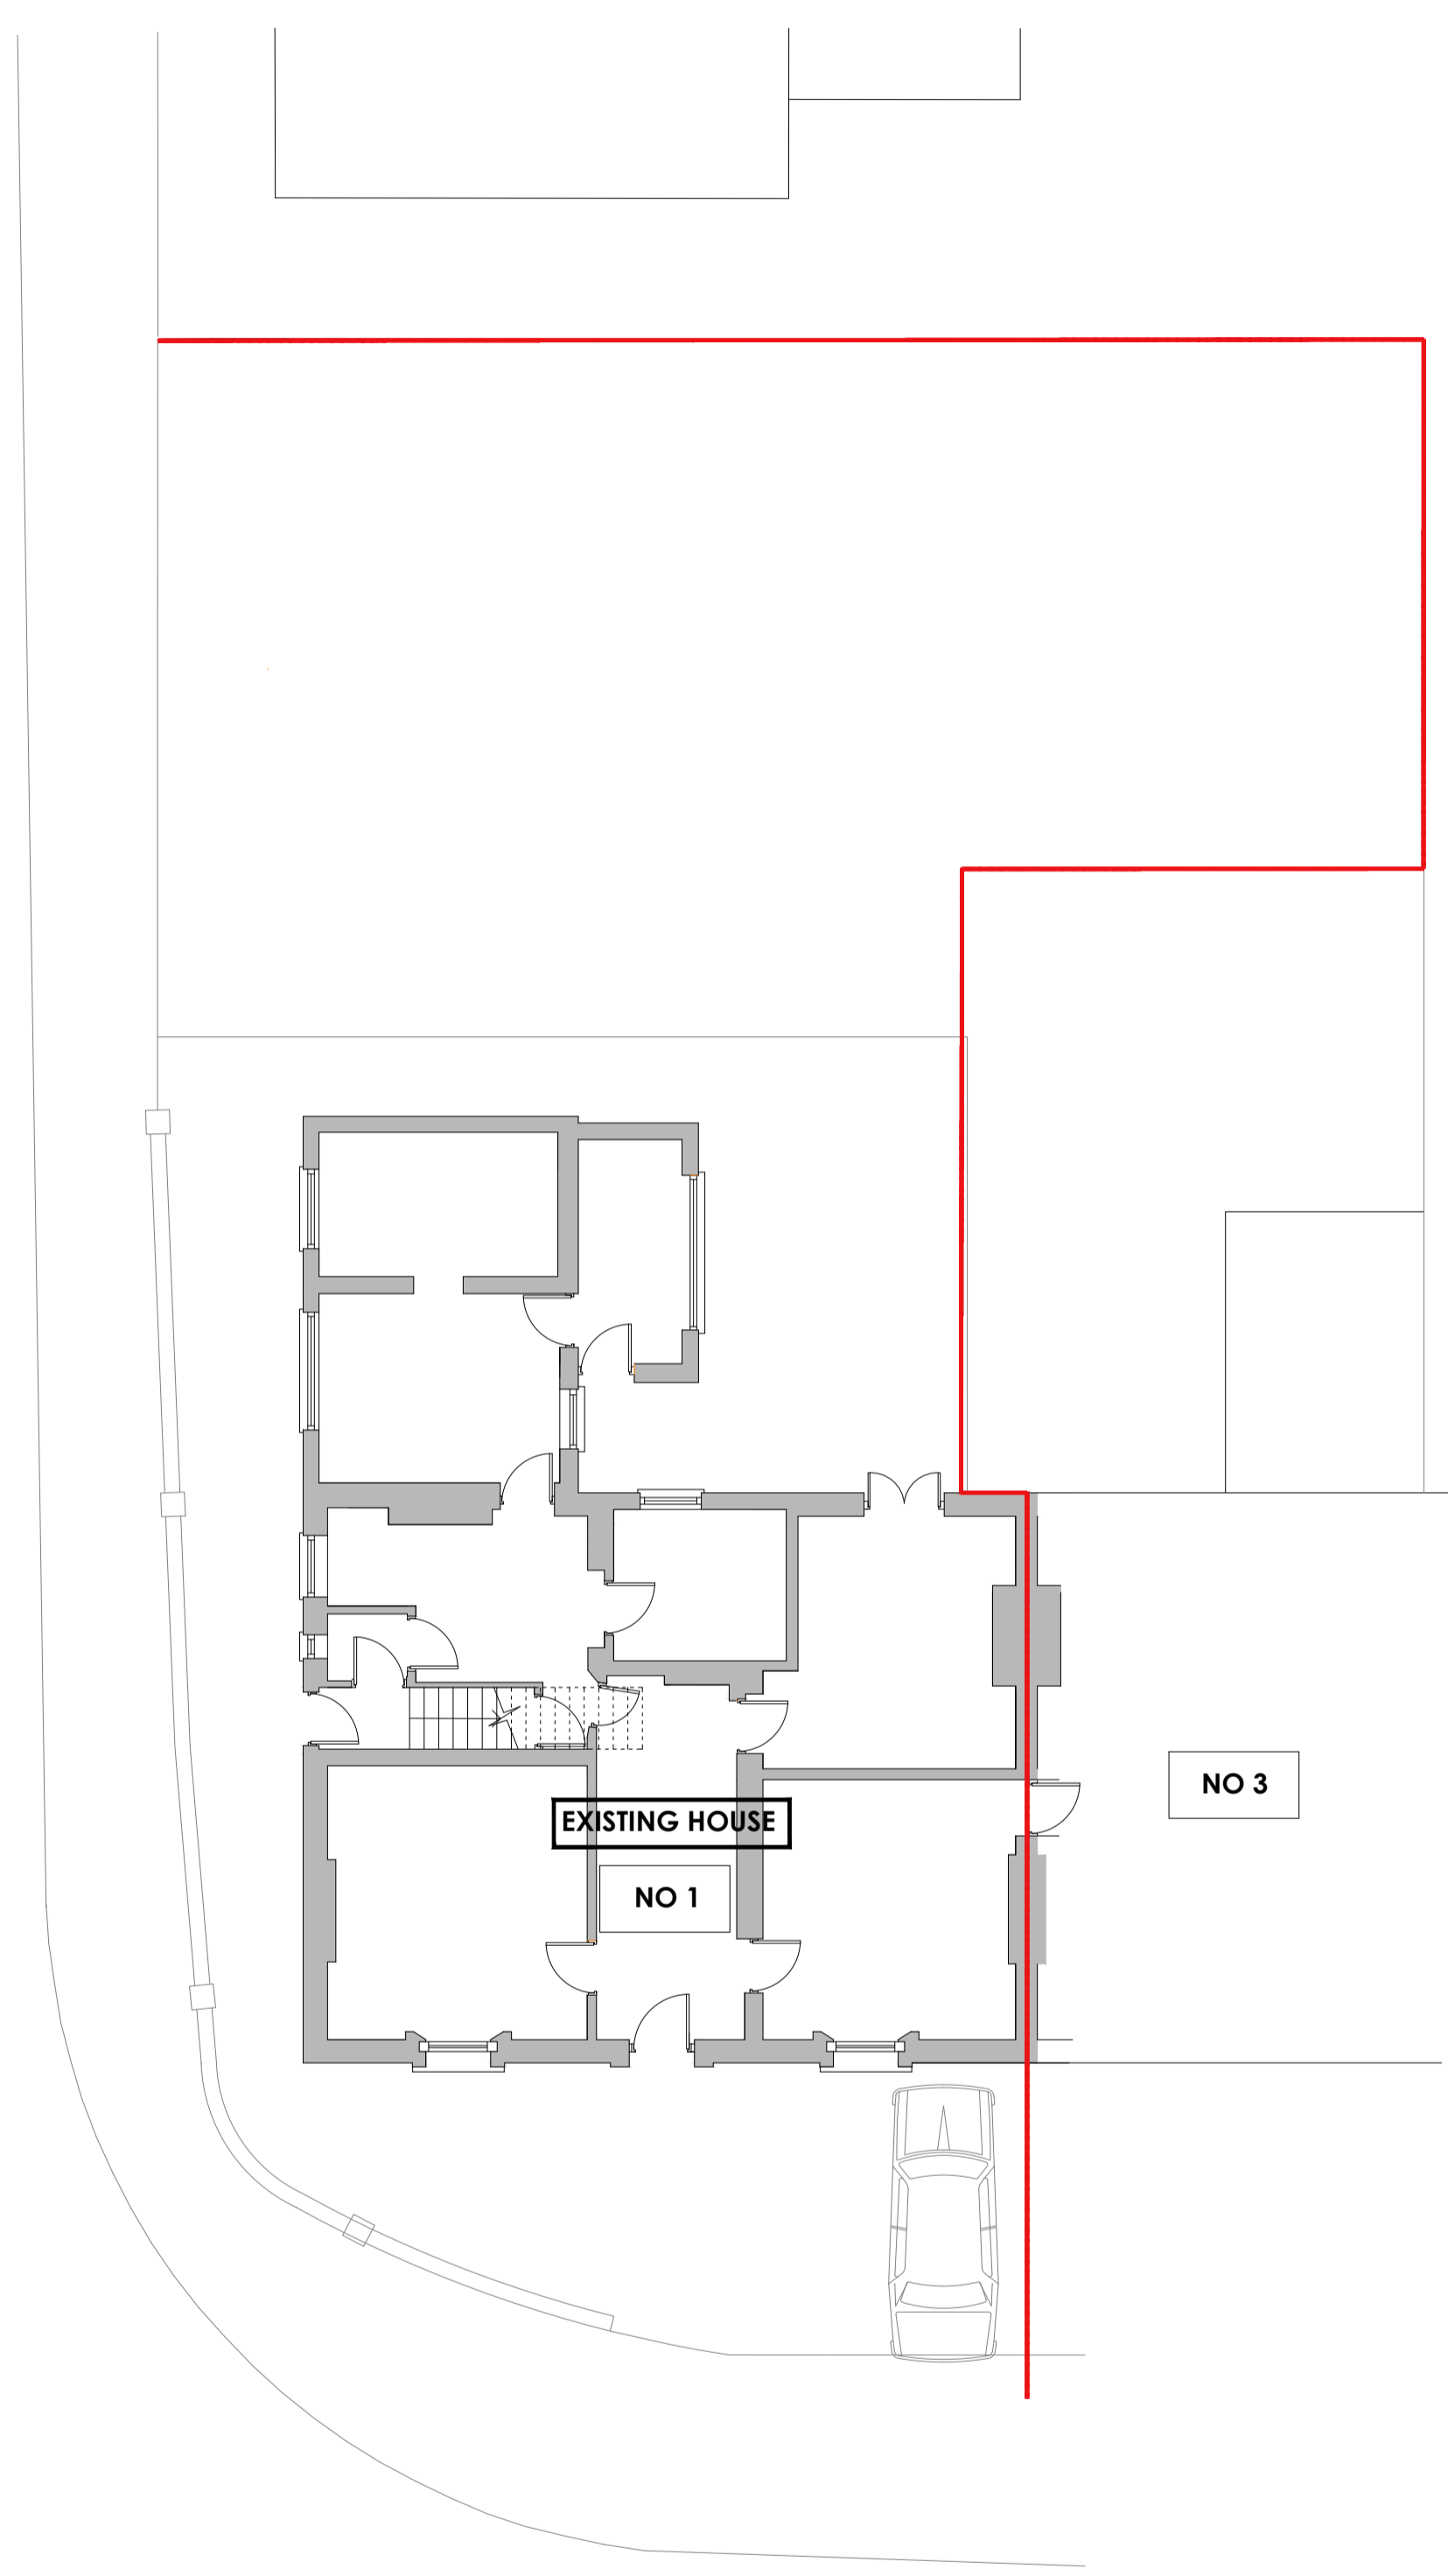




**NOTES**  
 THIS DRAWING IS THE SUBJECT OF  
 COPYRIGHT AND DESIGN RIGHTS  
 AND SHALL NOT BE REPRODUCED,  
 LOANED, COPIED OR SUBMITTED  
 TO ANY OTHER PARTY WITHOUT  
 CONSENT.

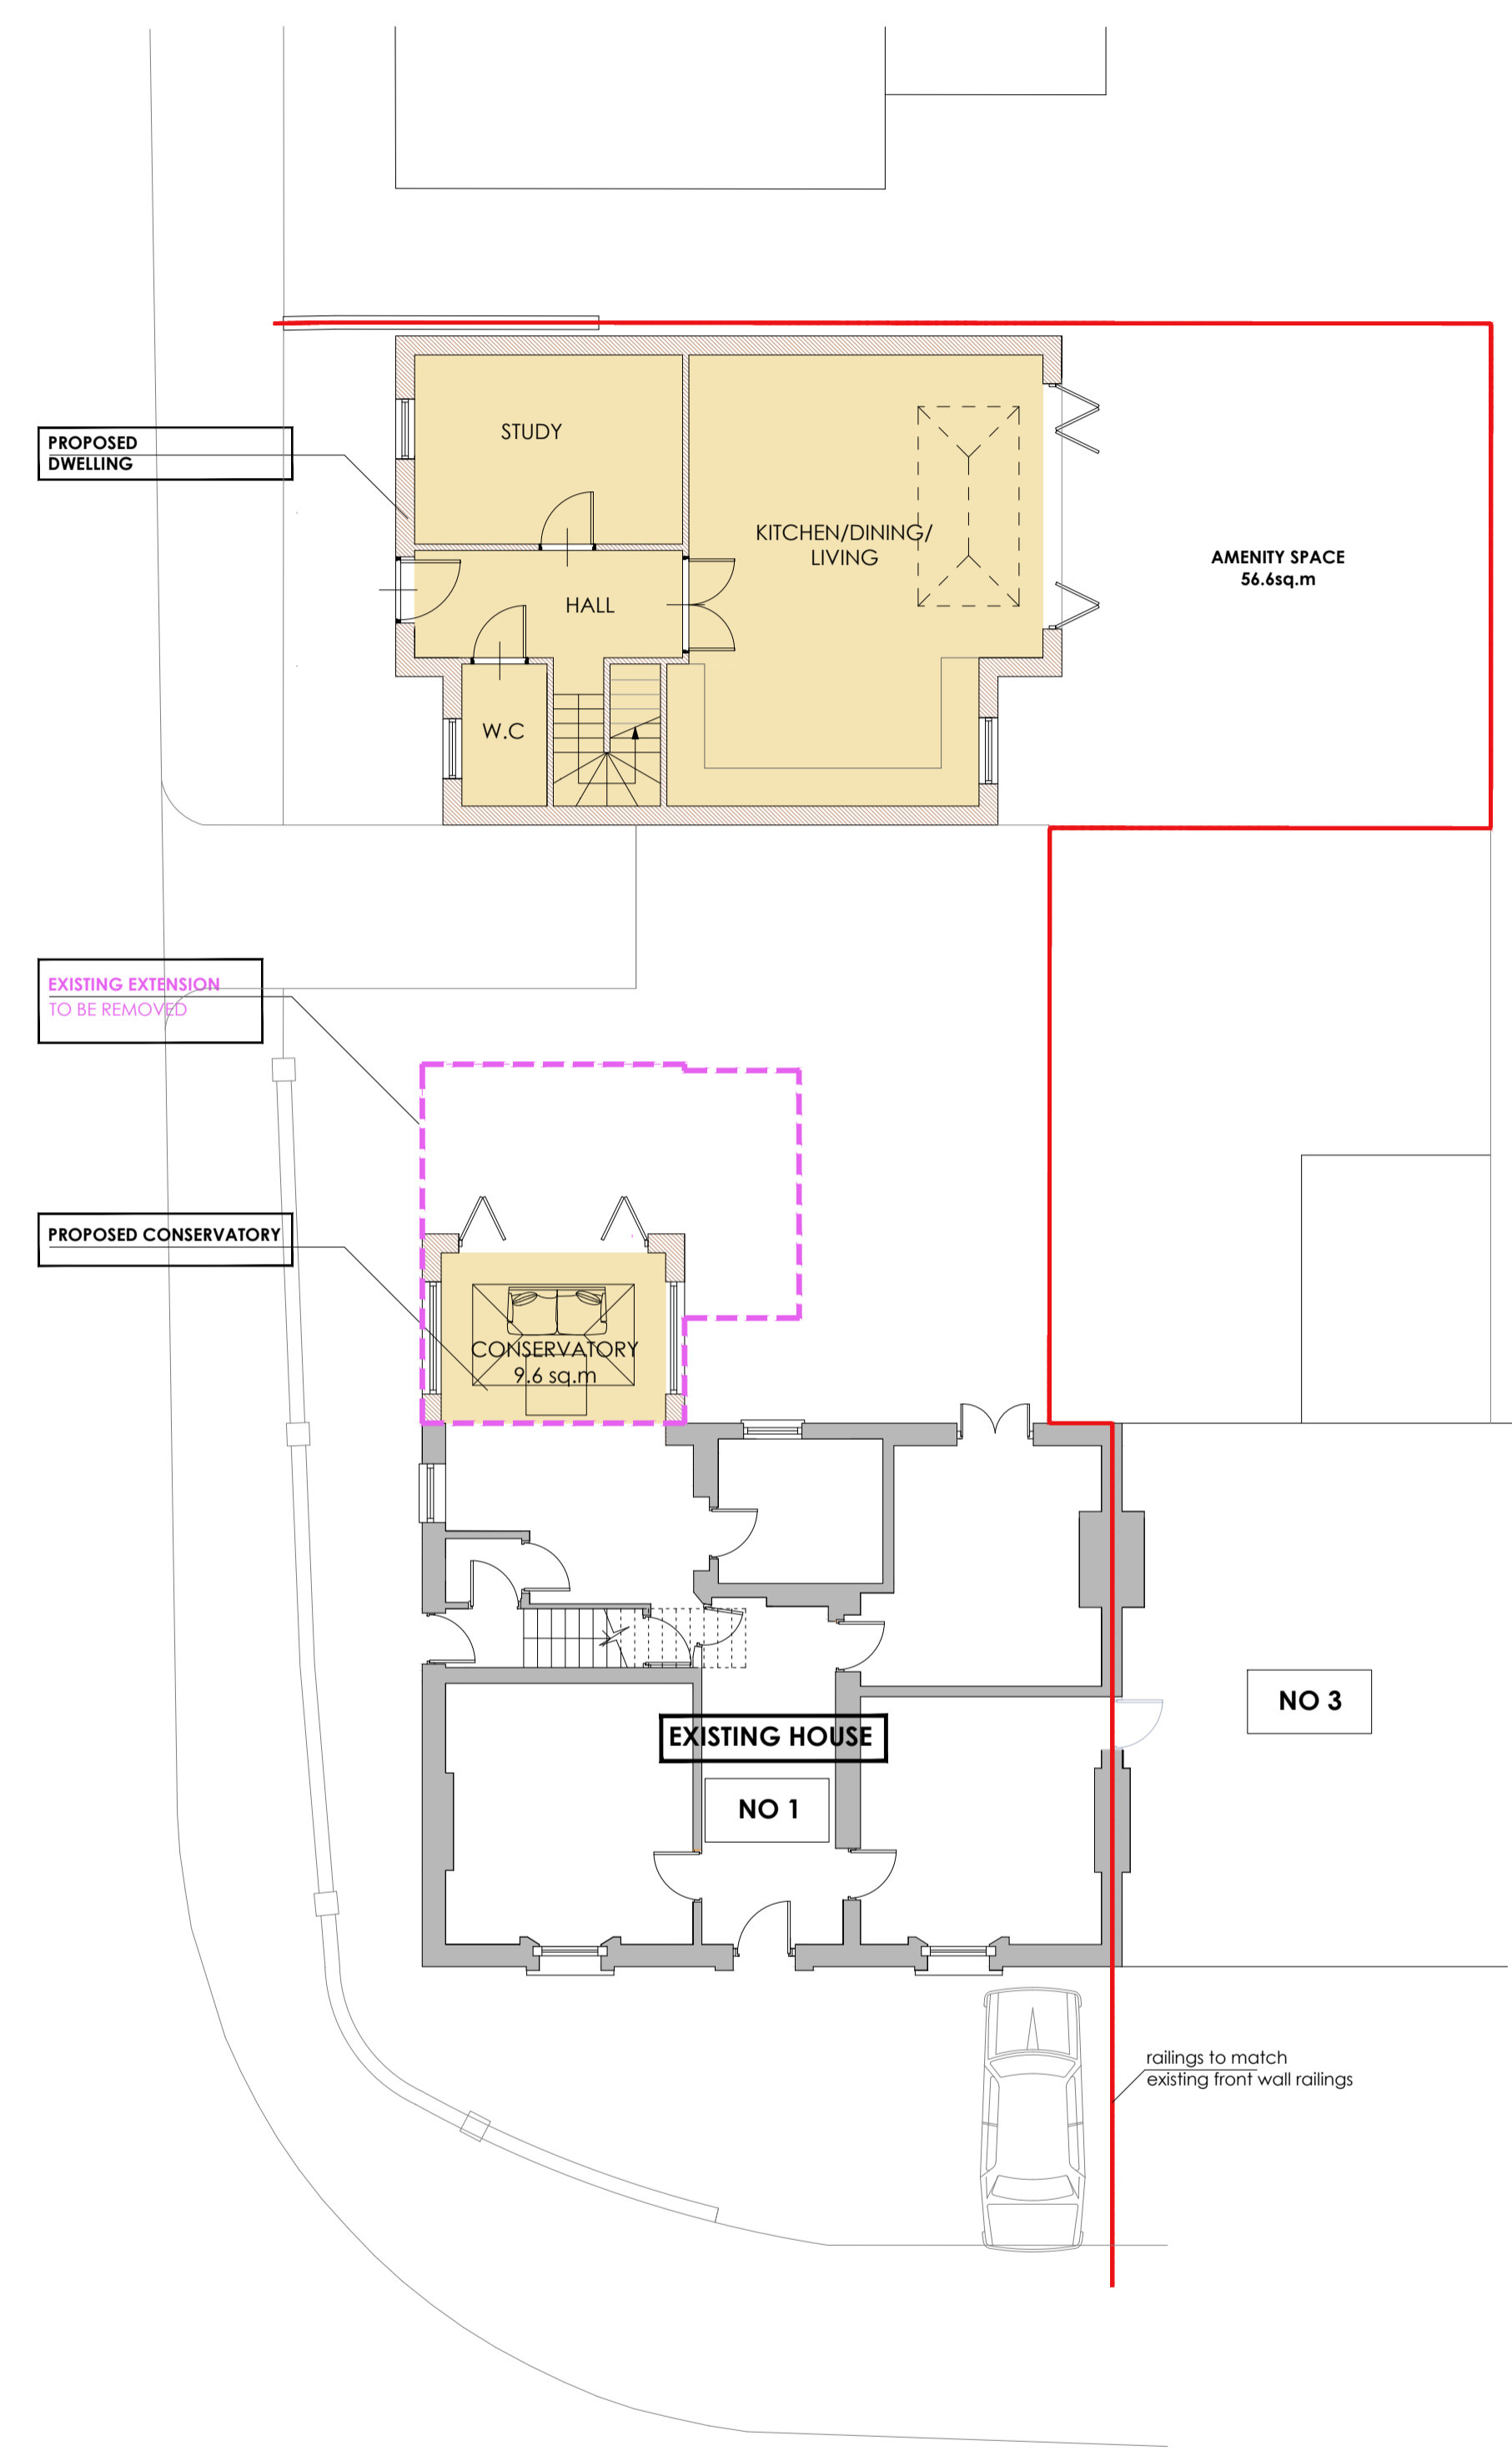


**PRE EXISTING GROUND FLOOR / SITE PLAN**

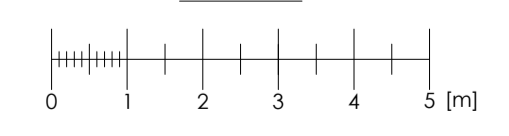

**APPROVED GROUND FLOOR / SITE PLAN**  
**APP/N5090/A/13/2200572**

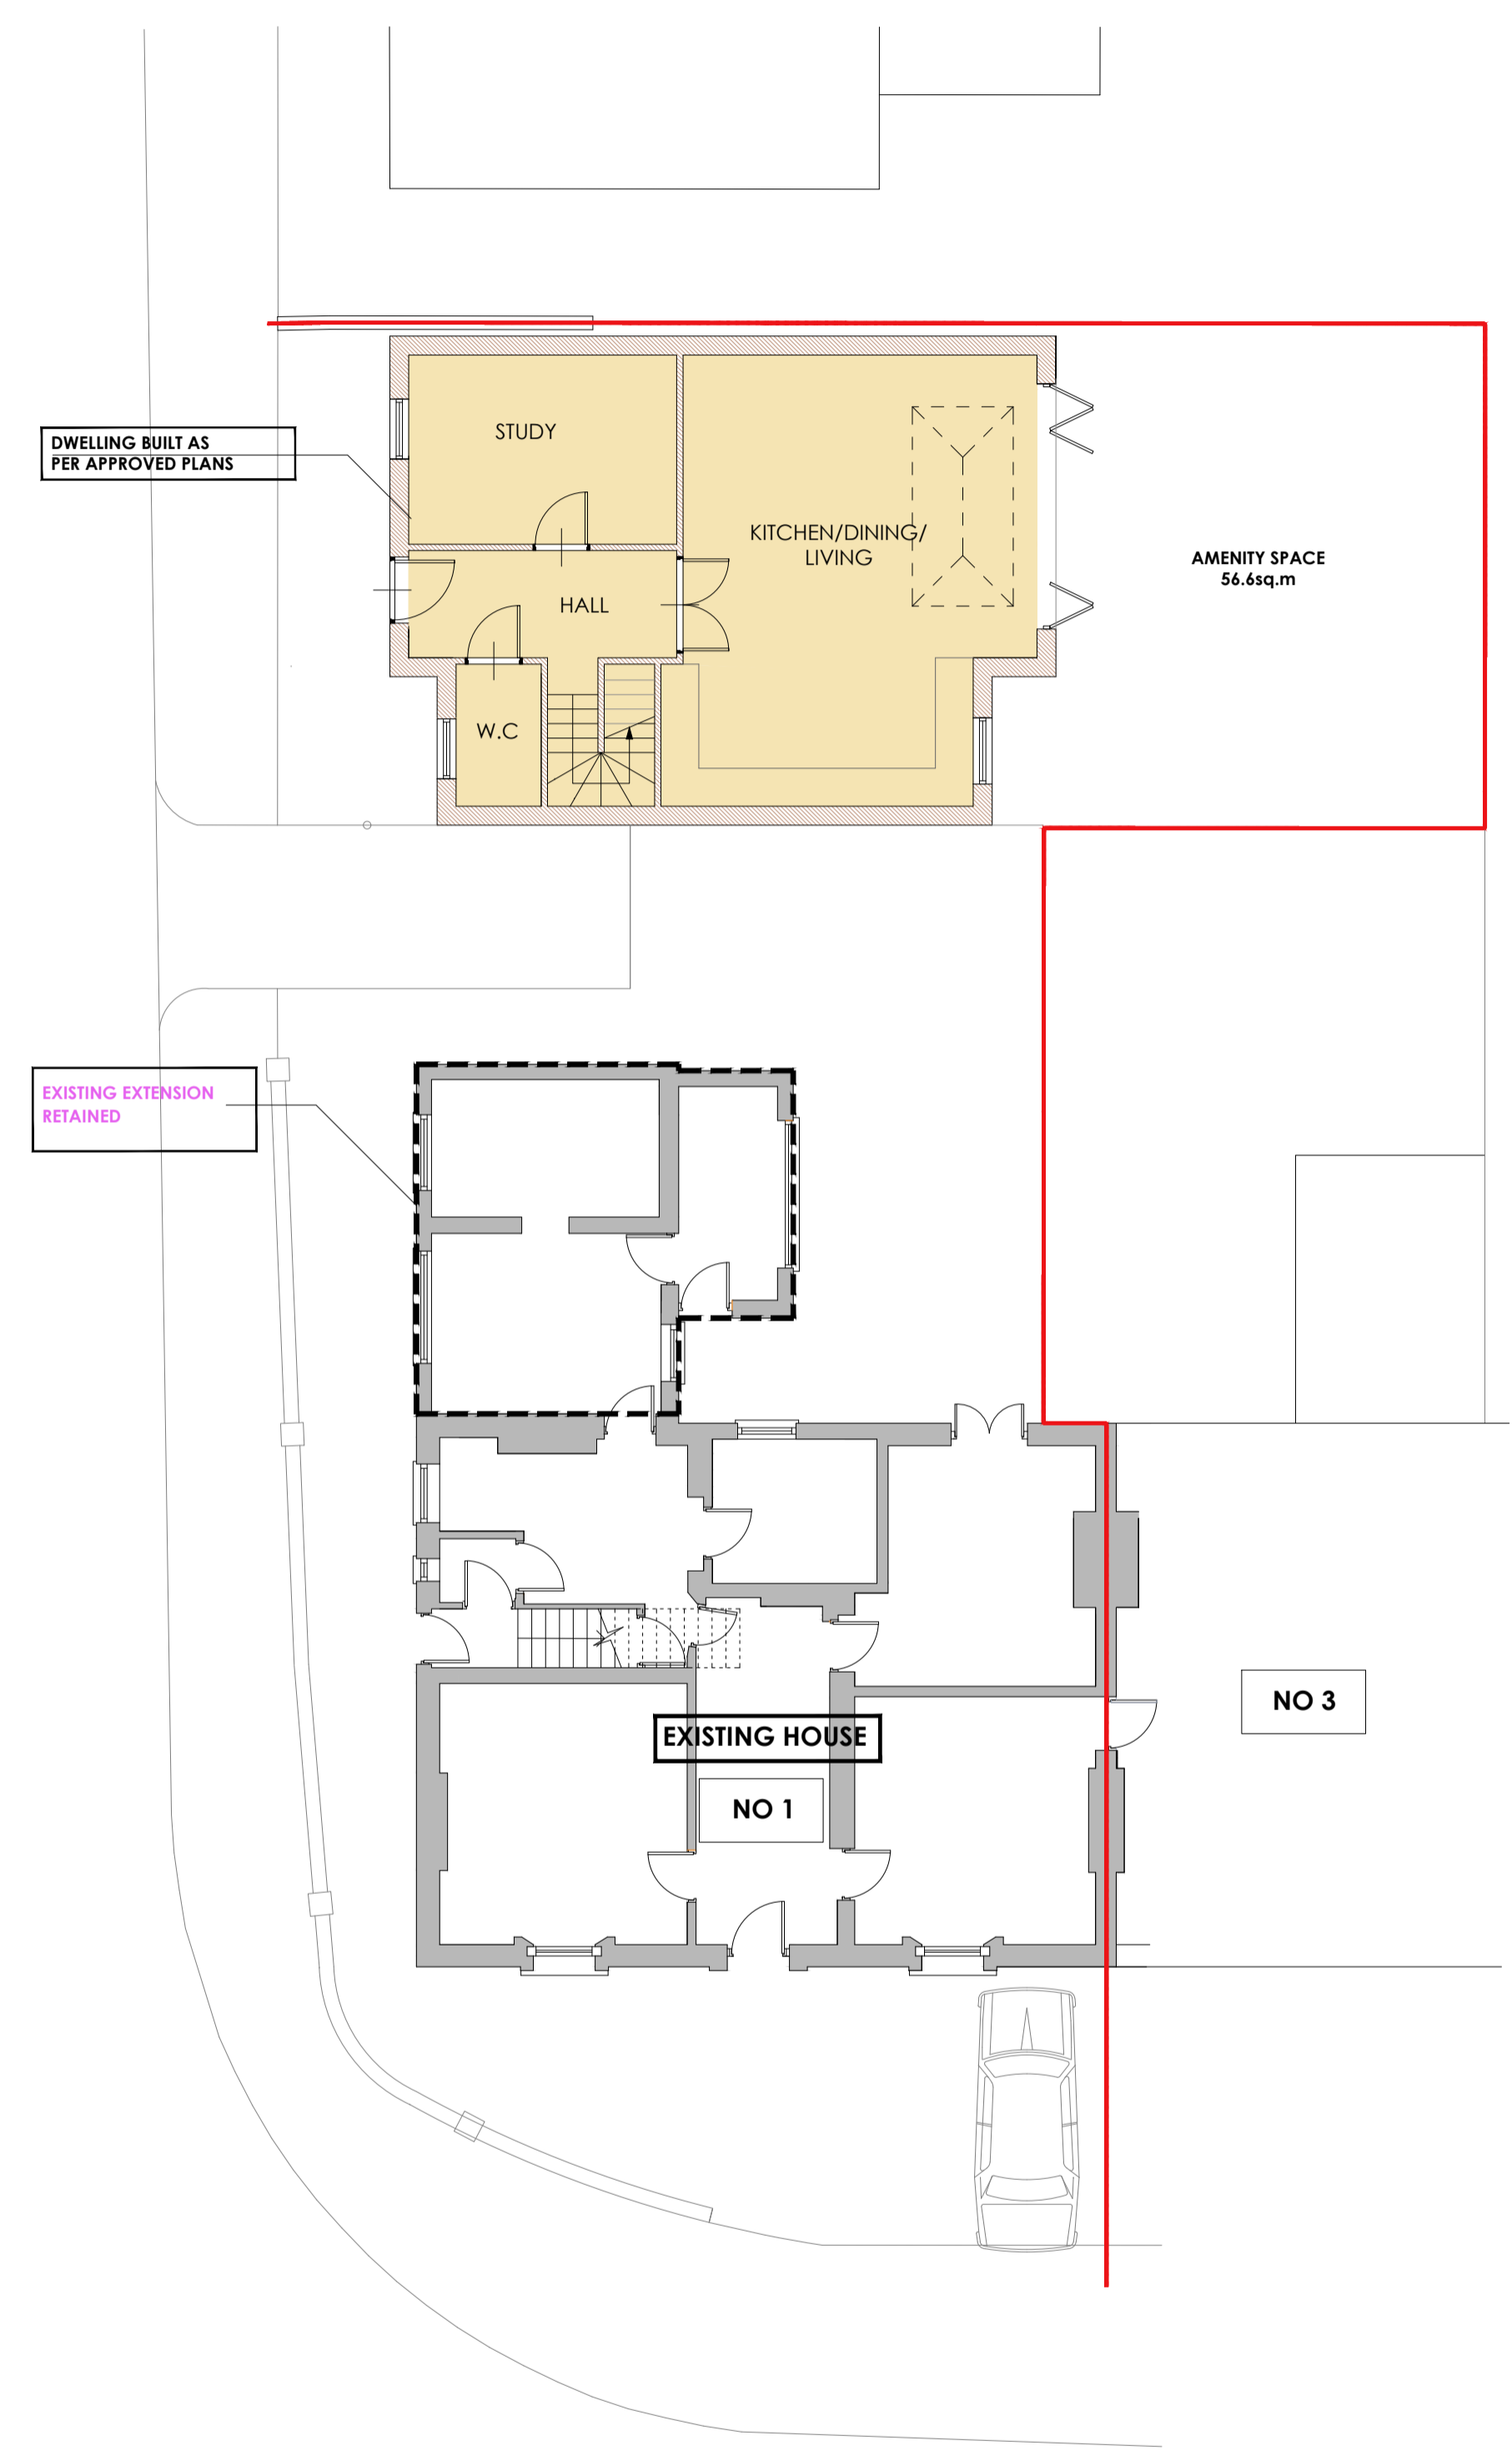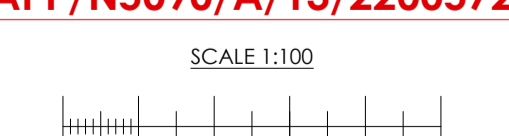

**AS BUILT- GROUND FLOOR / SITE PLAN**

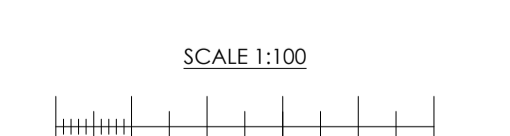

NO.	DR.	INFO
DATE		
<b>REVISION</b>		
<b>PROJECT</b>		
1 KING STREET		
EAST FINCHLEY, LONDON N2		
<b>CLIENT</b>		
<b>DRAWING TITLE</b>		
PRE-EXISTING, APPROVED, AS-BUILT		
GROUND FLOOR/ SITE PLAN		
<b>SCALE</b>	1:100	1:200
<b>SIZE</b>	A1	A3
<b>JOB NO.</b>	202389	
<b>STAGE</b>	BR	
<b>DWG NO.</b>	202389.BR.101	
<b>REVISION</b>		
<b>DATE</b>	SEPTEMBER 2023	
<b>DRAWN</b>	MB	
<b>CHECKED</b>	MB	