




## Second Floor Plan - As approved

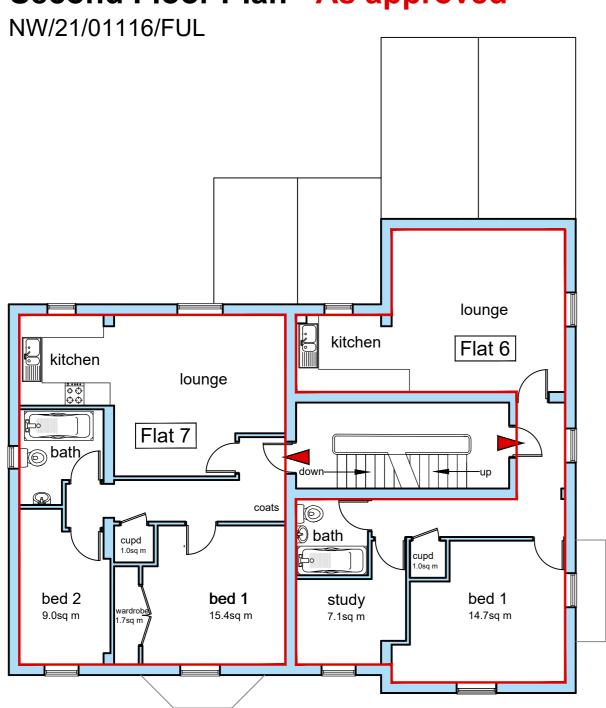


First Floor Plan - As approved

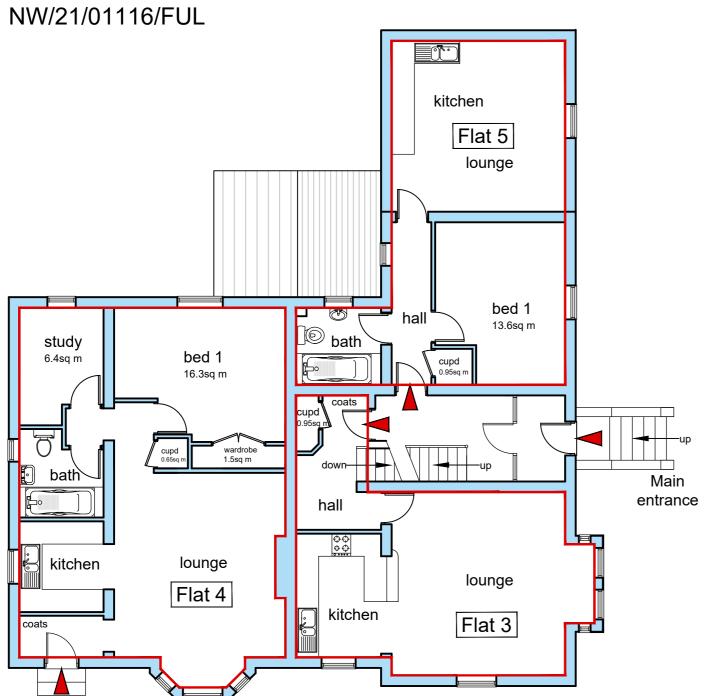


**Ground Floor Plan - As approved** 

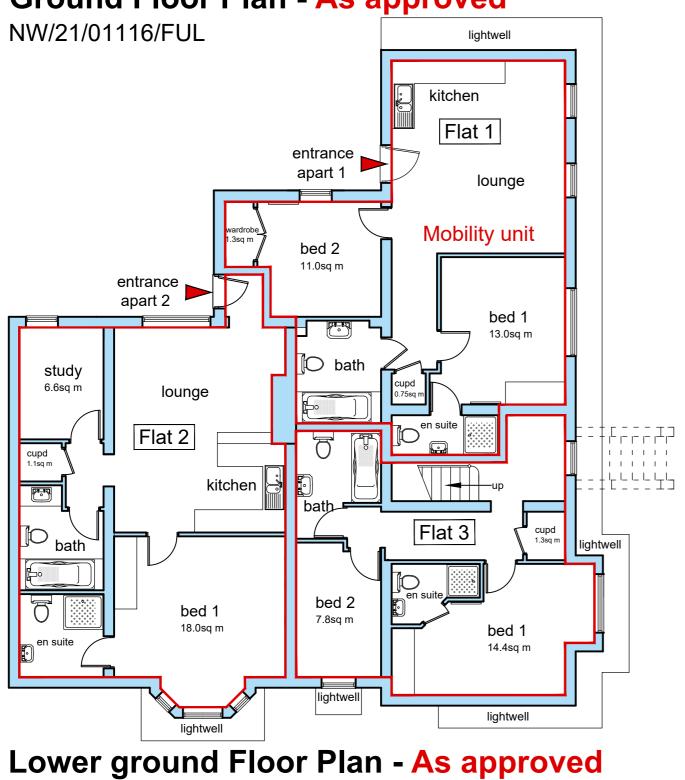


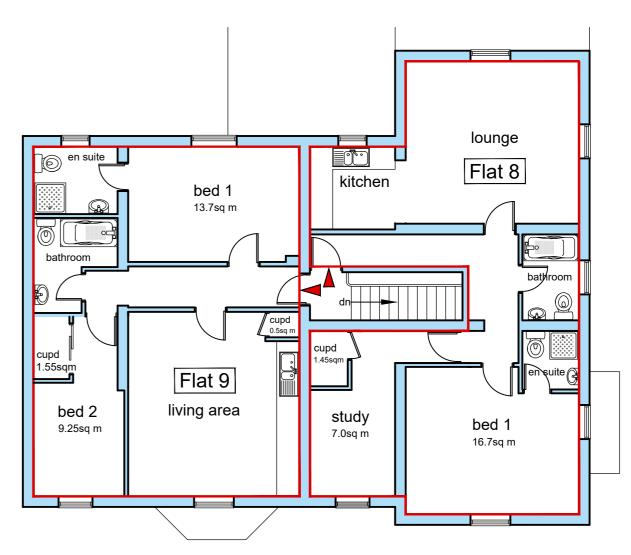


**Second Floor Plan - As Built** 

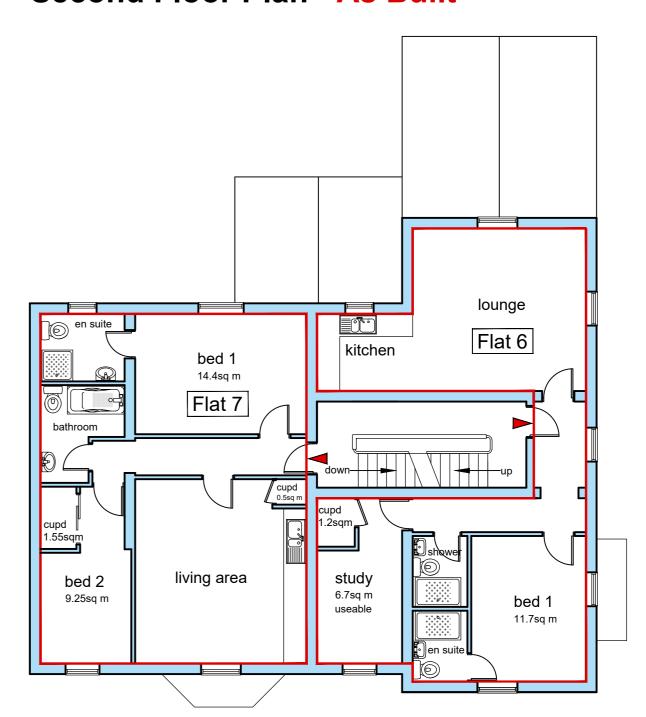

First Floor Plan - As Built

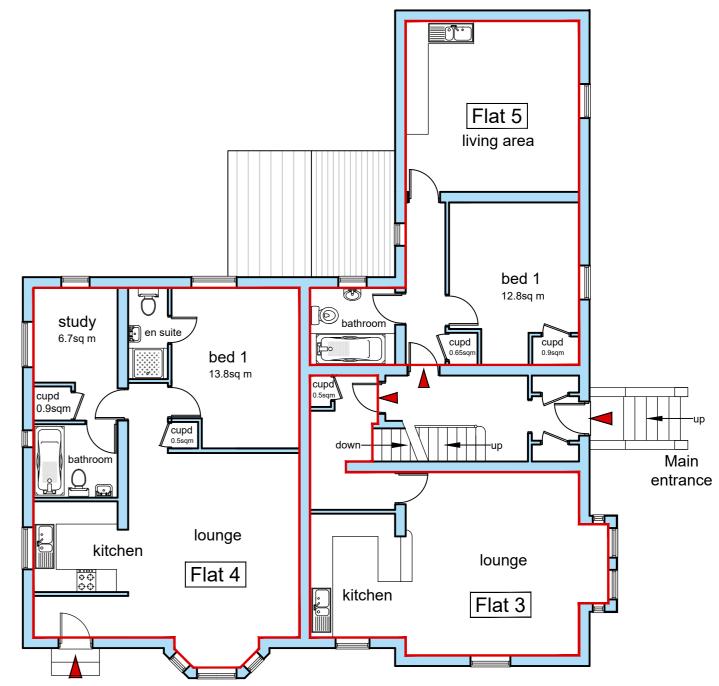

**Ground Floor Plan - As Built** 

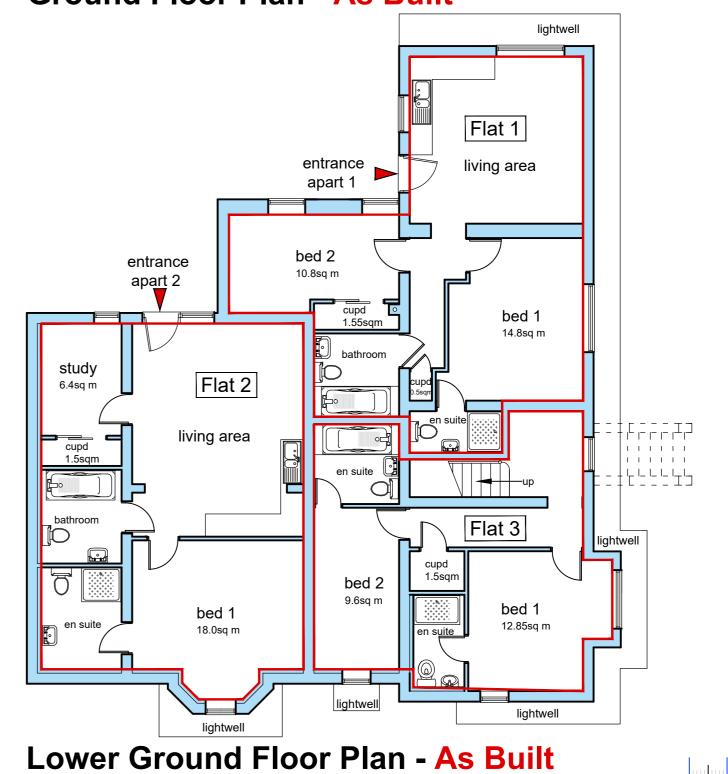

Comparison drawing
As Approved and
As Built Floor Plans

Scale: 1:100 @ A1
Drawing No: MD-004
Date: Nov 2023

NW/21/01116/FUL