




FRONT ELEVATION



REAR ELEVATION

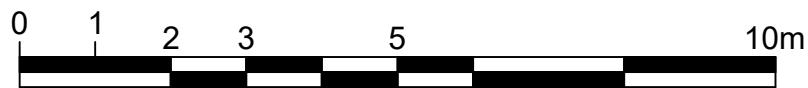

PLANNING SUBMISSION DRAWING

NOTES:
 1- ALL DIMENSIONS TO BE CHECKED ON SITE ANY DISCREPANCY BROUGHT TO THE ATTENTION IMMEDIATELY
 2- ALL STRUCTURAL WORKS TO BE CARRIED OUT TO ENGINEERS DESIGN AND STRICTLY UNDER HIS SUPERVISION
 3- CONTRACTOR TO TAKE FULL RESPONSIBILITY FOR ALL DESIGN, ERECTION AND TEMPORARY WORKS

AS-BUILT/PROPOSED ELEVATIONS

SCALE 1:100
A3

DWG NO N/11B

ADDITIONS ALTERATION TO:
82 COWPER GARDENS, WALLINGTON
SURREY, SM6 9RL

FOR:
Mr. VIJAY PAYARDA

Planning Additions Ltd
 109 Bodley Road
 New Malden
 KT3 5QX
 m. 0785 211 7366
 t. 0208 286 6004
 e. info@planningadditions.co.uk
 w. www.planningadditions.co.uk

