


This drawing is COPYRIGHT. It must not be reproduced or disclosed to third parties without our prior permission. Do not scale from this drawing, or, interrogate and use electronic information.

Any discrepancies should be reported immediately.

Any surveyed information incorporated within this drawing cannot be guaranteed as accurate unless confirmed by a fixed dimension. All dimensions are in millimetres unless noted otherwise.

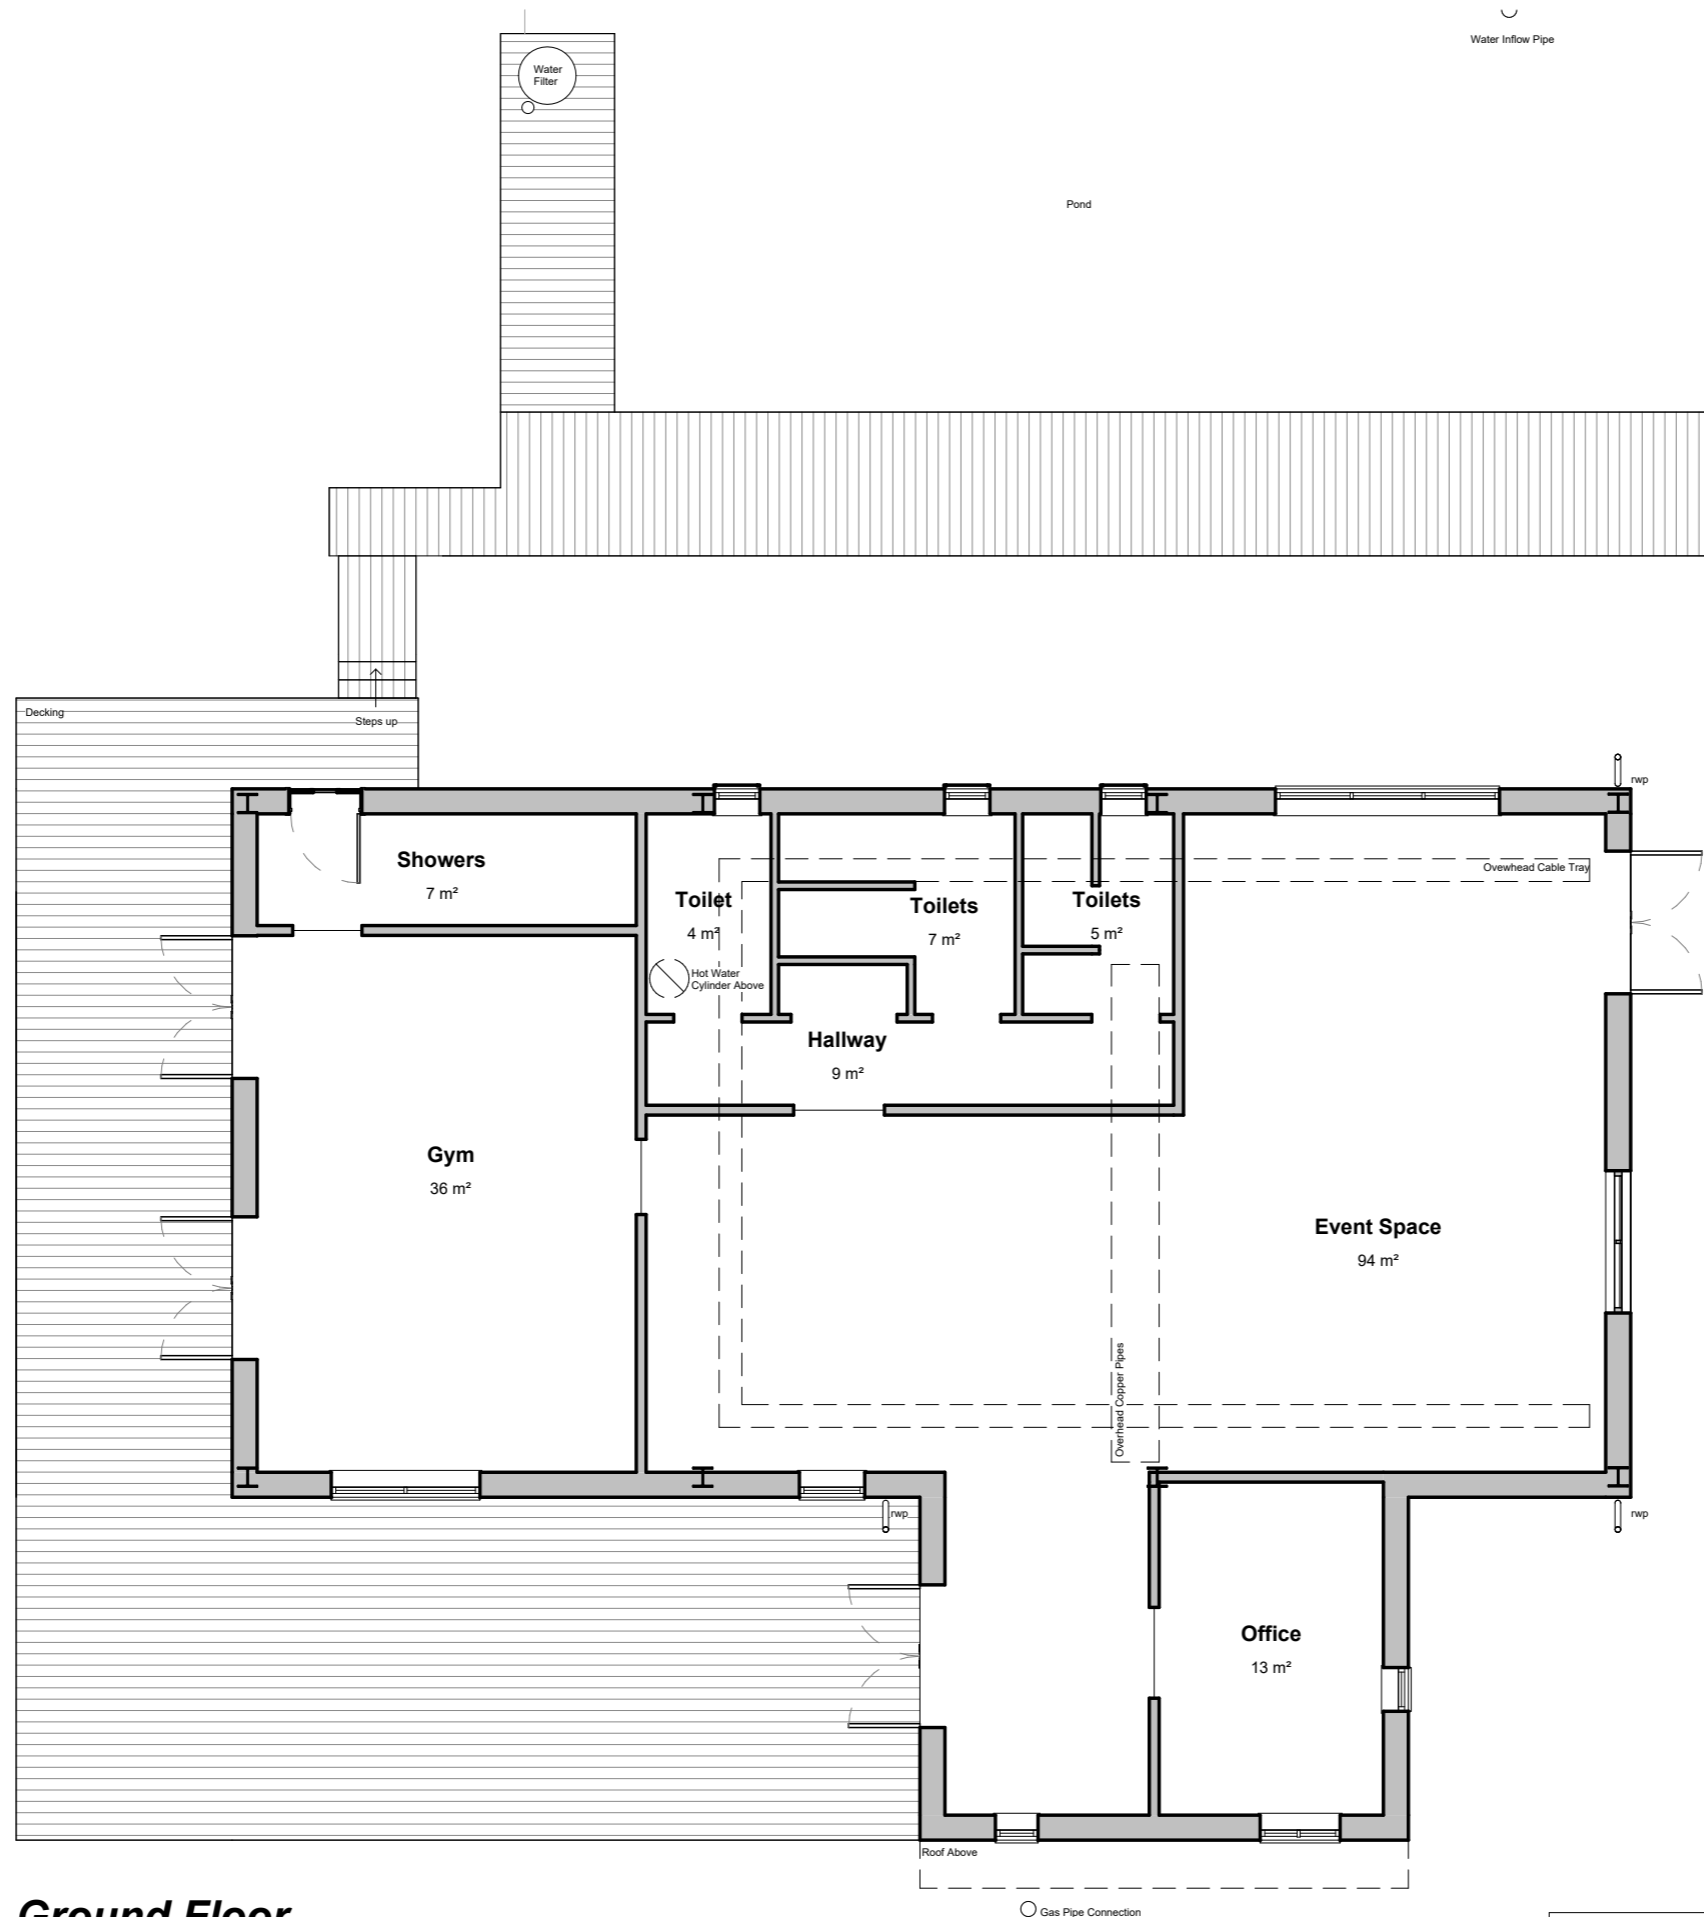

Ground Floor
1 : 100



Head Office
29 Broad Street
Newtown
Powys
SY16 2BQ
t - 01686 610311
w - www.hughesarchitects.co.uk

Project :- Planning Regularisation at land at Aelybryn (now Cwm Hafren Holiday Park), Aberhaseph, SY16 3HR	
Drawing Status :- Stage 3a: Planning	Drawing Title :- As Built Ground Floor Plan
Scale :- 1 : 100	Date :- 06.12.23
Drawn by :- WRF	Checked :- DH
Drawing No :- Y064.3a. 3.100	Rev :-