


This drawing is COPYRIGHT. It must not be reproduced or disclosed to third parties without our prior permission. Do not scale from this drawing, or, interrogate and use electronic information.

Any discrepancies should be reported immediately.

Any surveyed information incorporated within this drawing cannot be guaranteed as accurate unless confirmed by a fixed dimension. All dimensions are in millimetres unless noted otherwise.

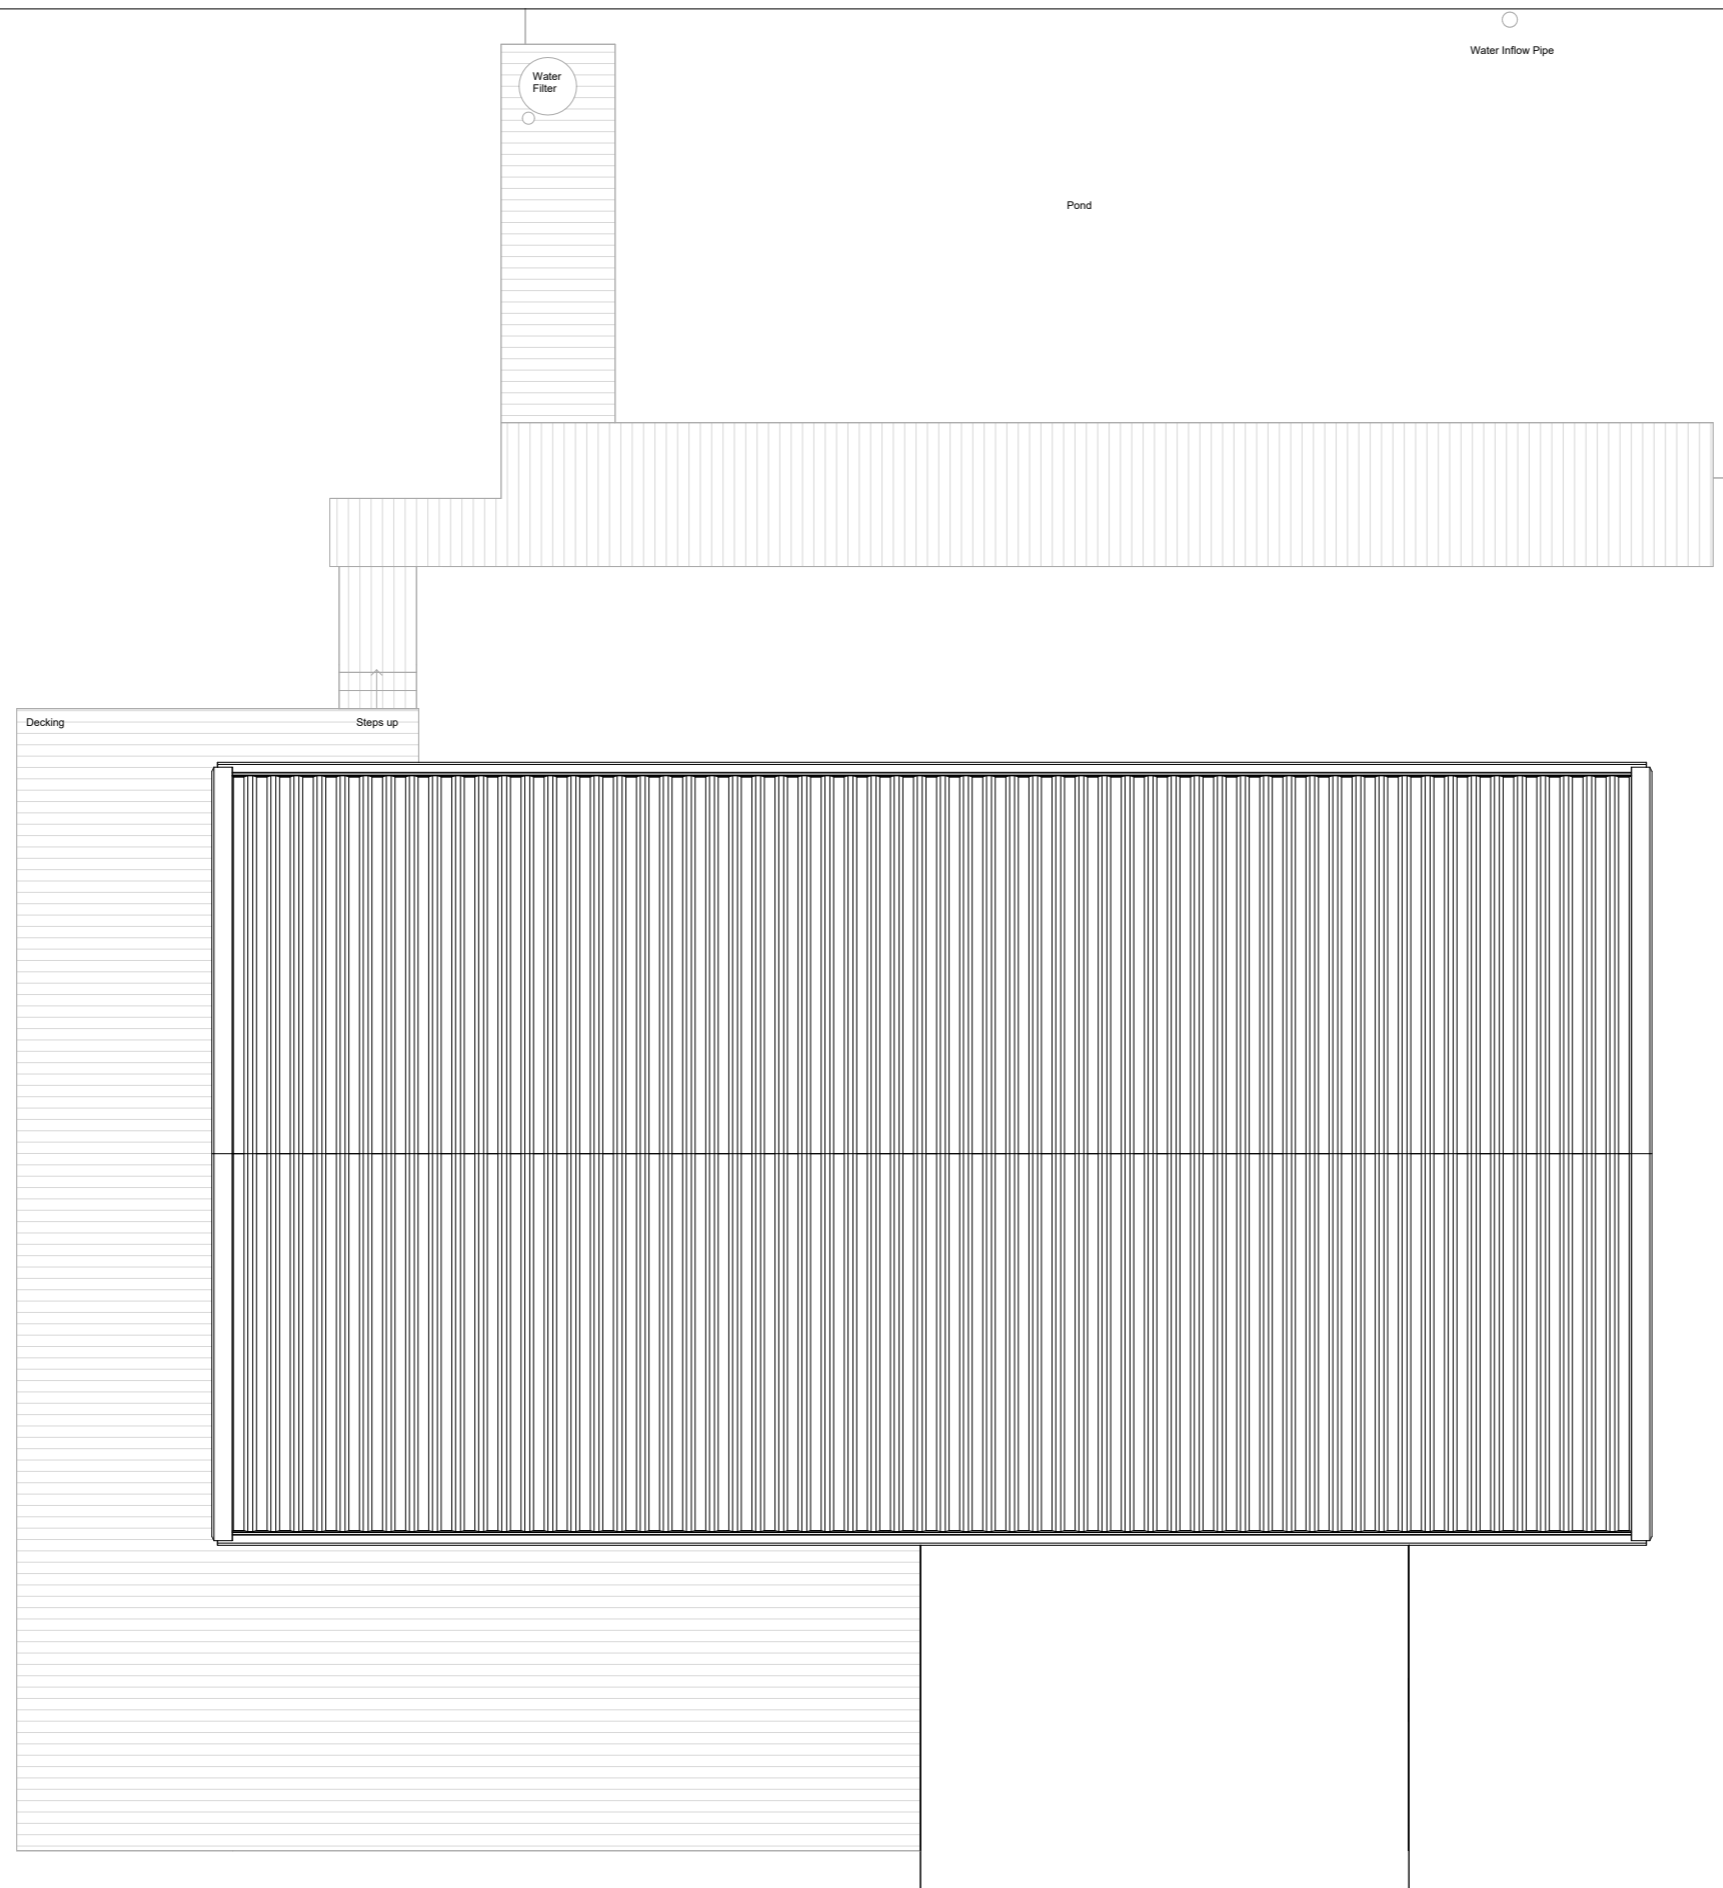

**Roof Plan**  
1 : 100

Head Office  
29 Broad Street  
Newtown  
Powys  
SY16 2BQ  
t - 01686 610311  
w - www.hughesarchitects.co.uk

**HUGHES**  
**ARCHITECTS**

<b>Project :-</b> Planning Regularisation at land at Aelybryn (now Cwm Hafren Holiday Park), Aberhaseph, SY16 3HR			
<b>Drawing Status :-</b> Stage 3a: Planning		<b>Drawing Title :-</b> As Built Roof Plan	
<b>Scale :-</b> 1 : 100	<b>Date :-</b> 06.12.23	<b>Drawing No :-</b>	<b>Rev :-</b>
<b>Drawn by :-</b> WRF	<b>Checked :-</b> DH	<b>Y064.3a. 3.101</b>	