


This drawing is COPYRIGHT. It must not be reproduced or disclosed to third parties without our prior permission. Do not scale from this drawing, or, interrogate and use electronic information.


Any discrepancies should be reported immediately.

Any surveyed information incorporated within this drawing cannot be guaranteed as accurate unless confirmed by a fixed dimension. All dimensions are in millimetres unless noted otherwise.

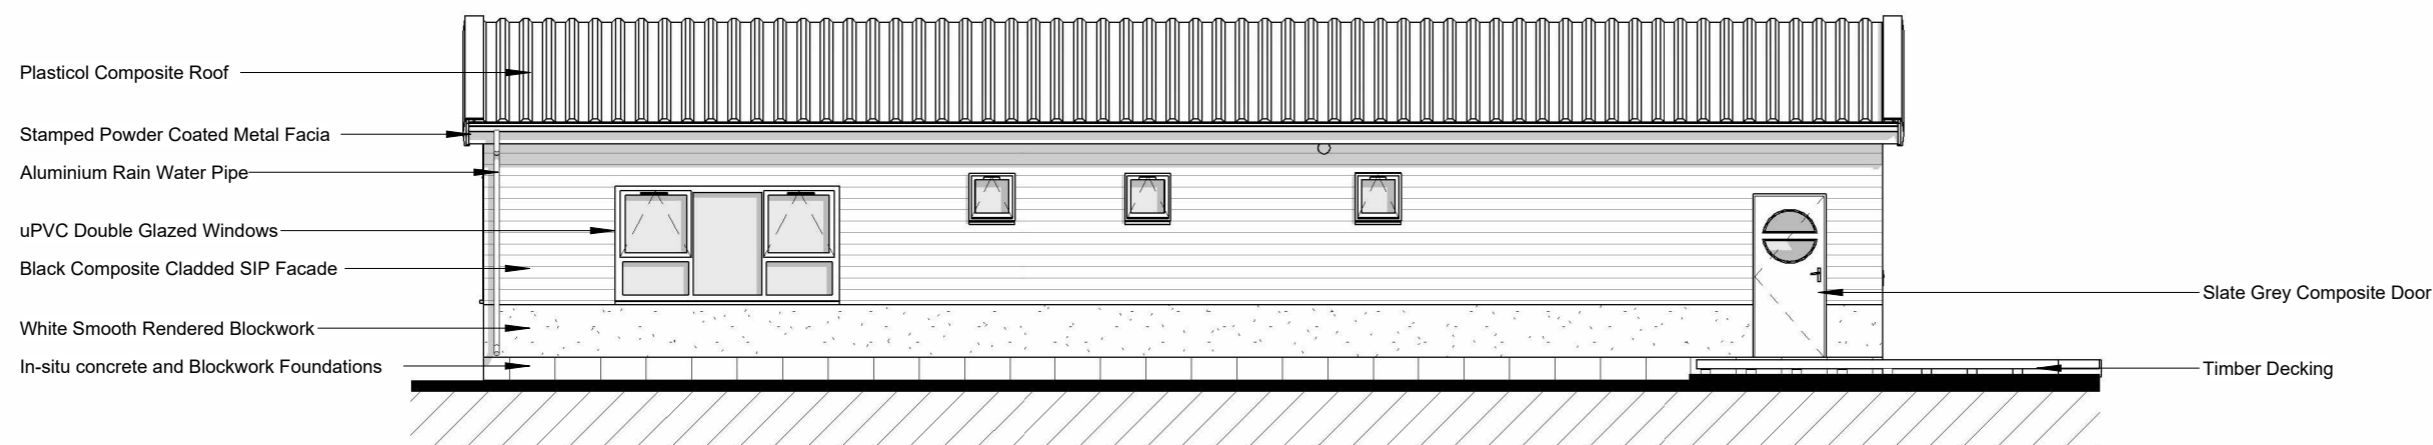

Rear Elevation

1 : 100

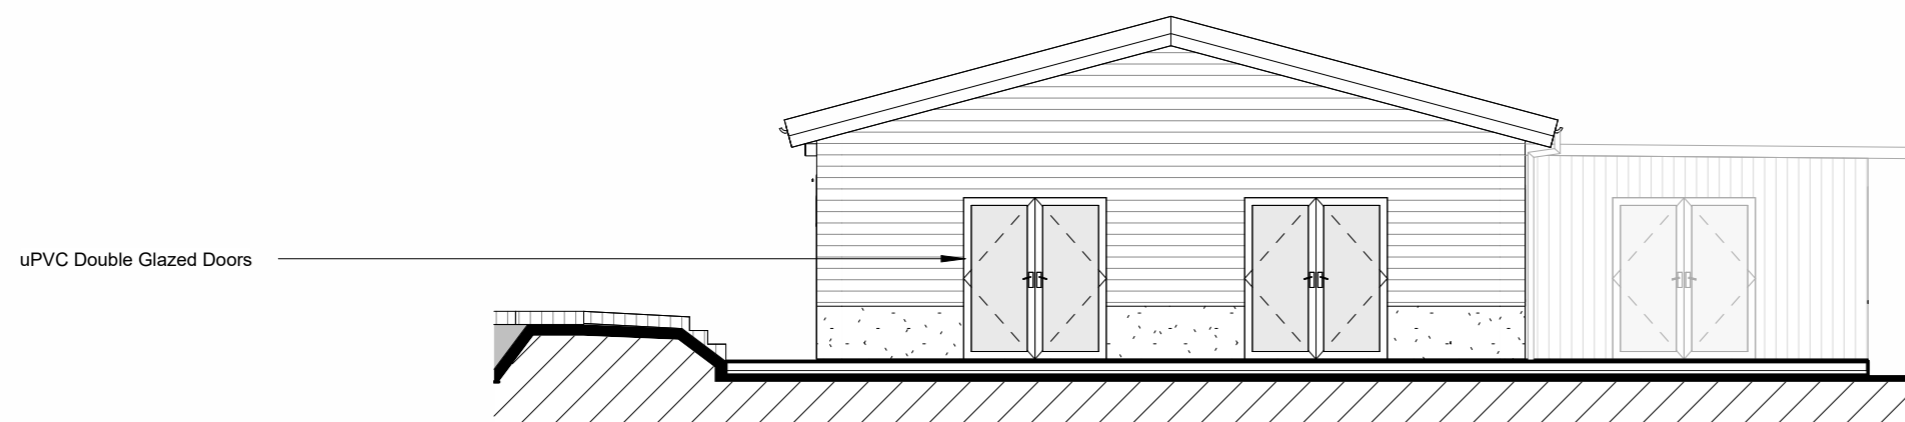

Side 2 Elevation

1 : 100

Project :- Planning Regularisation at land at Aelybryn (now Cwm Hafren Holiday Park), Aberhaseph, SY16 3HR			
Drawing Status :- Stage 3a: Planning		Drawing Title :- As Built Rear and Side 2 Elevation	
Scale :- 1 : 100	Date :- 06.12.23	Drawing No :- Y064.3a. 3.111	Rev :-
Drawn by :- WRF	Checked :- DH		