



1 Existing Ground Floor

1 : 100

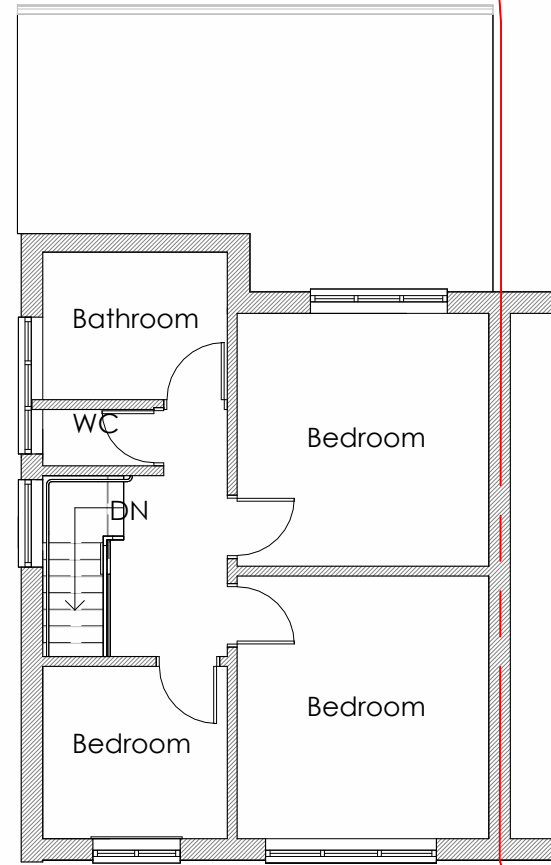


2 Existing First Floor Plan

1 : 100

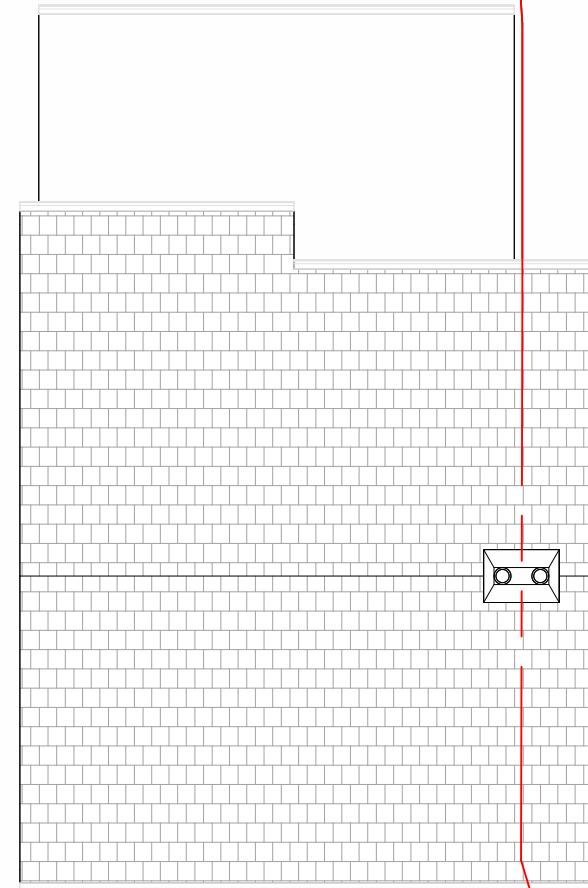

3 Existing Roof Plan

1 : 100

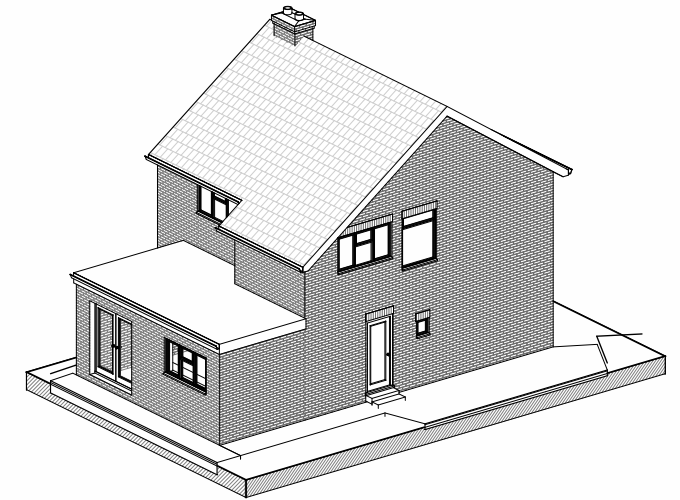

4

Iso 1 - Existing



5 East Elevation Existing

1 : 100



6 South Elevation Existing

1 : 100



7 West Elevation Existing

1 : 100



GRAPHIC SCALE: 1:100

REV	DATE	REV	DRAWN	CHECKED
RD Consulting sustainable technical solutions 8 Ruffles Close, Rayleigh, Essex, SS6 8EW T: 01286 741368 F: 01286 741368 E: info@rdconsult.co.uk W: www.rdconsult.co.uk				
Mr & Mrs Croker				
30 Norton Road, Ingatestone				
Current Plans and Elevations (As-Built 1990)				
DATE	DRAWN	PROJ No.		
02/01/24	TE	23517		
SCALE	CHKD	DWG No.	REV	
1 : 100	RD	003		
THIS DRAWING IS COPYRIGHT OF RD CONSULTING AND MAY NOT BE REPRODUCED WITHOUT PERMISSION			STAGE PLANNING	