

NOTES

PROJ No.	COM-0027733
E-REF	E306377
CSID	113685
CSR	68211
VFID	32493
CELL No.	6821102

BT SKYLINE No. **LS0006**

16.A					
16	NCO-0009218 AS BUILT	25/05/23	GBC	MIT	
15	212270 MINOR AMEND	30/11/21	WHP	WHP	
14	212270 MINOR AMEND	15/11/21	WHP	WHP	
13	212270 MINOR AMEND	19/10/21	WHP	WHP	
ISS	REVISION	DATE	DRN	APP	



SITE No **165964**
 OTLEY NEW ATE
 CHARLES STREET
 OTLEY
 WEST YORKSHIRE
 LS21 1BJ



NGR SE 20420 45380
 OS GRID 420420 445380

TITLE
 ELEVATION (SOUTH)
 PLANNING APPLICATION

SCALE 1:200

DRAWN	IM	01/06/11
APPROVED	MIT	25/05/23

DRG No. **165964-03-153-MD016** Sheet 4 of 5 Rev **16.A**

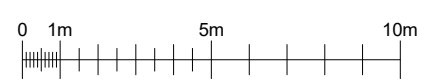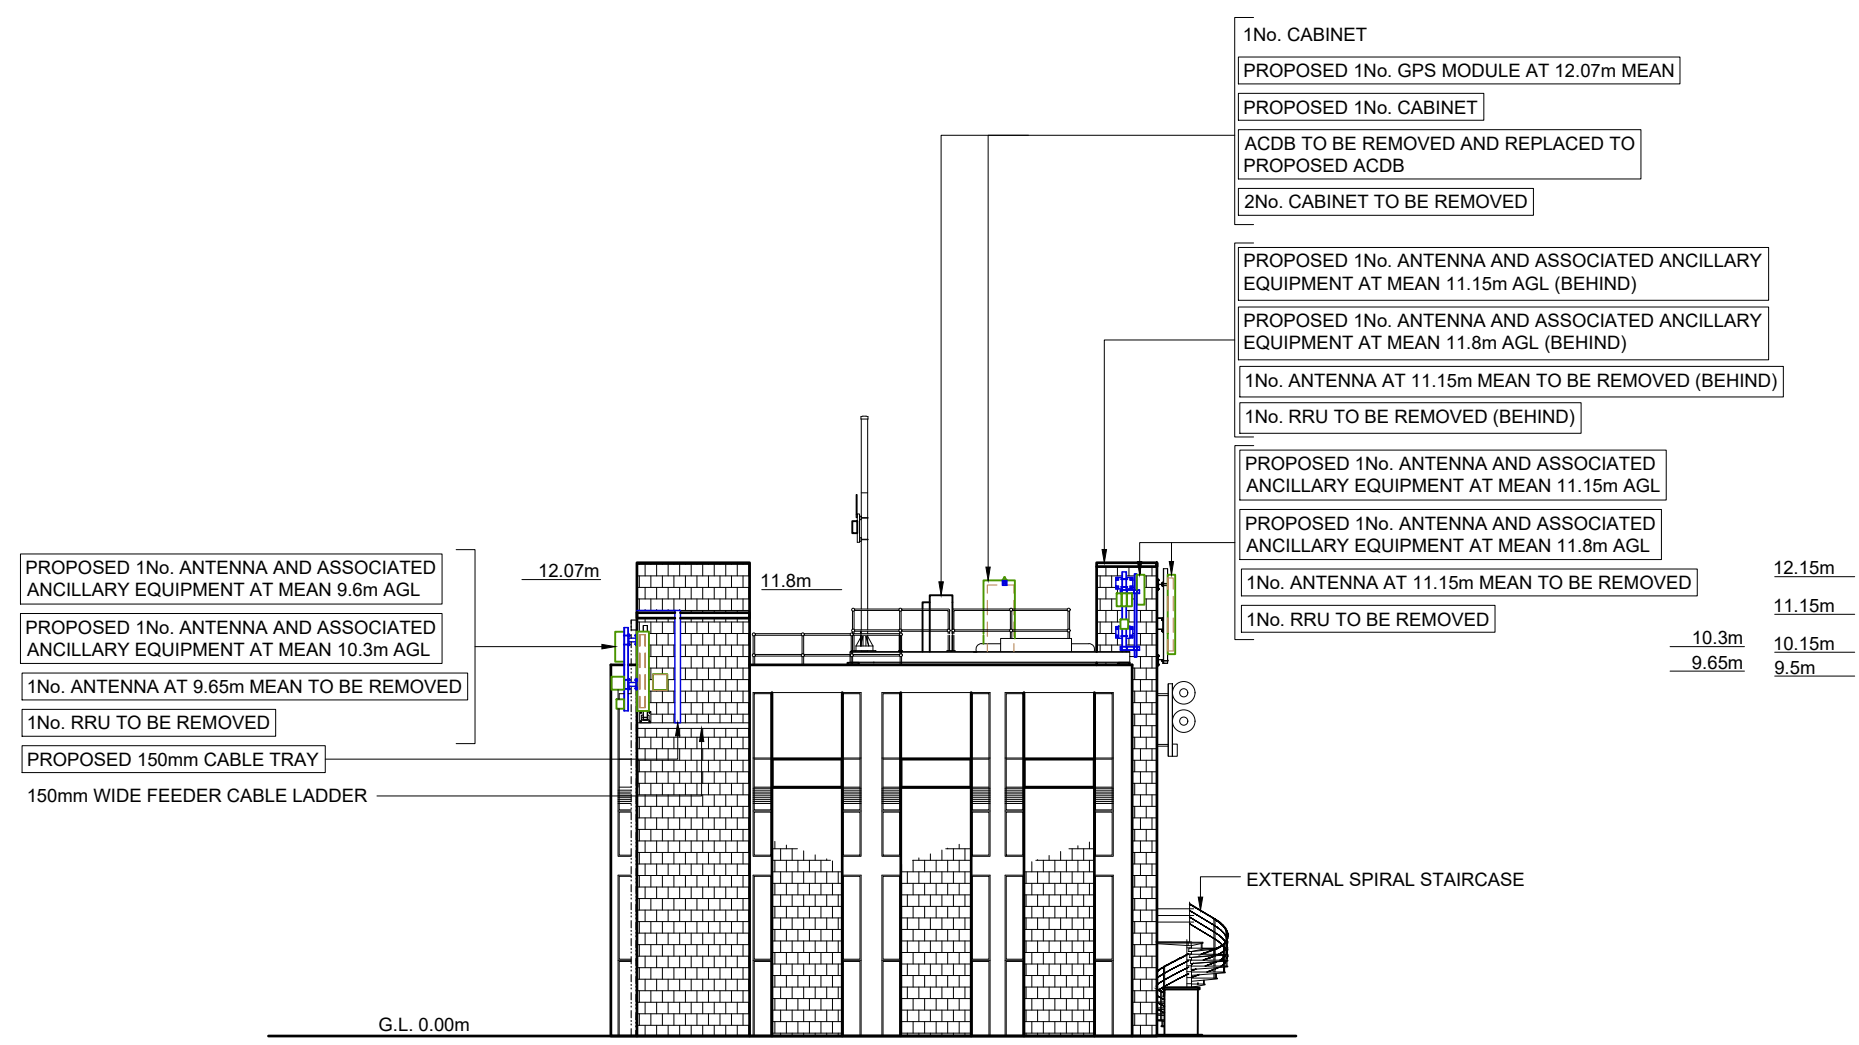

SOUTH ELEVATION

FEINT DETAILS INDICATE LOCATIONS RESERVED FOR OTHER PROPOSALS WHICH MAY BE THE SUBJECT OF SEPARATE APPLICATIONS