





©2020 Cellnex
 All rights reserved. No part of this publication may be reproduced, stored in a retrieval system or transmitted in any form or by any means (Electronic, Mechanical, Photocopying, Recording or otherwise), without the prior written consent of the Company.

NOTES

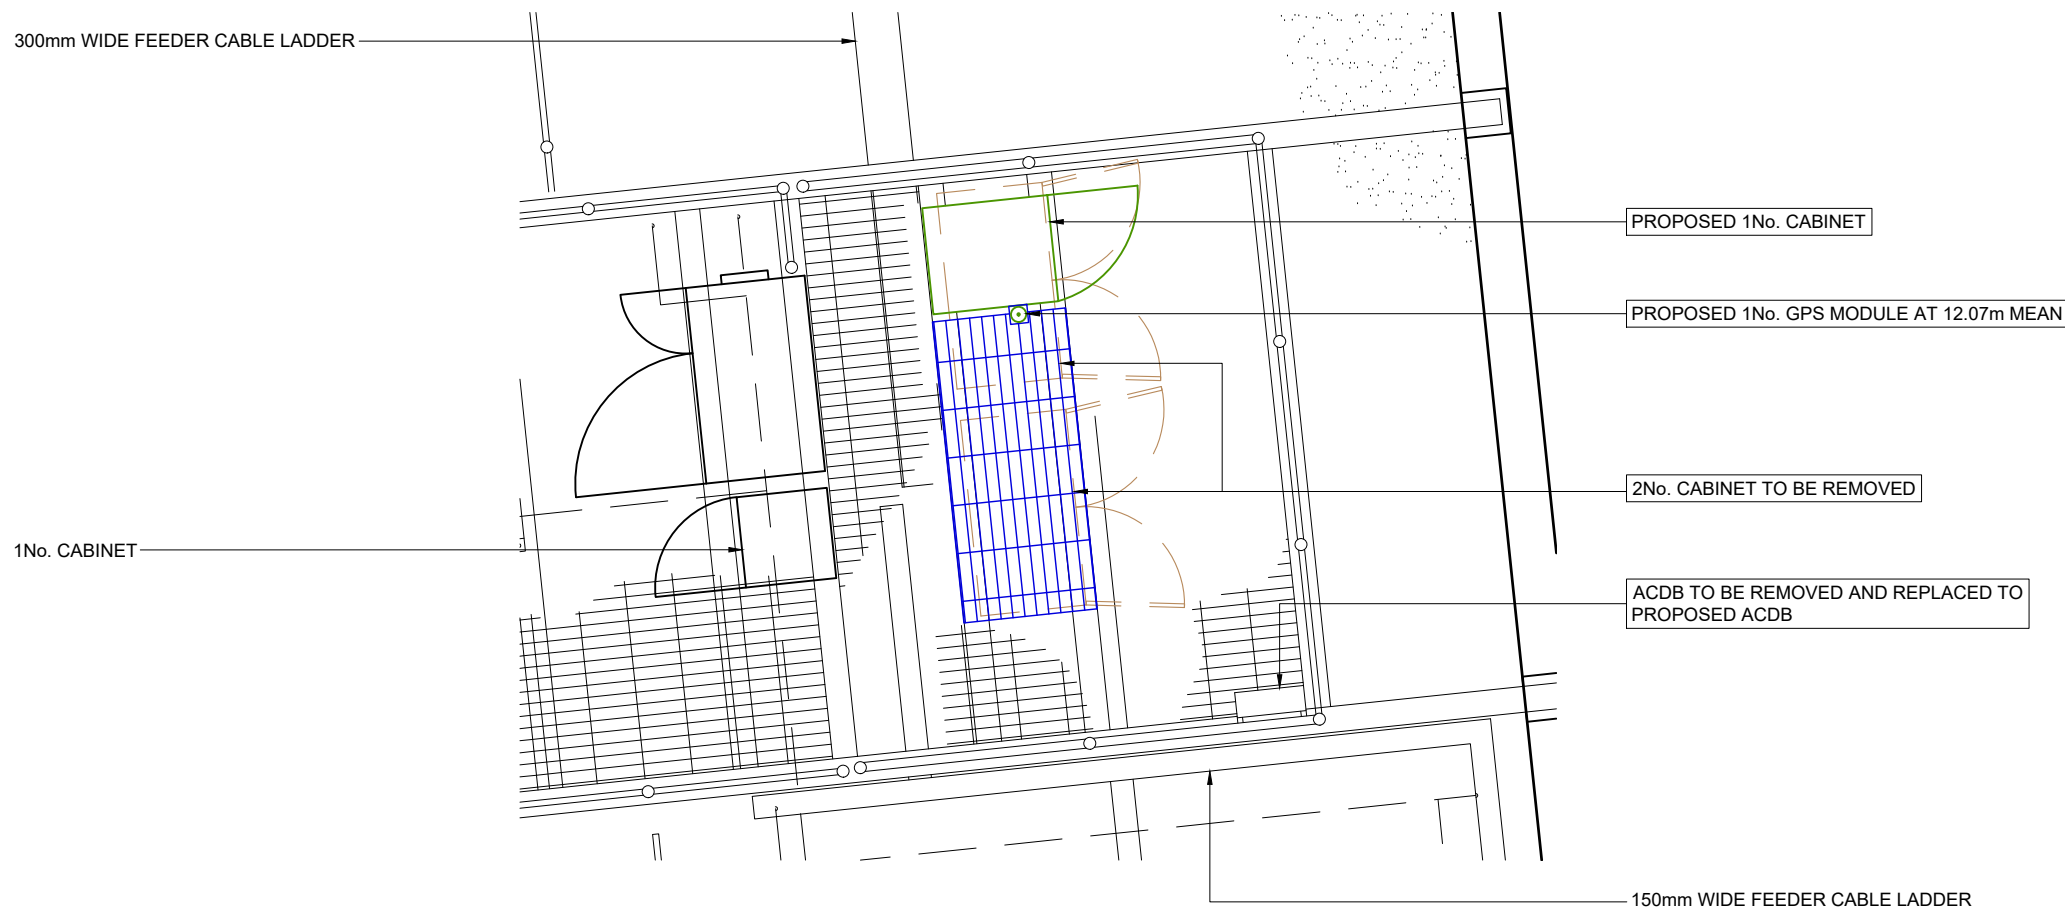

EQUIPMENT PLAN

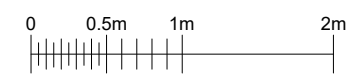

FEINT DETAILS INDICATE LOCATIONS RESERVED FOR OTHER PROPOSALS WHICH MAY BE THE SUBJECT OF SEPARATE APPLICATIONS

PROJ No.	COM-0027733
E-REF	E306377
CSID	113685
CSR	68211
VFID	32493
CELL No.	6821102

BT SKYLINE No.
LS0006

16.A				WHP
16	NCO-0009218 AS BUILT	25/05/23	GBC	MIT
15	212270 MINOR AMEND	30/11/21	WHP	WHP
14	212270 MINOR AMEND	15/11/21	WHP	WHP
13	212270 MINOR AMEND	19/10/21	WHP	WHP
ISS	REVISION	DATE	DRN	APP



CELLNEX UK
 R+, 4TH FLOOR, 2 BLAGRAVE STREET, READING, RG1 1AZ
 Tel. 020 4526 8553

SITE No **165964**
 OTLEY NEW ATE
 CHARLES STREET
 OTLEY
 WEST YORKSHIRE
 LS21 1BJ

NGR SE 20420 45380
 OS GRID 420420 445380

TITLE
 EQUIPMENT PLAN
 PLANNING APPLICATION

SCALE 1:50

DRAWN	IM	01/06/11
APPROVED	MIT	25/05/23

DRG No. **165964-03-154-MD016** Sheet 1 of 1 Rev **16.A**