


Ground Floor


1:50

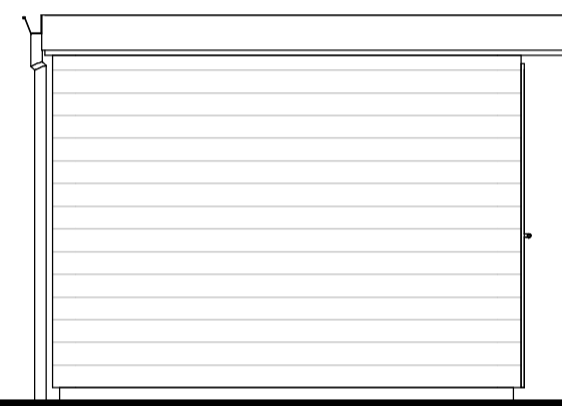

Side Elevation

East


1:50

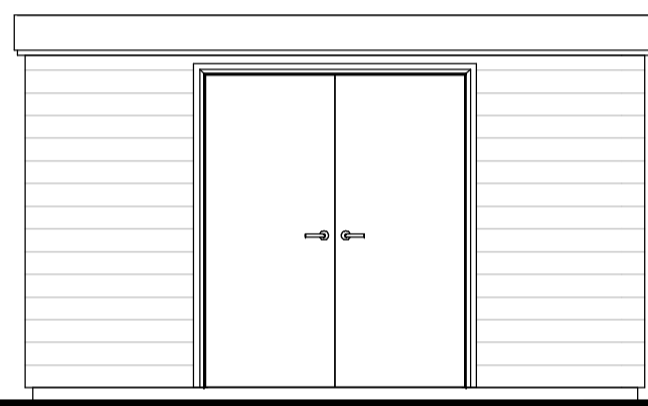

Front Elevation

North


1:50

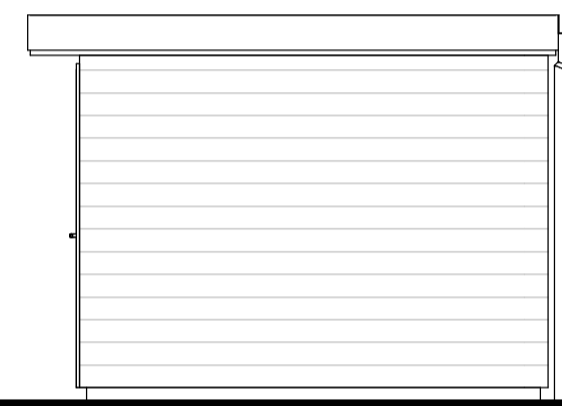

Side Elevation

West



1:50

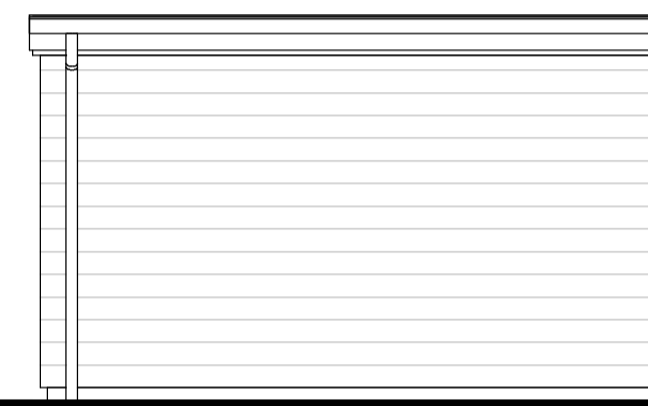

Rear Elevation

South


1:50

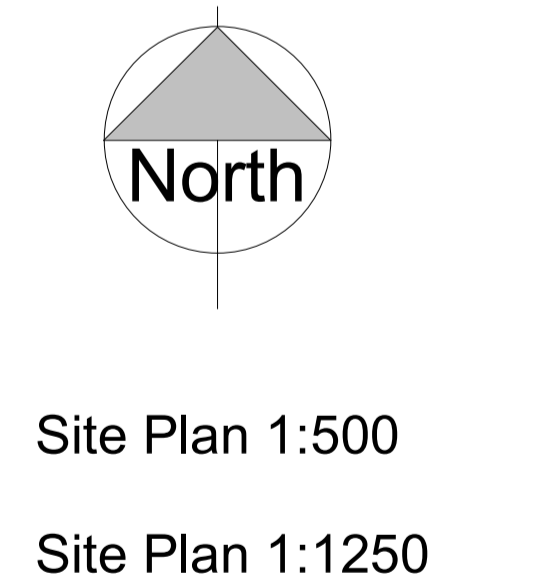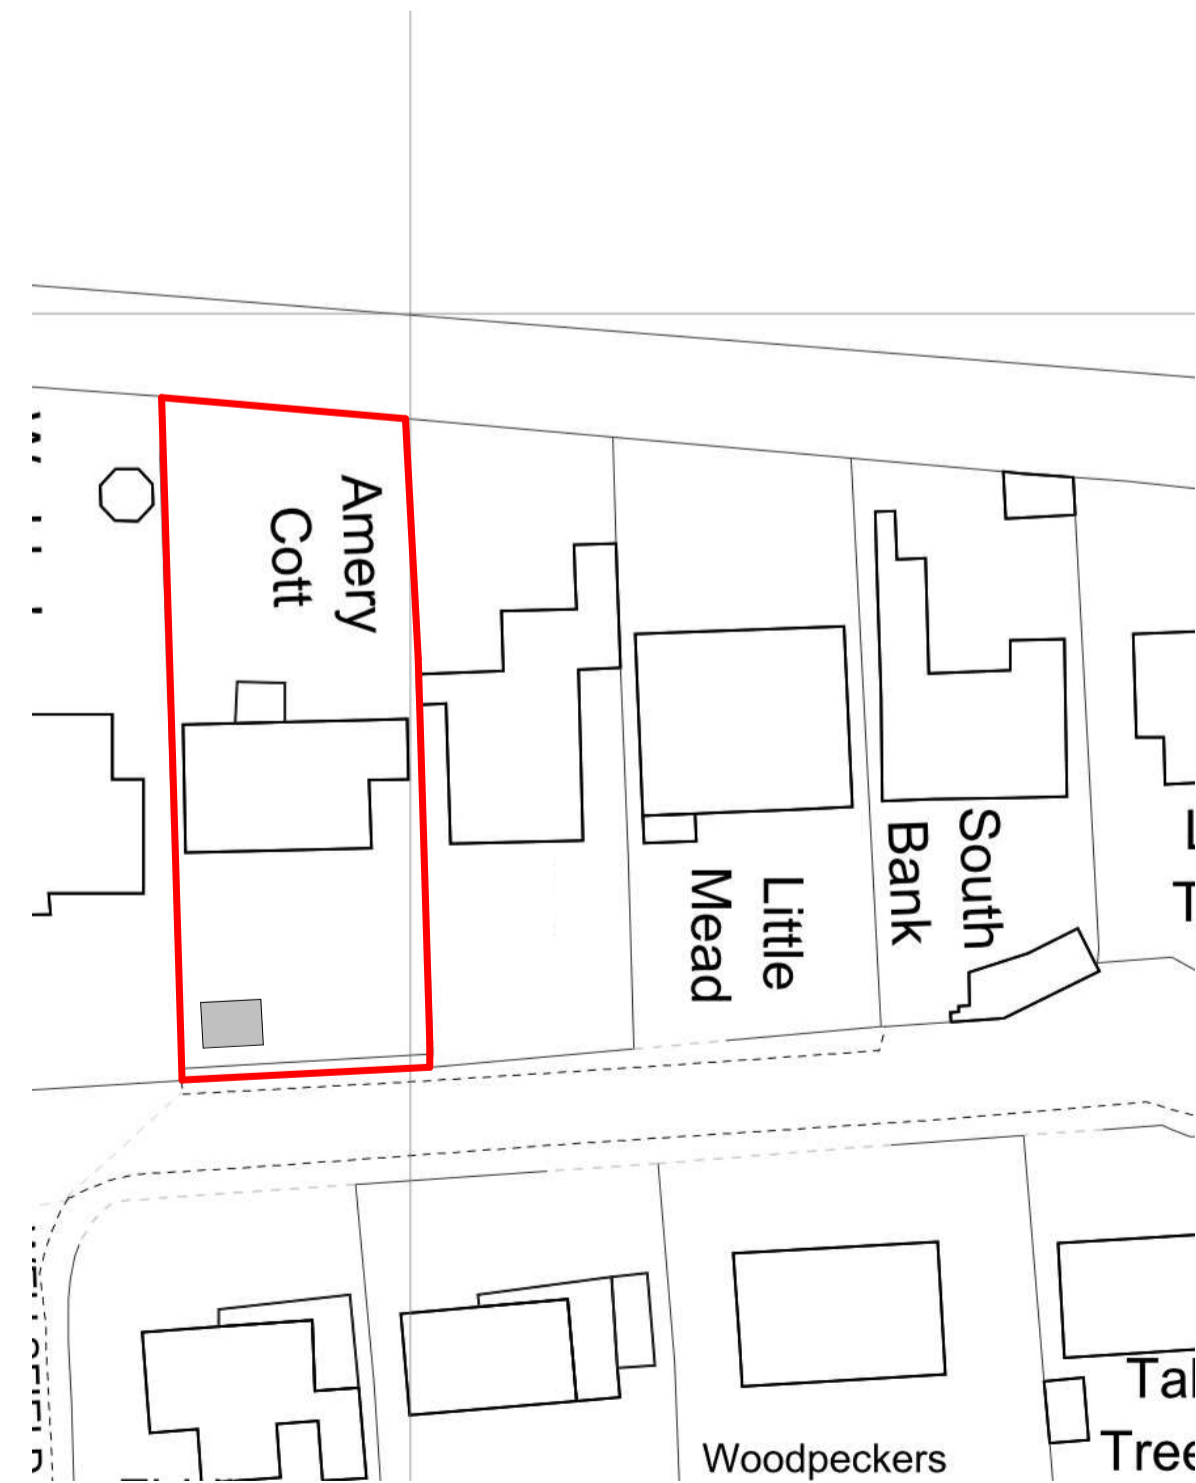

Site Plan 1:500

Site Plan 1:1250

Revisions

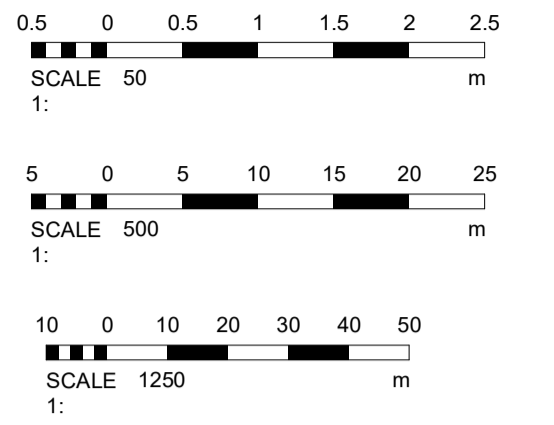

Materials

Drawing Number 2024/16 Sheet 1 of 1

Size A1 Scale 1:50, 1:500, 1:1250

Project
As built situation
January 2024

Job Title
Amery
Wellsfield
West Wittering
Chichester
West Sussex
PO20 8LH

Do Not scale from this drawing except for planning as photocopies will be subject to distortion
Drawings to be read in conjunction with all other Designers and structural engineers contract drawings and specifications: Any discrepancies must be brought to the attention of the Designer immediately.
The contractor must verify all dimensions by site measurement before ordering materials or manufacturing components
Substitute materials and products to those named will be acceptable if proven to be of equal or higher performance and not in conflict with other elements

M.J.Humphrey Ltd



Mel Humphrey MRICS, MBEng 9 Aldsworth Avenue Goring By Sea West Sussex BN12 4XQ
Adam Humphrey 4 Thalassa Road Worthing West Sussex BN11 2HH

Mel@mjhumphrey.co.uk 07701055182 Adam@mjhumphrey.co.uk 07812419142