


Plot Date:20 December 2023 Plot Style: ---- Saved By: Tom on 20 December 2023

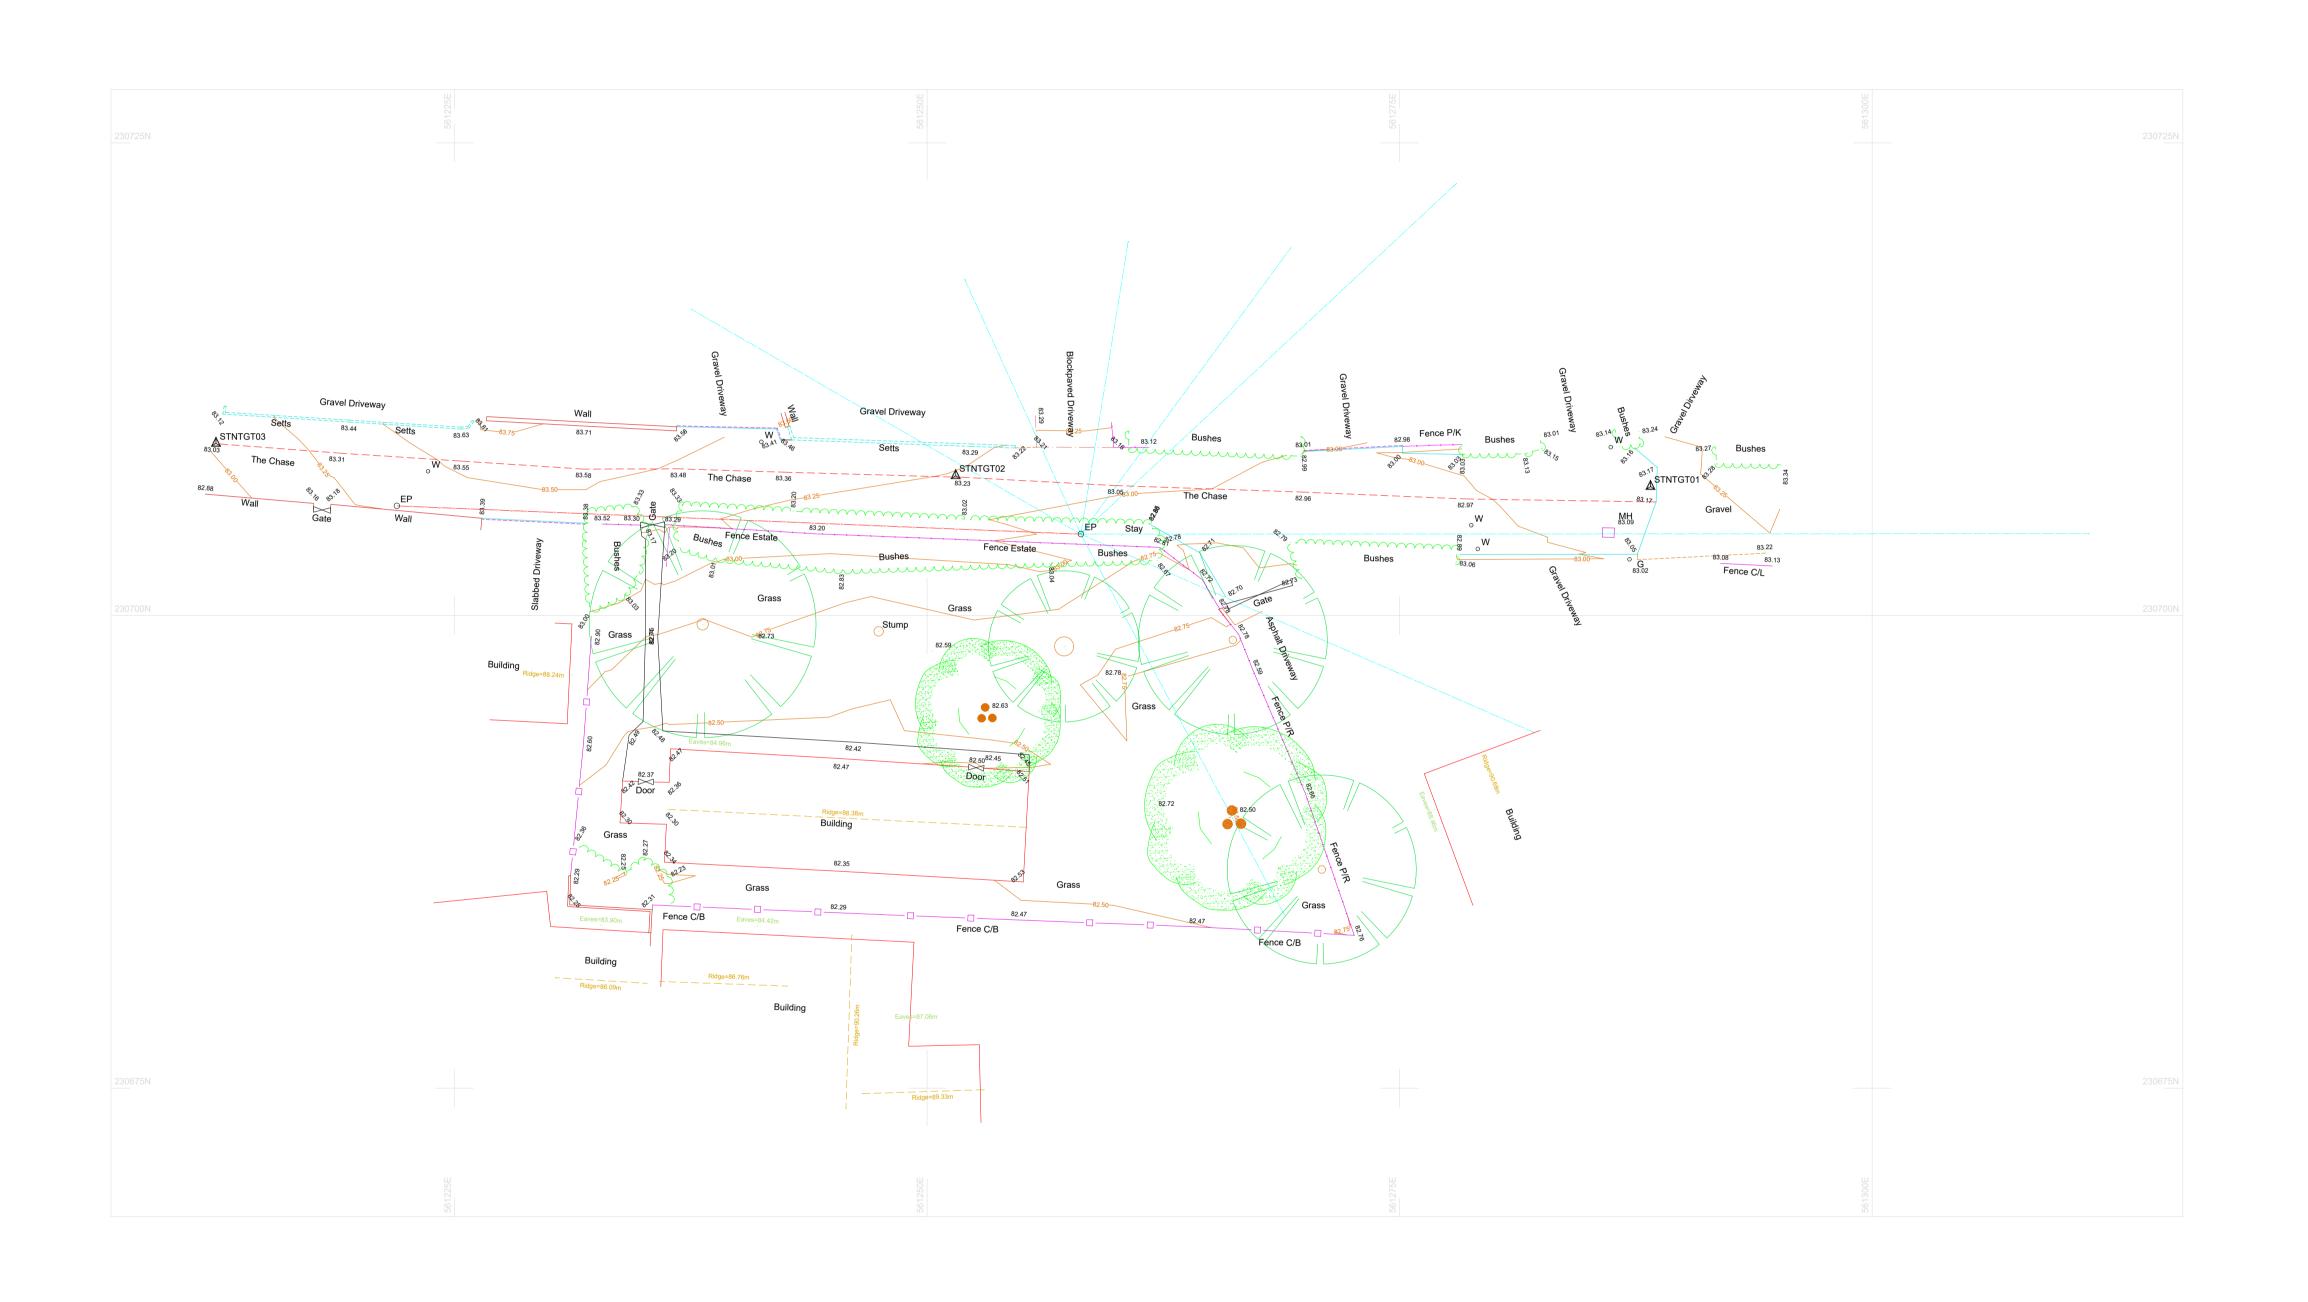

SURVEY STATIONS Easting Northing Height Name STNTGT01 STNTGT02 STNTGT03 230706.825 230707.400 230709.111 83.160 83.201 83.049 561288.272 561251.513 561212.378 Plot Scale Check

Standard Abbreviations (where applicable) Gas Valve TAC Tactile Paving Invert Level Lamp Post TP Telegraph Pole TS Traffic Sign MH Name Board Post Box ET EP+Transformer Feeder Feeder Pillar Chain Link FHD Hoarding x.xx Floor to Ceiling Height X.XX F/C Floor to False Ceiling Height FPW Post & Wire Features Average root line shown. Indicative position of cables. Services 0.225Ø FW MH
Pipe position and alignment 0.375Ø SW MH is indicative only. **Building Heights** Trees Trees are drawn to scale on the survey Trunk diameter and canopy spread SURVEY CARRIED OUT USING TRIMBLE S9 TOTAL STATION & TRIMBLE R10 GPS. ANY CRITICAL DIMENSIONS AND MEASUREMENTS SHOULD BE BASED ON THE ORIGINAL DIGITAL DATA AND CONFIRMED WITH TARGET SES LTD.
ANY ERRORS SHOULD BE NOTIFIED TO TARGET SES LTD.

EV	Date	Created By		Comments	
ale at A1			Project Number		
1:200			20195-1324		

19.12.23 TH First Issue

X Existing Topographic Survey

As Built Survey For Information



2 Flint Cottages, Lackford, Bury St Edmunds, Suffolk, IP28 6HW t: 01284 711476 m: 07557 734388 e: info@targetltd.co.uk

Mark Latchford

Church of the English Martyrs The Chase (off Park Street) Thaxted

Existing Ground Level Survey

TSES- 20195- 1324- EGL- 00
Originator | Project Number | Type | Number