


This drawing is provided as a document to gain either Planning Permission or Building Regulation approval purposes only. It is not a guarantee that Planning Permission will be granted.
 This drawing and all contents are the copyright of James Campbell Associates Ltd. No copies to be made from the drawing & details unless authorised by James Campbell Associates Ltd.
 The contract for the works is between the client and his / her contractor. Contractor to visit site, study the details provided within the drawing and be familiar with both the work to be carried out in accordance with the details provided. Any stated dimension must be checked prior to any form of construction. All works and materials to comply with all relevant British Standards and carry a genuine BBA certificate. The materials specified within this drawing are a guide for the contractor as they are recognised materials with genuine BBA certificates etc. Any contractor who decides to use any different materials than that noted on the drawing must inform James Campbell Associates Ltd.
 Any discrepancies discovered or items found that were not visible at the time of the initial survey should be reported to James Campbell Associates Ltd for consultation with our client.

CONSTRUCTION NOTES:-

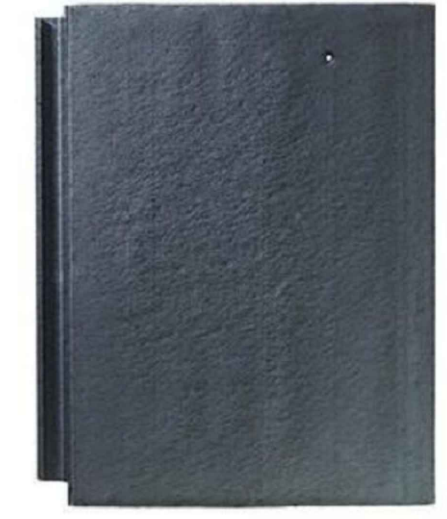


Sandtoft TLE artificial slate tile for low pitch roof. Sandtoft TLE is one of the thinnest leading edges on the market. It gives a slate-like appearance and offers all the benefits of a modern interlocking design.


Minimum Roof Pitch:
 17.5 degrees at 100mm headlap
 22.5 degrees at 75mm headlap

PROPOSED BIODIVERSITY


Provide bat boxes to the rear gable elevation of the existing building.

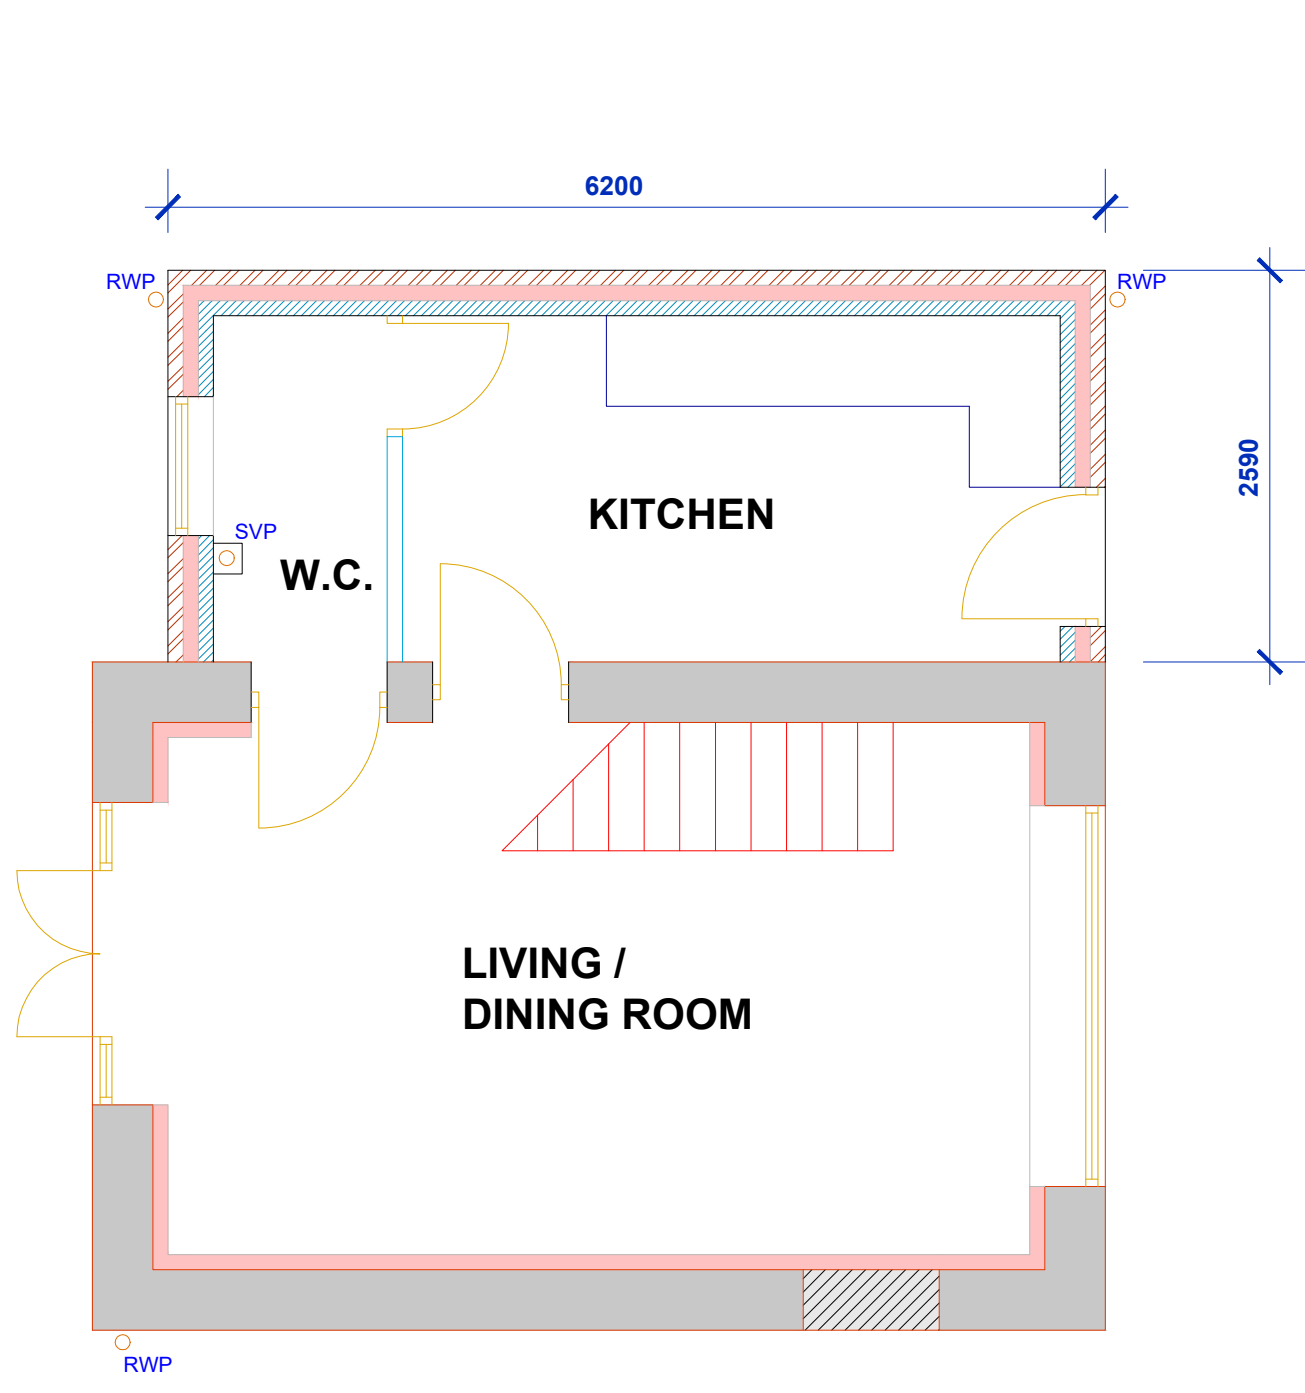


AS BUILT GROUND FLOOR PLAN

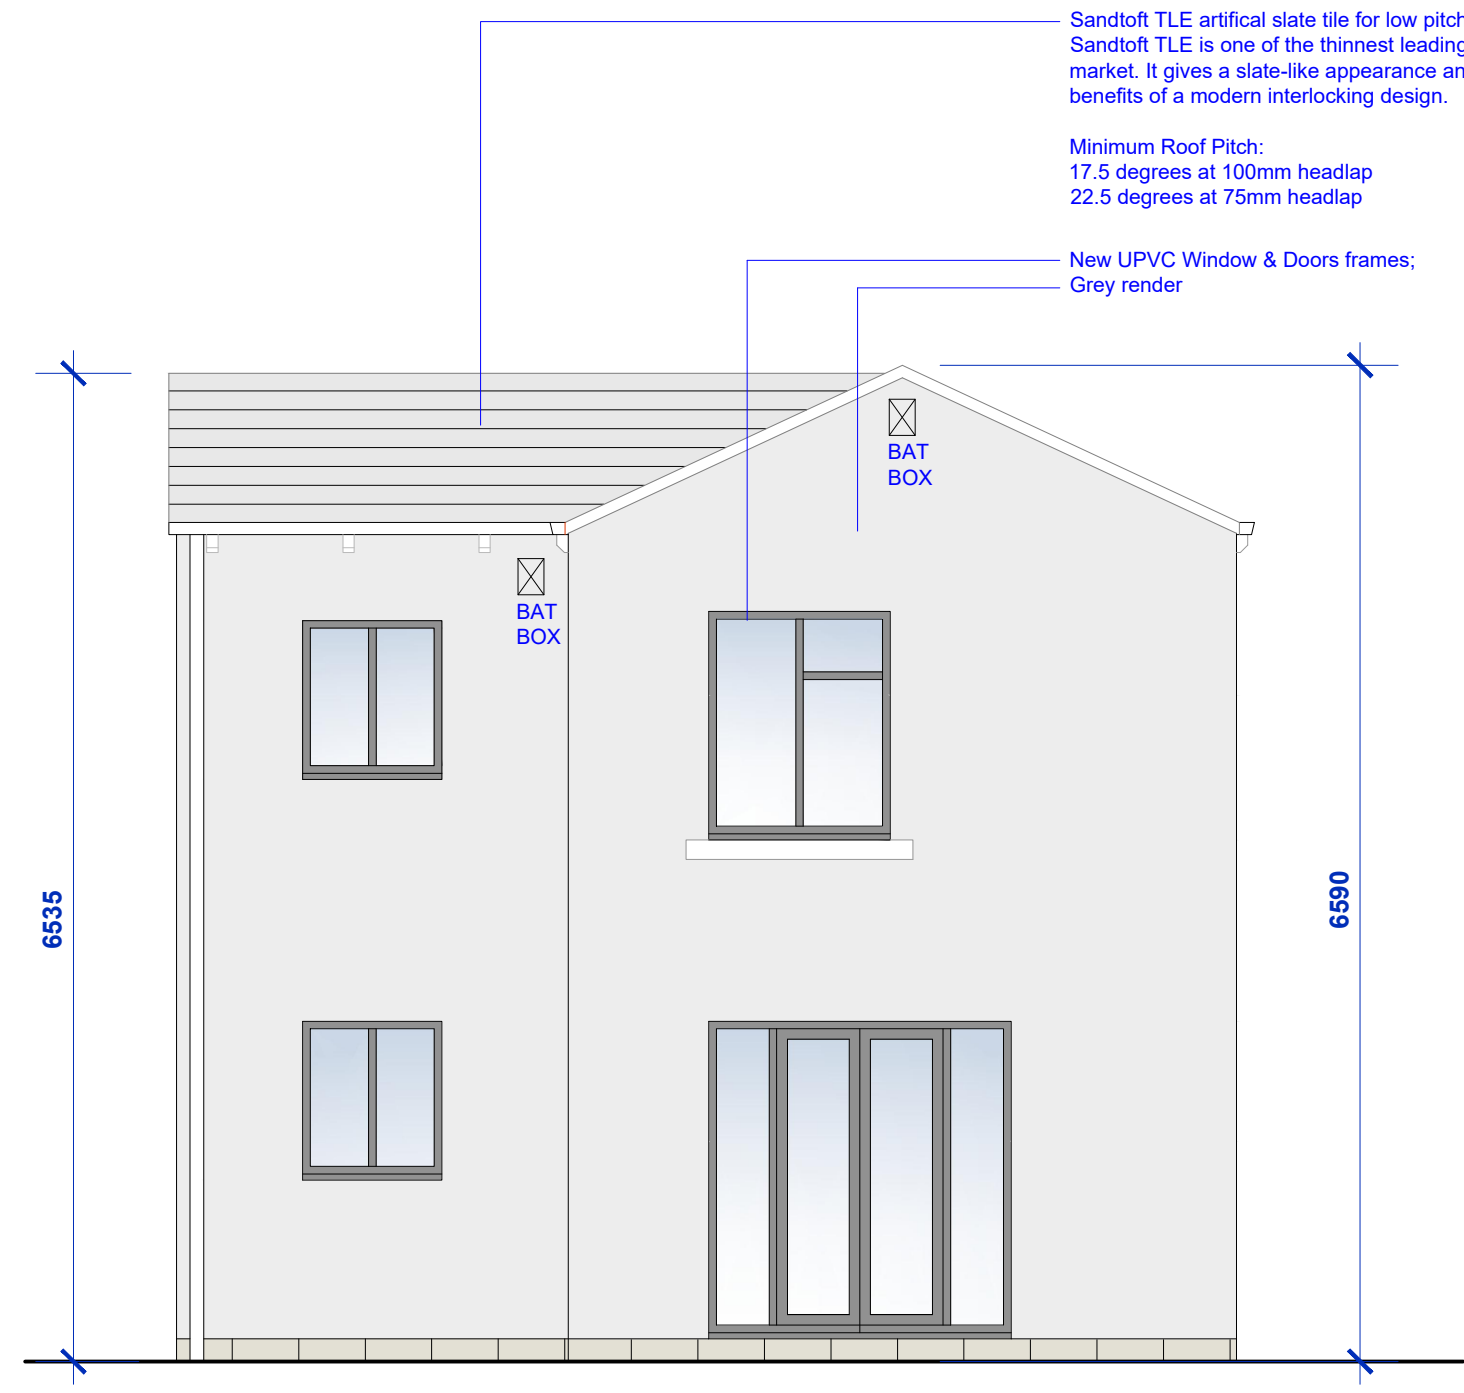

AS BUILT REAR ELEVATION

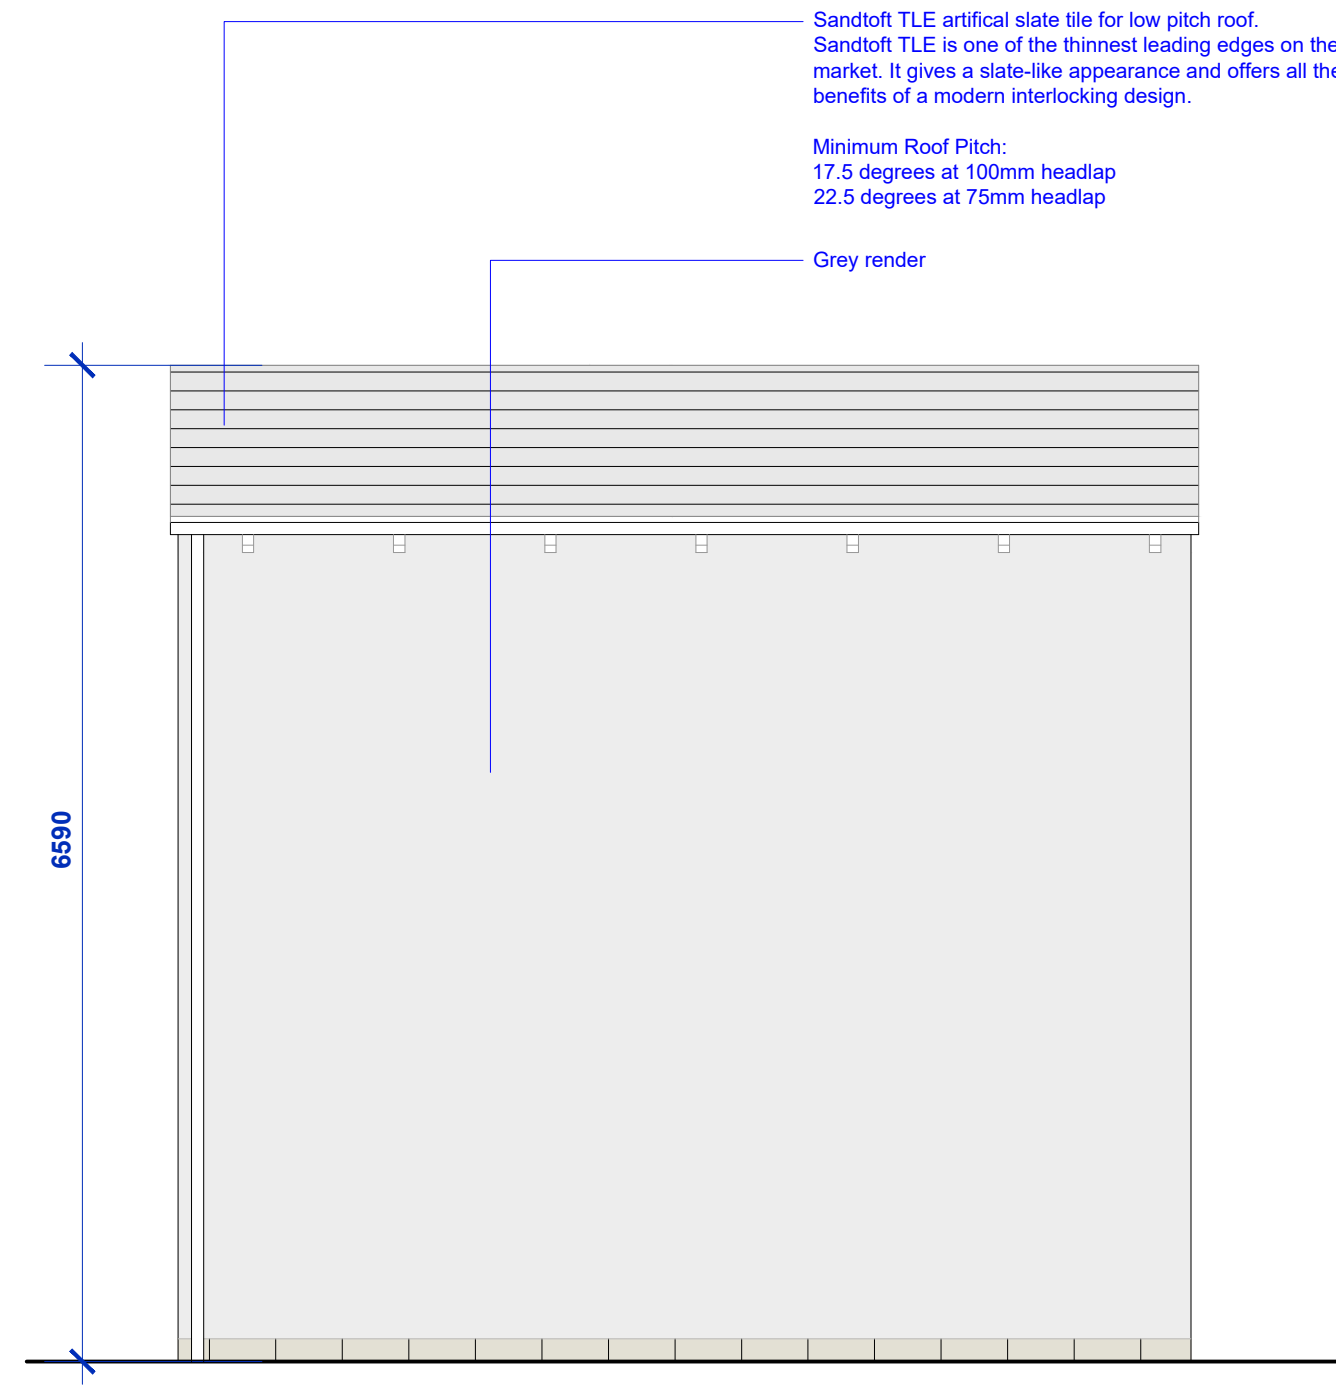


AS BUILT SIDE ELEVATION 2

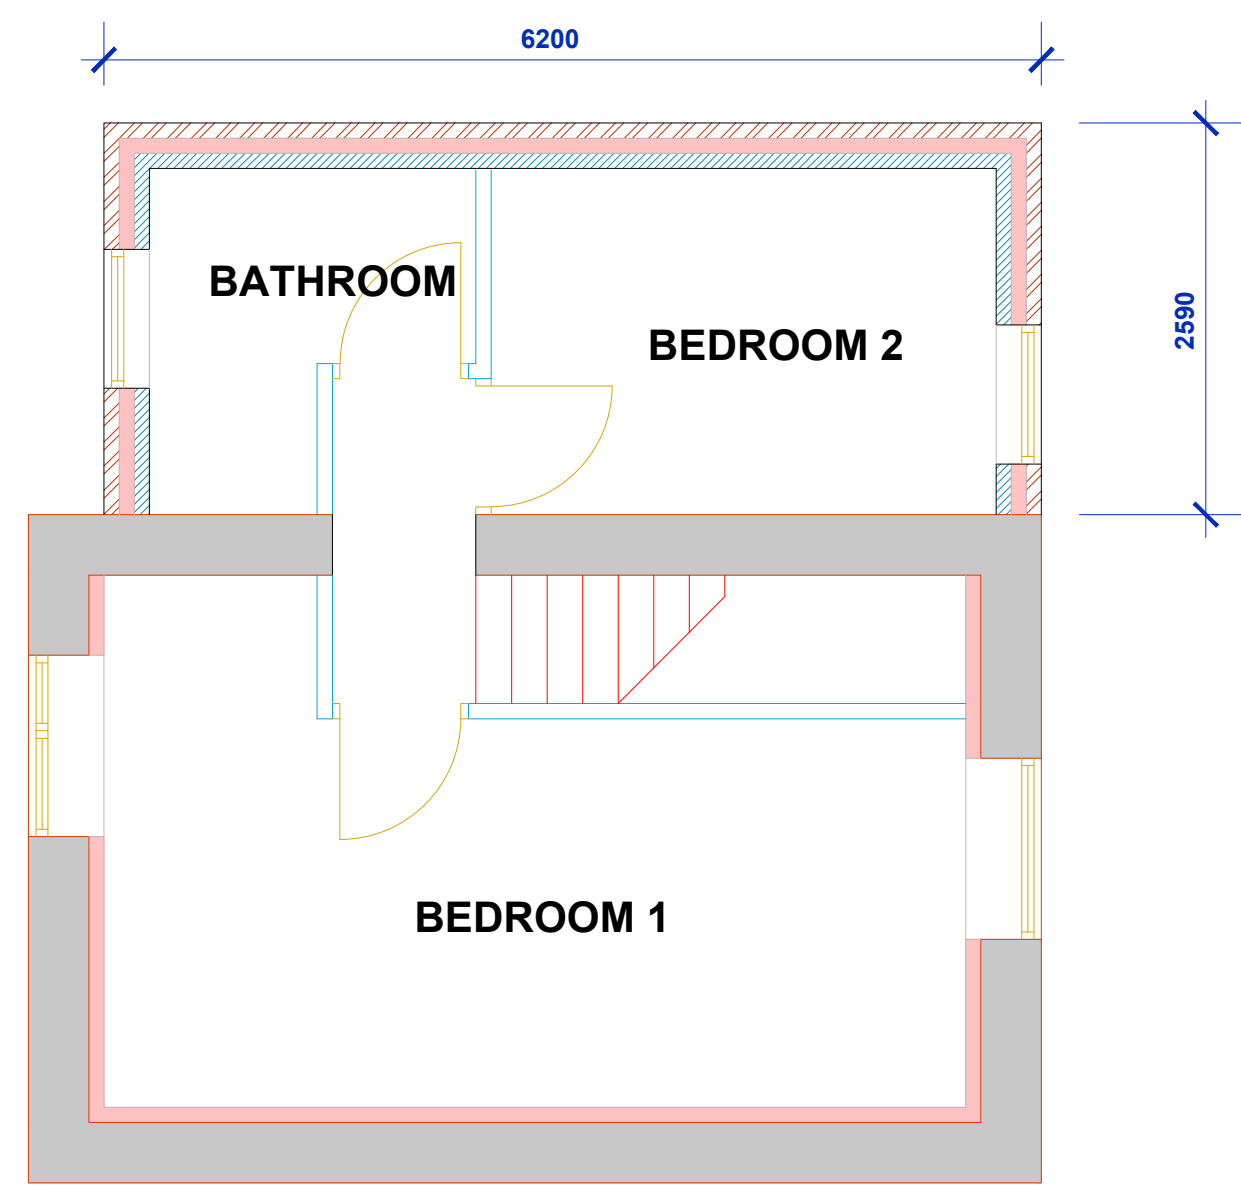

AS BUILT FIRST FLOOR PLAN



AS BUILT FRONT ELEVATION

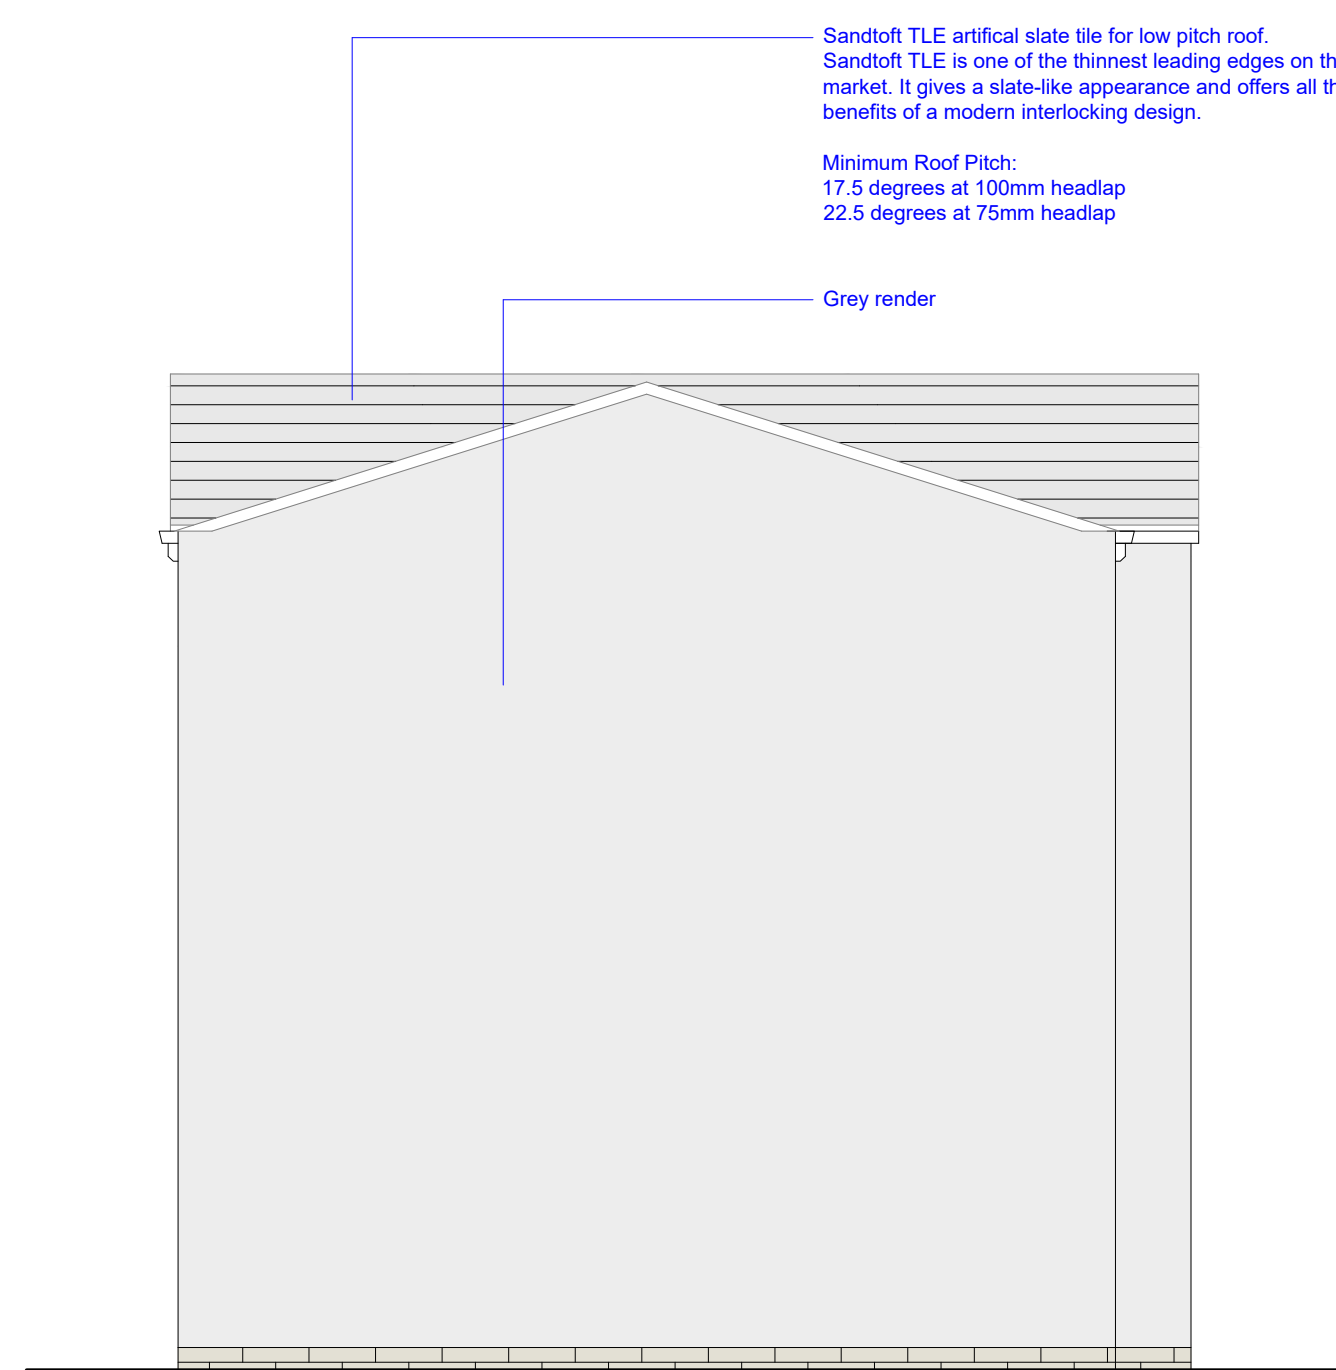

AS BUILT SIDE ELEVATION 1

DRAWING TITLE
AS BUILT DETAILS

JCA JAMES CAMPBELL ASSOCIATES LTD
 CHARTERED ARCHITECTURAL SERVICES
 
 Campbell House 173 Rochdale Road Firgrove Rochdale OL16 3BN
 Tel: 01706 354888 Mob: 07817 623183
 Email: admin@jamescampbellassociates.co.uk Web: www.jamescampbellassociates.co.uk

PROJECT
 RETROSPECTIVE PLANNING - CONVERSION AND EXTENSION OF EXISTING BARN

LOCATION
**Barn to Rear of 767 Market Street
 Market Street
 Whitworth**

DRAWN:- Frank James Smiths **DRAWING NUMBER:-**
DATE:- January 2022
SCALE:- 1:50 @ A1 **22.2792.11**
ISSUE:-