


AS BUILT SHOP FRONT



SHOP FRONTS 2019




SHOP FRONT AS INSTALLED 2023

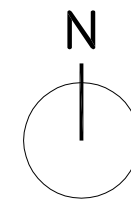

SHOP FRONTS 2013



SHOP FRONT AS INSTALLED 2022

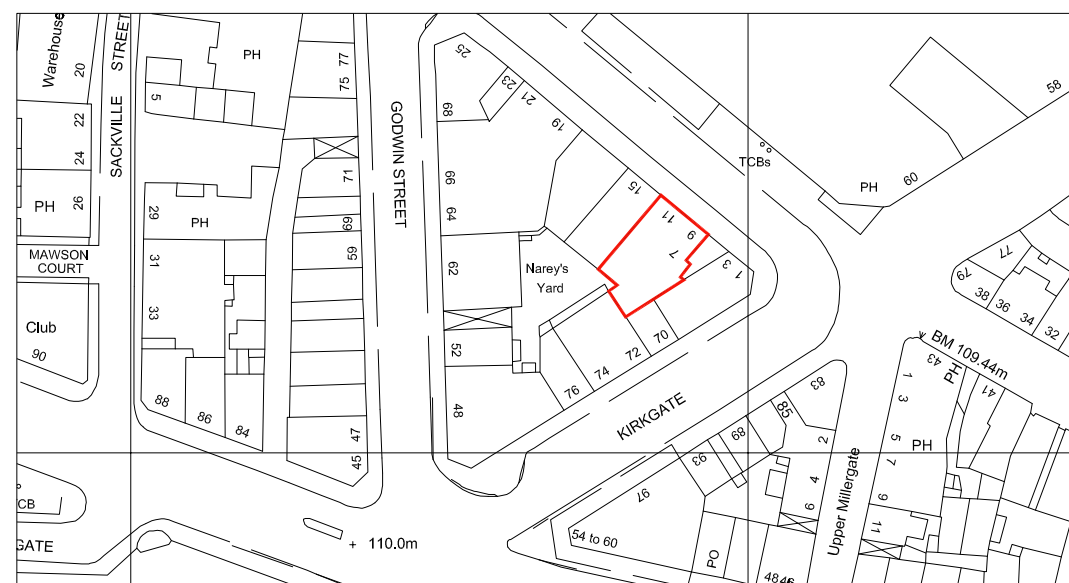

LOCATION PLAN (SCALE 1:1250)

PLANNING		
Date	Revision	Ref
E K D ESKHANZ DESIGN <small>planning design project management</small> 61 Princeville St. Bradford West Yorkshire, BD7 2AG T. 07967 979977		
Project AS INSTALLED SHOP FRONT TO PROPERTY NO 5,9,11 WESTGATE BRADFORD, BD1 2QL		
Title AS BUILT SHOP FRONT ELEVATIONS		
Scale 1:100 @ A3	Drawn	Checked
Date DEC 2023	Status PLANNING	
Drg. No.	23-066-01	Rev.