




CLADDING TO FACE OF PRECAST LEVEL 12-16 (SHOWN IN RED BOX) AT SOUTH WEST/NORTH WEST CORNER IS PROPOSED TO CHANGE FROM TERRACOTTA TO ALUMINIUM. PLEASE REFER TO TYPICAL PLAN DETAIL EBE-STN-ZZ-ZZ-DR-X-031013 AND TYPICAL SECTION DETAIL EBE-STN-ZZ-ZZ-DR-X-0310021


CLADDING TO FACE OF PRECAST LEVEL 01-16 (SHOWN IN RED BOX) AT SOUTH WEST/SOUTH EAST CORNER IS PROPOSED TO CHANGE FROM TERRACOTTA TO ALUMINIUM. PLEASE REFER TO TYPICAL PLAN DETAIL EBE-STN-ZZ-ZZ-DR-X-031002 AND TYPICAL SECTION DETAIL EBE-STN-ZZ-ZZ-DR-X-0310019

SOUTH-WEST ELEVATION

LINKED MODEL SCHEDULE

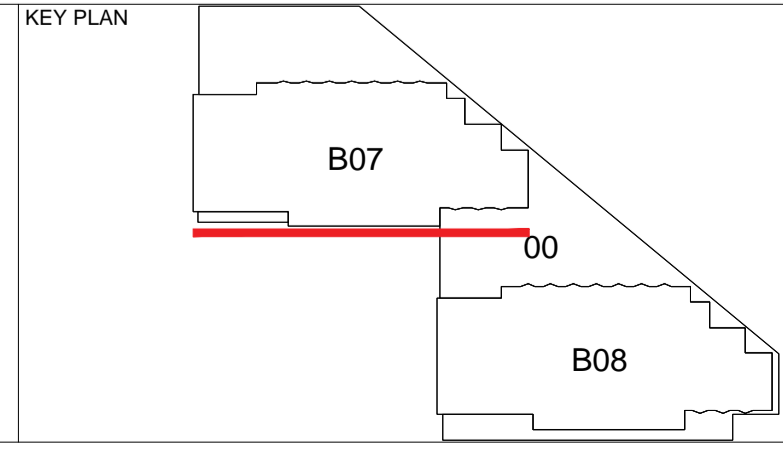

| ALL REVISIONS |     | MAIN CONTRACTOR |  | CLIENT LOGO |                 |
|---------------|-----|-----------------|--|-------------|-----------------|
| STATUS        | REV | DATE            | DESCRIPTION  | DSG         | DRW   CHK   APP |
| S4            | C01 | 21/11/2023      | Precast cladding (corners marked in red boxes) change showing Sotech Aluminium cladding replacing the Terracotta cladding. | SB          | SB   SB   SB    |

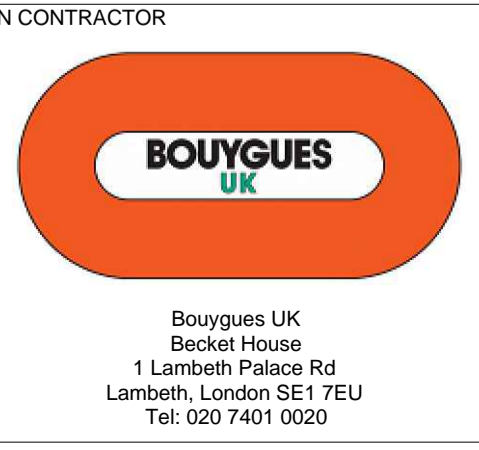

| ORIGINATOR       |            | MODEL FILE NAME - REVISION       |                                  |
|------------------|------------|----------------------------------|----------------------------------|
| SCALE @ A1       | 1:125      | EBE-STN-B07-ZZ-DR-X-005000 - C01 |                                  |
| FIRST ISSUE DATE | 21/11/2023 | PROJECT STAGE                    | Stage 4                          |
|                  |            | STATUS CODE                      | S4 - Suitable for Stage Approval |

| PROJECT NAME          |            | DRAWING TITLE   |       |
|-----------------------|------------|---|-------|
| Ebury Bridge Phase 01 |            | Building B7 - South West Elevation - Proposed Precast Cladding Change From Terracotta to Sotech Aluminium |       |
| PROJECT               | ORIGINATOR | VOLUME  | LEVEL |
| EBE                   | STN        | B07   | ZZ    |
| TYPE                  | ROLE       | NUMBER  | REV   |
| DR                    | X          | 005000  | C01   |