



Notes:

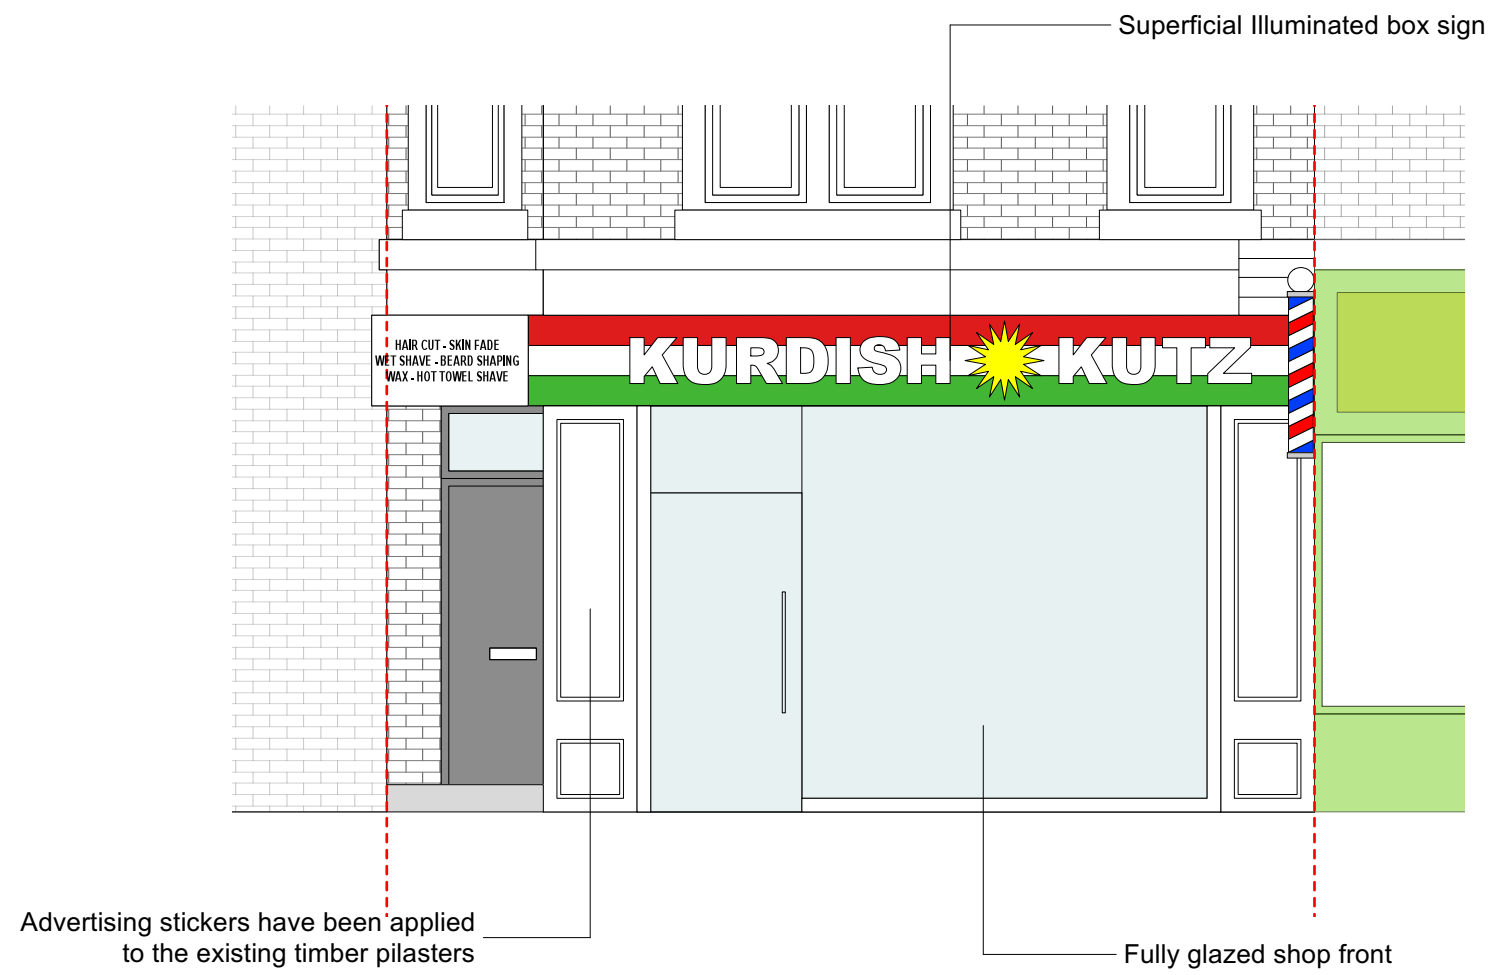

**Front Elevation
South**

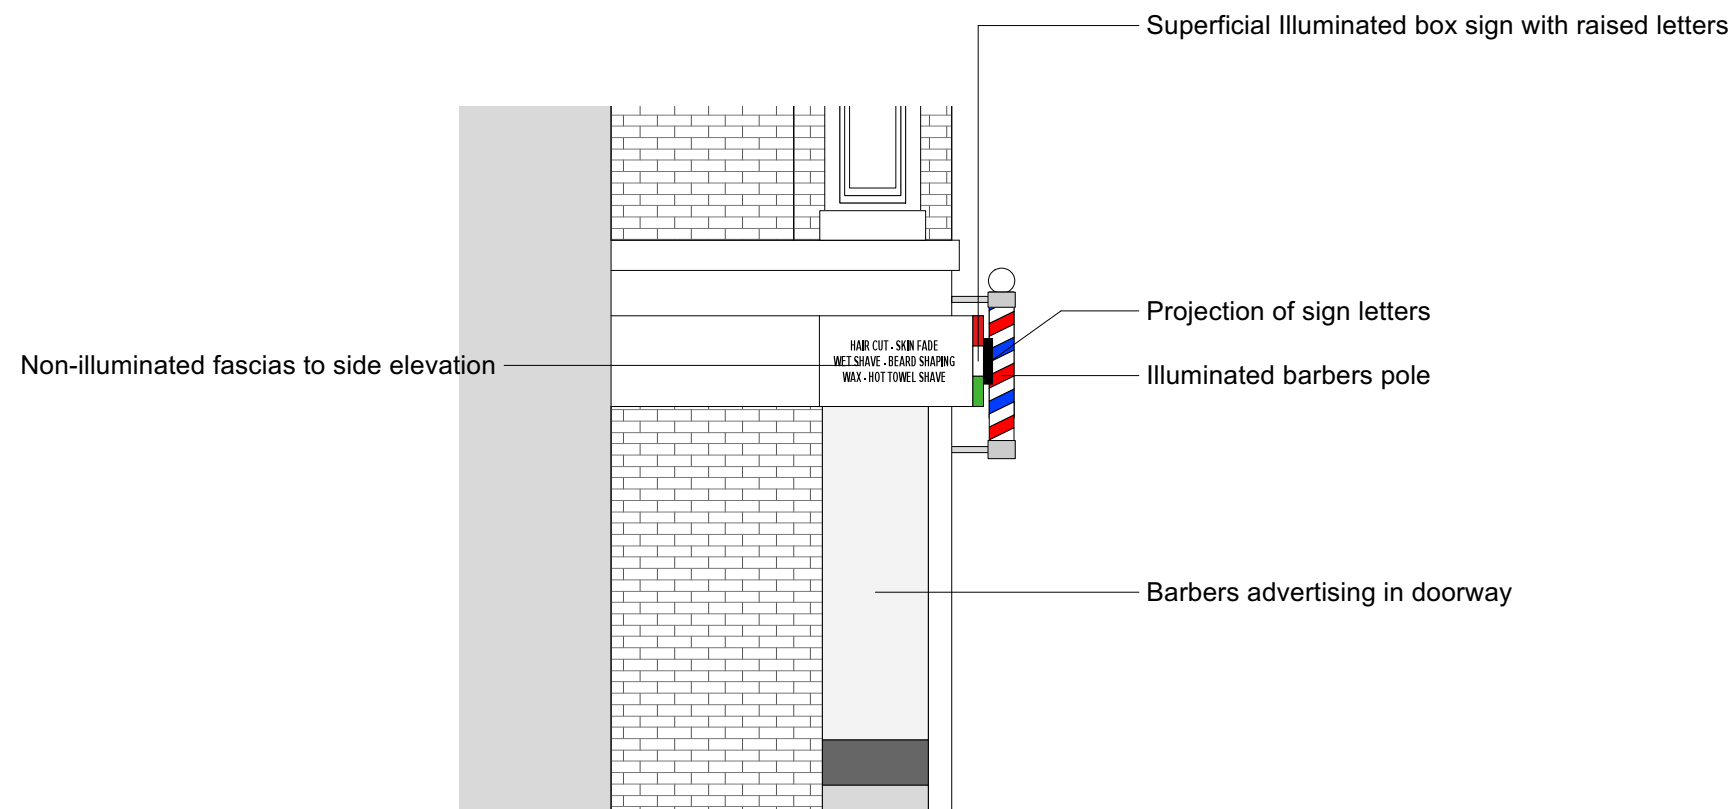

**Side Elevation
West**

title Elevations, as built



date	February 2024	project no.	GA 2402	rev
stage	Planning	sheet no.	002	1

All dimensions are to be checked on site prior to the commencement of work and any discrepancies are to be reported to the principle designer. This drawing is the copyright of Gibson Architecture Limited and may not be reproduced without permission.

Notes:



title Elevations, as previously installed



date	February 2024	project no.	GA 2402	rev
stage	Planning	sheet no.	003	1

All dimensions are to be checked on site prior to the commencement of work and any discrepancies are to be reported to the principle designer. This drawing is the copyright of Gibson Architecture Limited and may not be reproduced without permission.