


Minor re-orientation of ancillary annex permitted under reference 22/P/01436

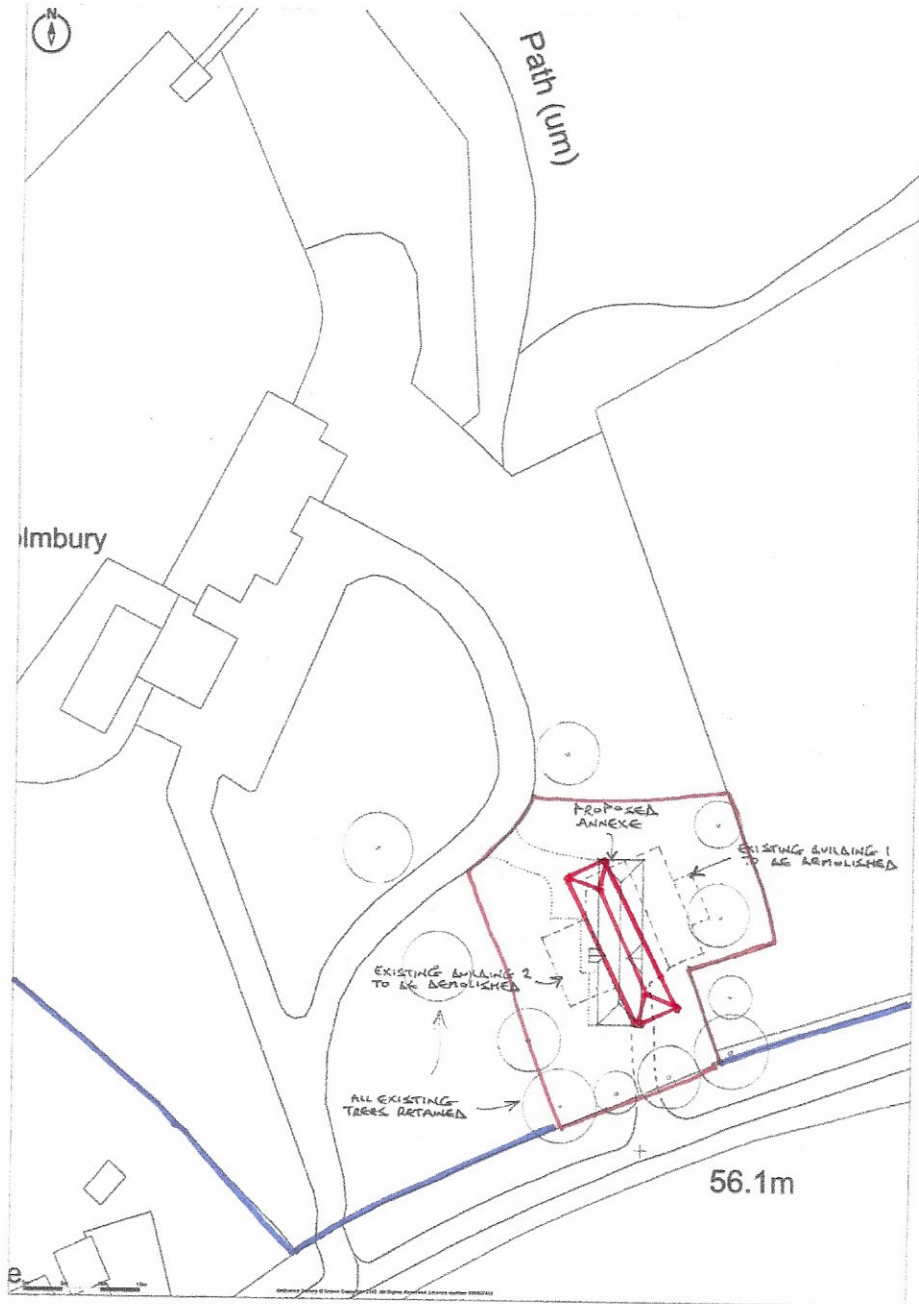

Promap  
© LANDMARK INFORMATION  
Ordnance Survey © Crown Copyright 2021. All Rights Reserved.  
License number 100024252  
Plotted Date - 1.9.2024 Paper Size - A3

DRG. No. 47281/102

Revised Block Plan 1:500

At A4

New orientation shown in red edging