



Do not scale from this drawing. All dimensions to be checked on site prior to manufacture and construction. This drawing is the property of Harrison Ince Holdings Limited and should not be reproduced without permission. All discrepancies to be brought to the attention of the architect immediately. This drawing is to be read in conjunction with the specification / bill of quantities and related drawings.

| REVISIONS |  |            |    |
|-----------|--|------------|----|
| -         | FIRST ISSUE  | 16.04.21   | EV |
| A         | ADDED BAR INFORMATION & EXTRA NOTES                                | 15.10.21   | EV |
| B         | ALLOWED FOR A STAFF WC & CHANGING FACILITY ADJACENT TO THE OFFICE. | 03.11.21   | EV |
| C         | BOTTLE STORE SHOWN   | 20.06.23   | EW |
| D         | CONDENSER LOCATION ALTERED AND BAR DISPENSE ADDED                  | 03.08.23   | EV |
| E         | UPDATED FOLLOWING KDAG   | 22.08.23   | EV |
| F         | CONSTRUCTION ISSUE   | 29.08.23   | EV |
| G         | PLAN UPDATED FOLLOWING SITE MEETING                                | 12.09.23   | EV |
| H         | PLANS UPDATED FOLLOWING REVISION FROM LLOYDS CATERING              | 13.09.23   | EV |
| J         | AS BUILT FOR PLANNING  | 20.09.2023 | EV |
|           |  | 07.02.2024 | CG |

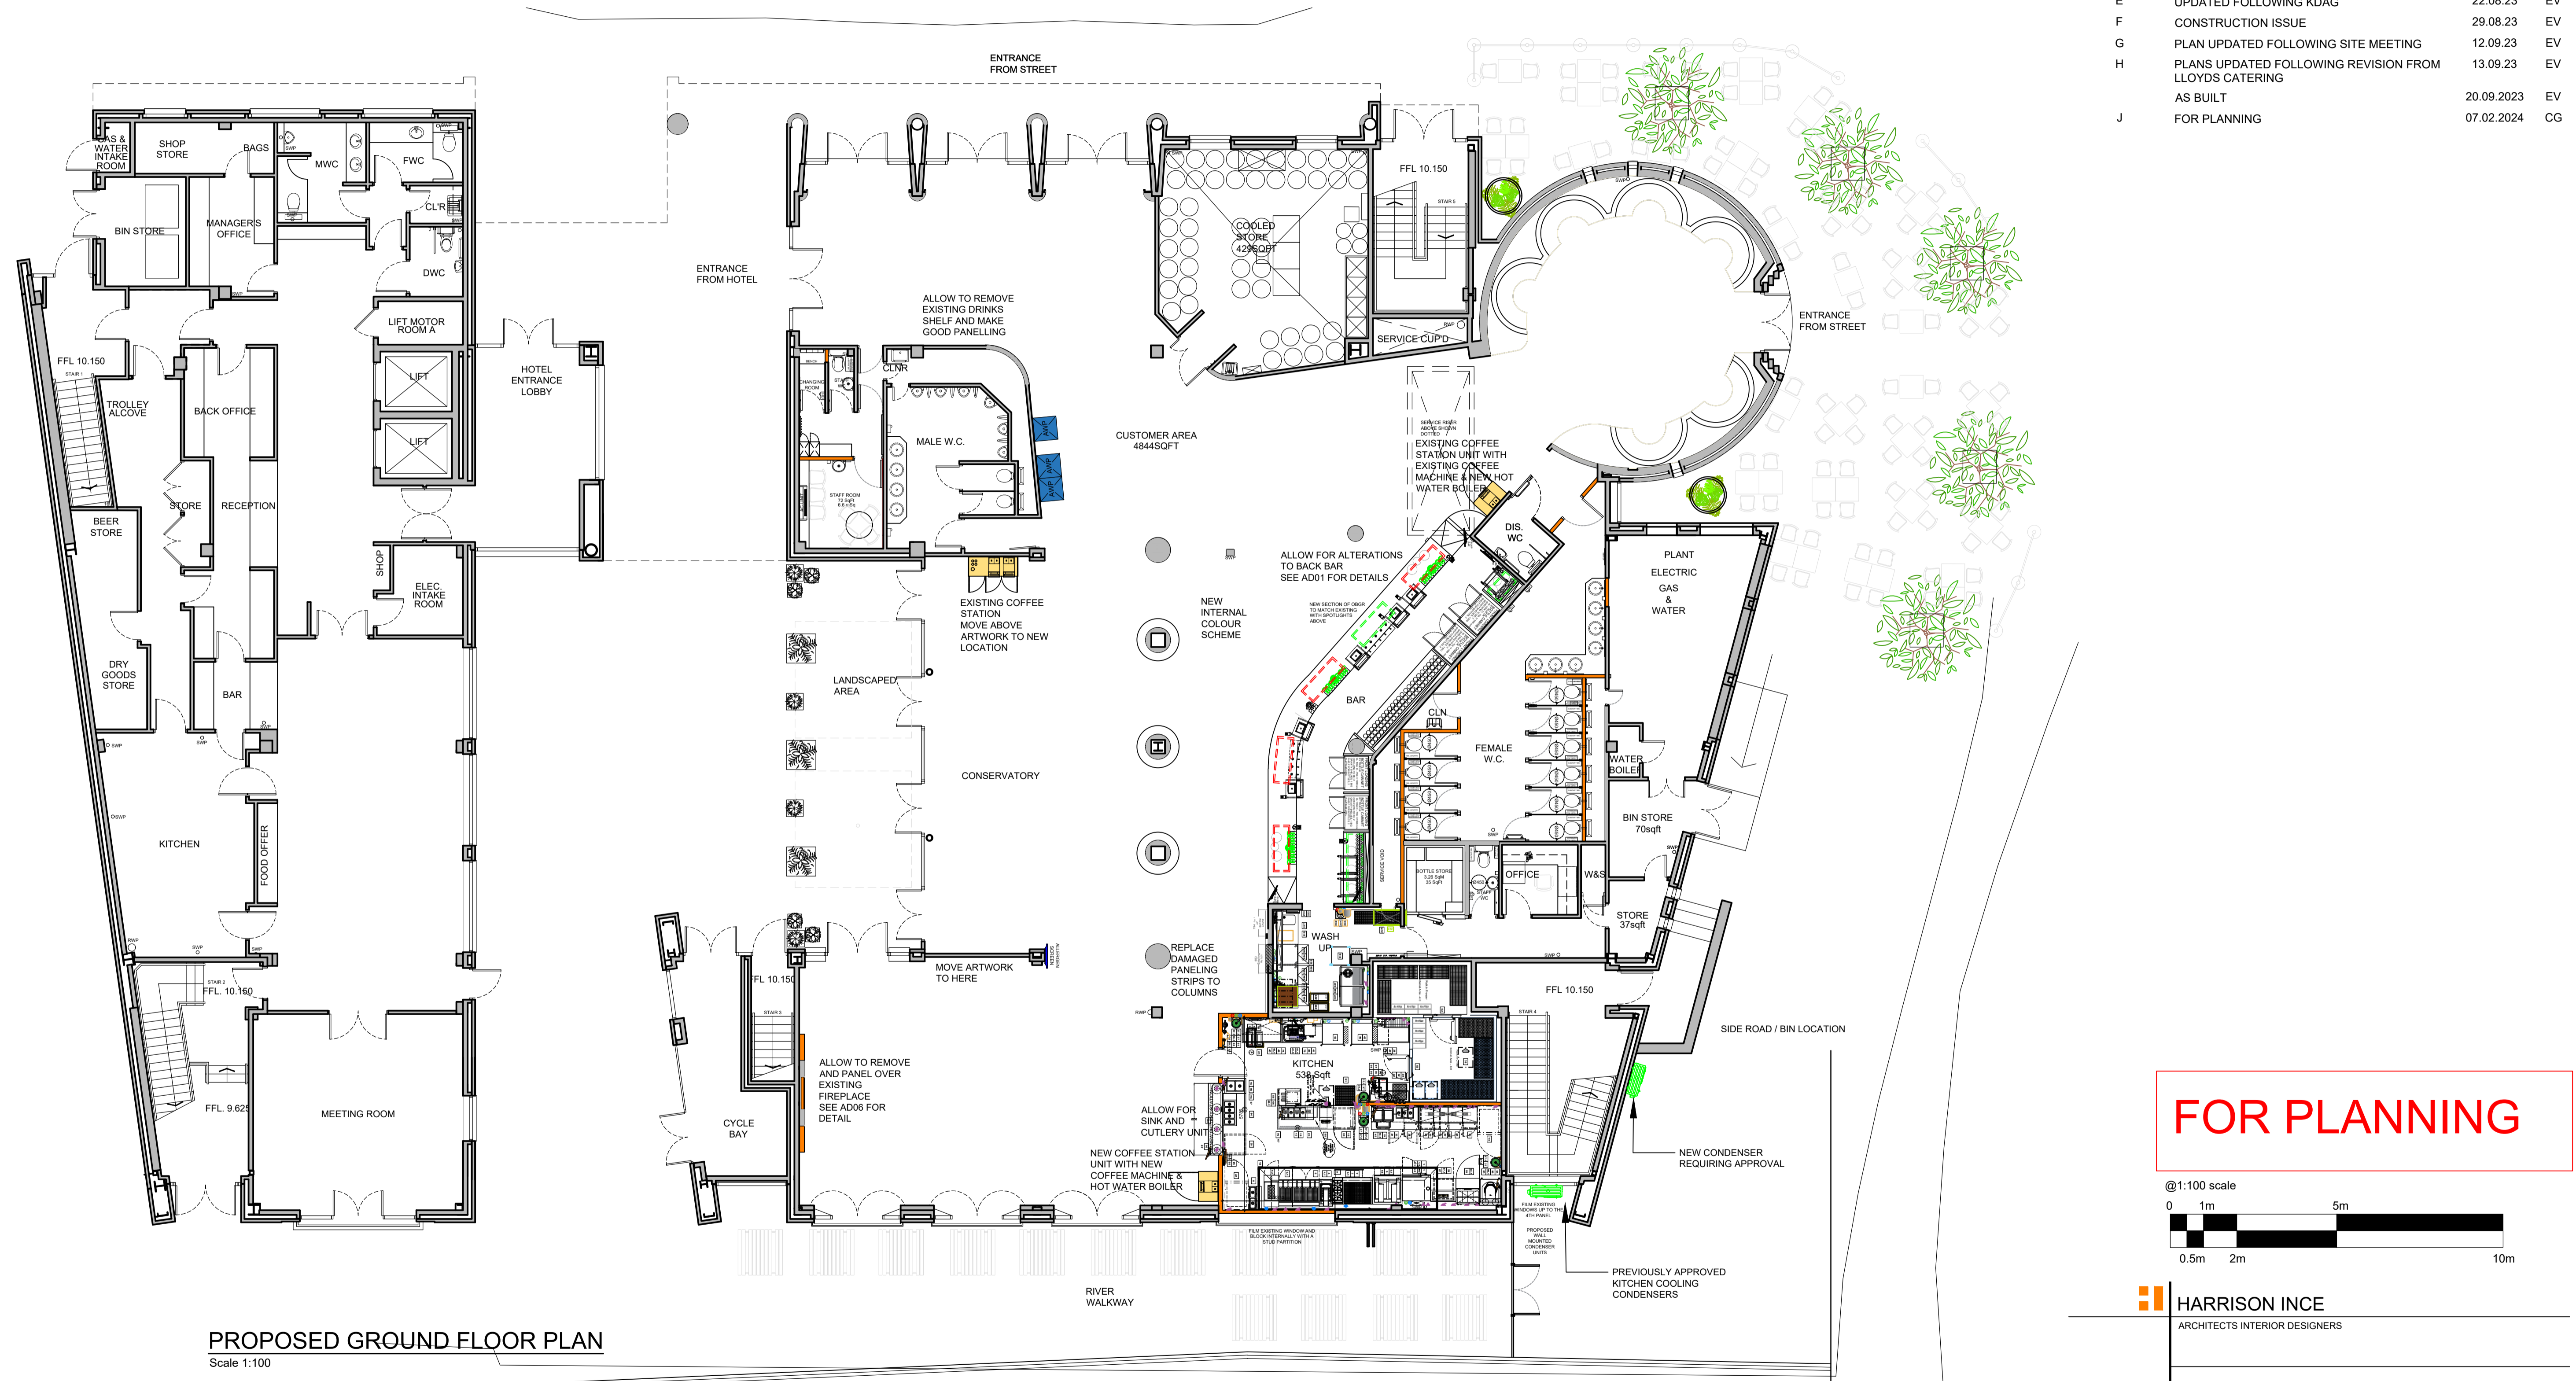

**PROPOSED GROUND FLOOR PLAN**  
Scale 1:100

**FOR PLANNING**

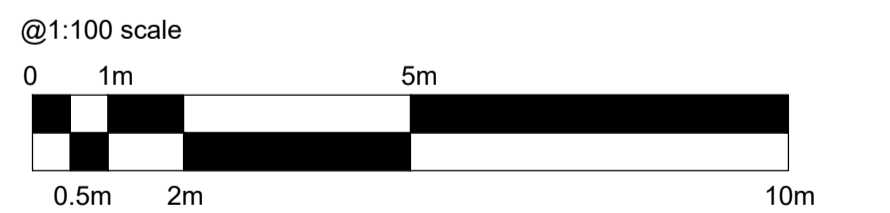

**HARRISON INCE**  
ARCHITECTS INTERIOR DESIGNERS

CLIENT: **JD WETHERSPOON**

PROJECT: **THE POSTERN GATE,  
90 PICCADILLY, YORK, YO1 9NX**

TITLE: **PROPOSED GROUND FLOOR PLAN**

DATE: **MARCH 2021** SCALE: **1:100 @ A1**

JOB NO: **PN1845-10** DWG NO: **AL01-J**

DRAWN: **CAD/EV** CHECKED:

SUN HOUSE  
24 LITTLE PETER STREET  
KNOTT MILL  
MANCHESTER  
M15 4PS  
TEL: 0161 236 3650  
EMAIL: enquiries@harrison-ince.co.uk