



Do not scale from this drawing. All dimensions to be checked on site prior to manufacture and construction. This drawing is the property of Harrison Ince Holdings Limited and should not be reproduced without permission. All discrepancies to be brought to the attention of the architect immediately. This drawing is to be read in conjunction with the specification / bill of quantities and related drawings.

REVISIONS			
-	FIRST ISSUE	13.12.2021	EW
A	UPDATED PLAN	03.08.2023	EV
B	CONSTRUCTION ISSUE	29.08.2023	EV
C	AS BUILT	20.09.2023	EV
D	CONDENSER LOCATION UPDATED	01.11.2023	EV
E	FOR PLANNING	07.02.2024	CG

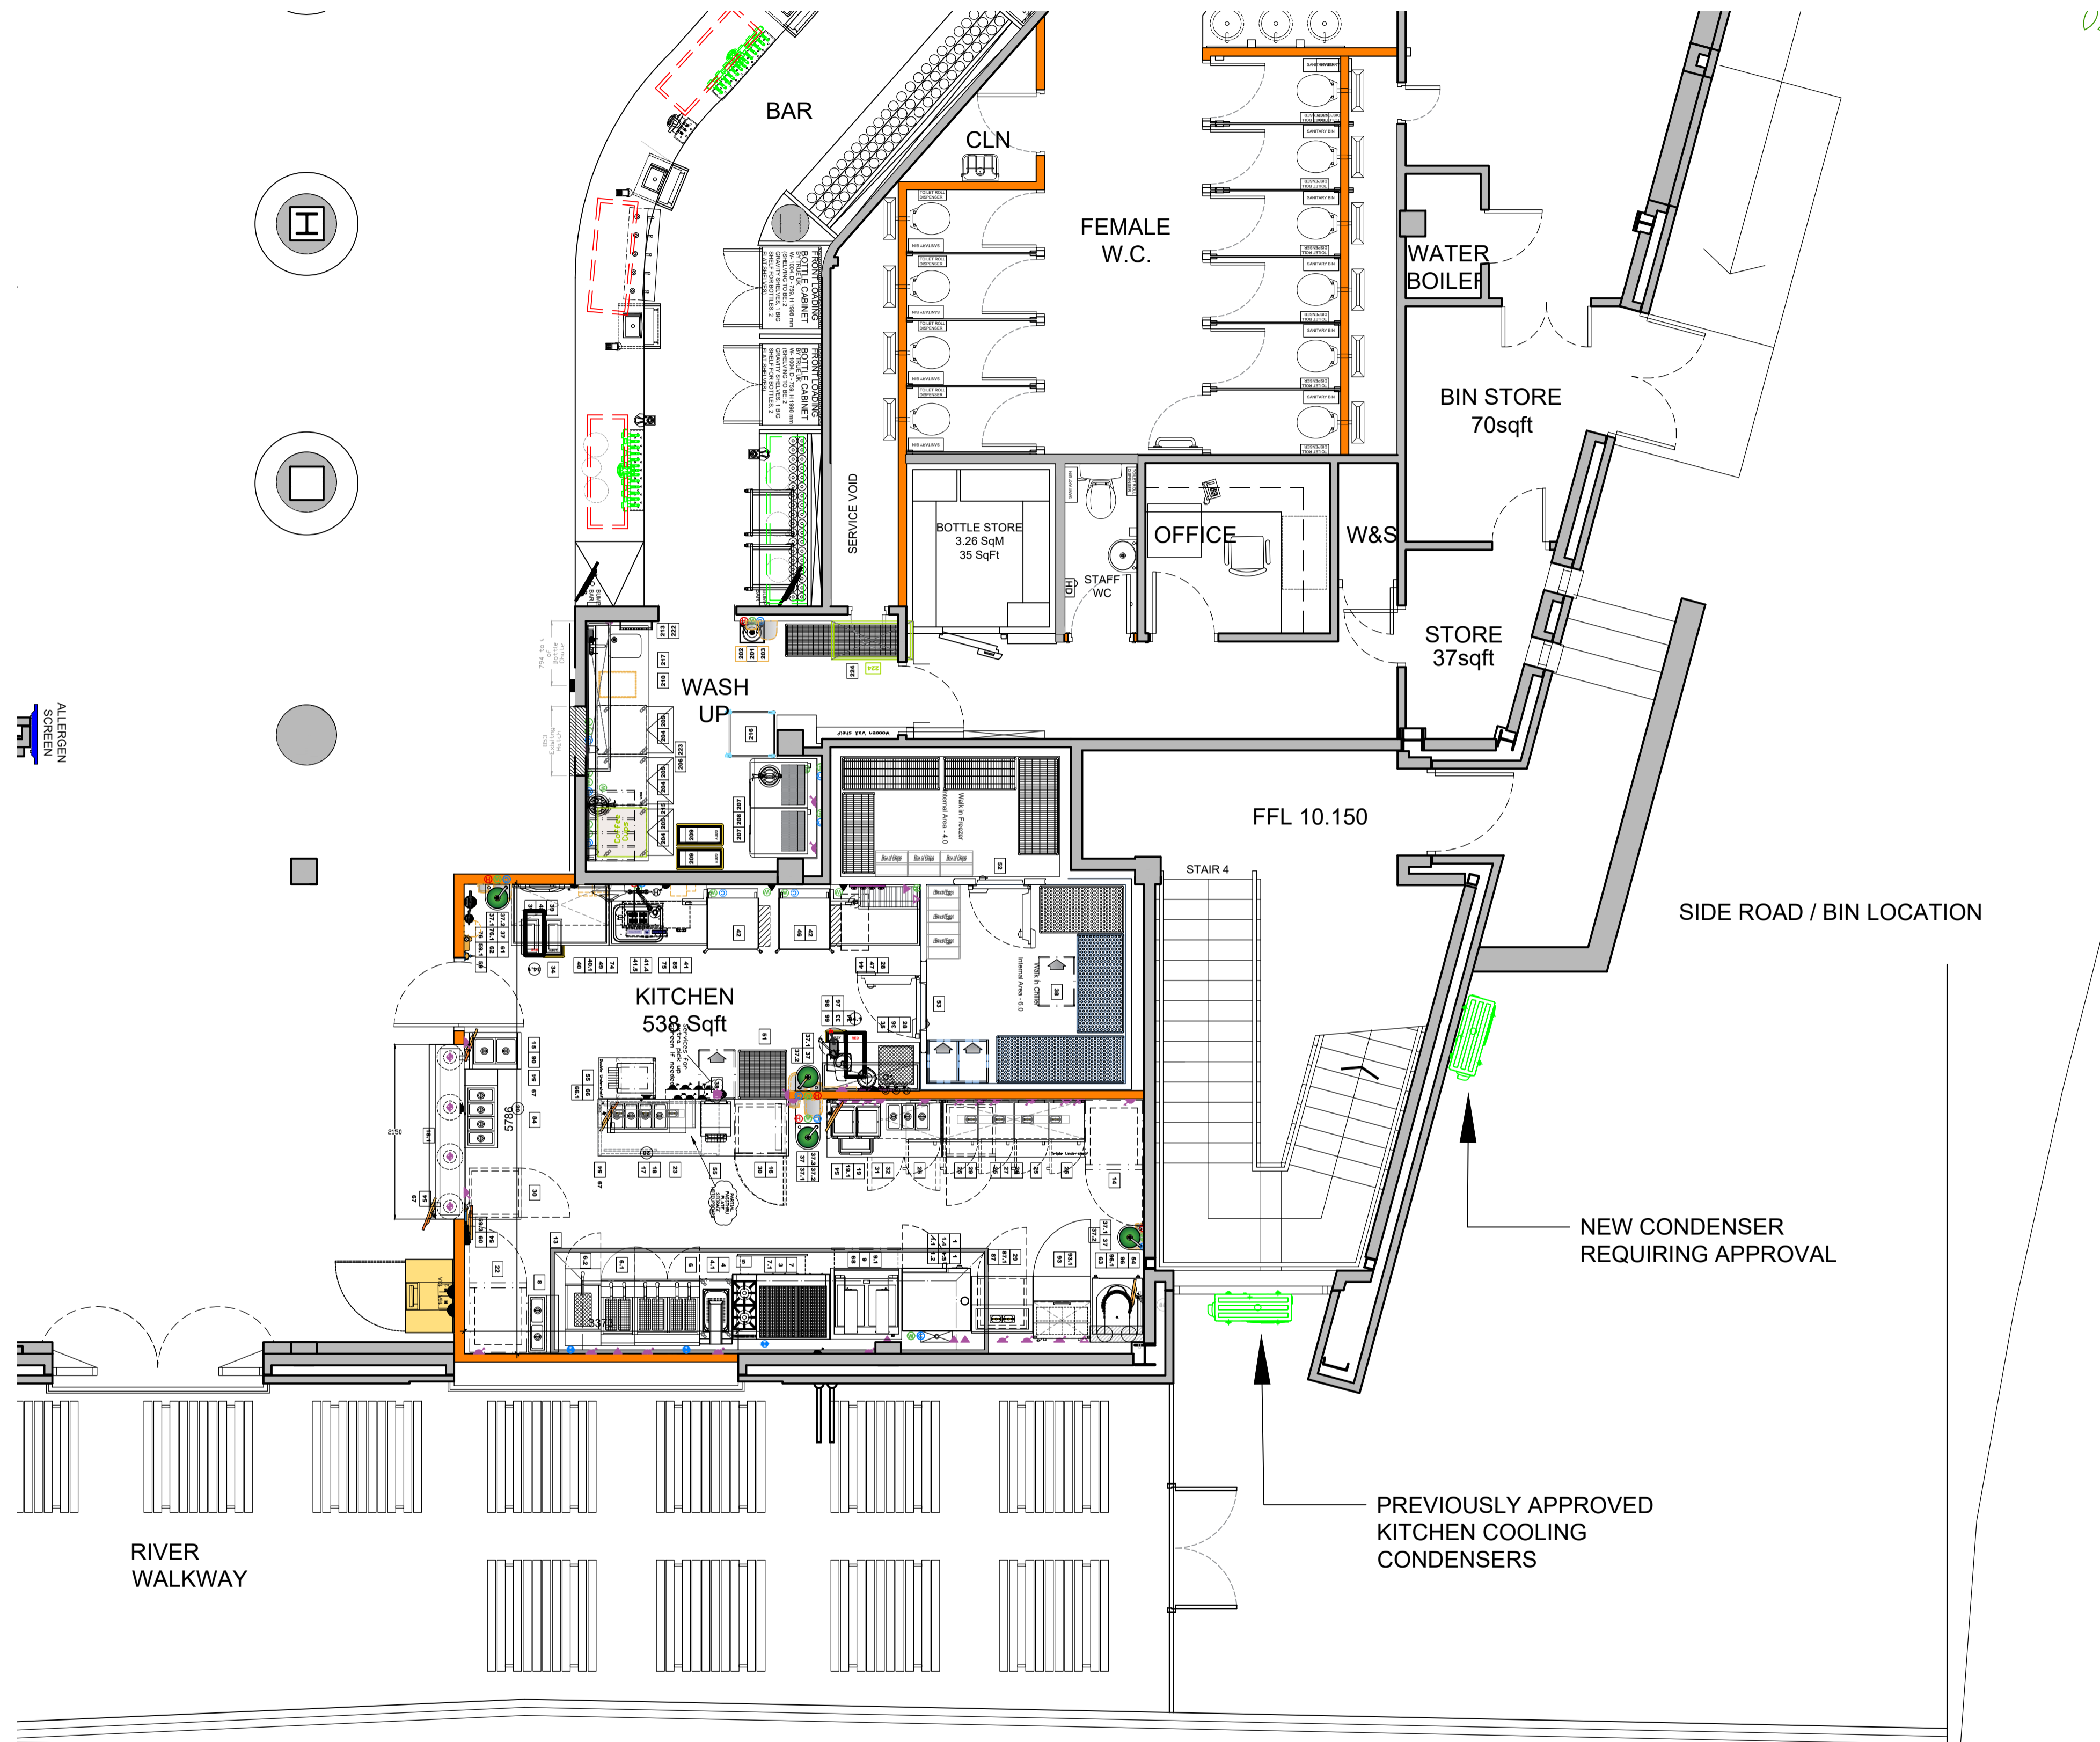

PROPOSED GROUND FLOOR PLAN (CONDENSERS)
Scale 1:50

FOR PLANNING

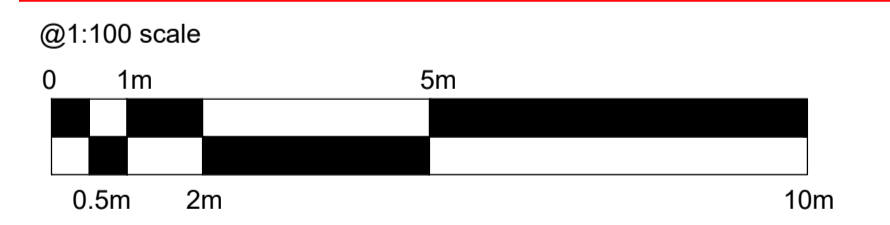

HARRISON INCE	
ARCHITECTS INTERIOR DESIGNERS	
CLIENT JD WETHERSPOON PLC	
PROJECT THE POSTERN GATE 90 PICCADILLY, YORK, YO1 9NX	
TITLE PROPOSED GROUND FLOOR PLAN NEW CONDENSERS	
DATE DECEMBER 2021	SCALE 1:50 @ A1
JOB NO. PN1845-10	DWG NO. AL12-E
DRAWN CAD/EW	CHECKED

SUN HOUSE
2-4 LITTLE PETER STREET
KNOTT MILL
MANCHESTER
M15 4PS
TEL: 0161 236 3650
EMAIL: enquiries@harrison-ince.co.uk