


Approved LGFL Plan
1 : 100

APPROVAL NO. 22/04364/FUL
Dated 08/08/2023

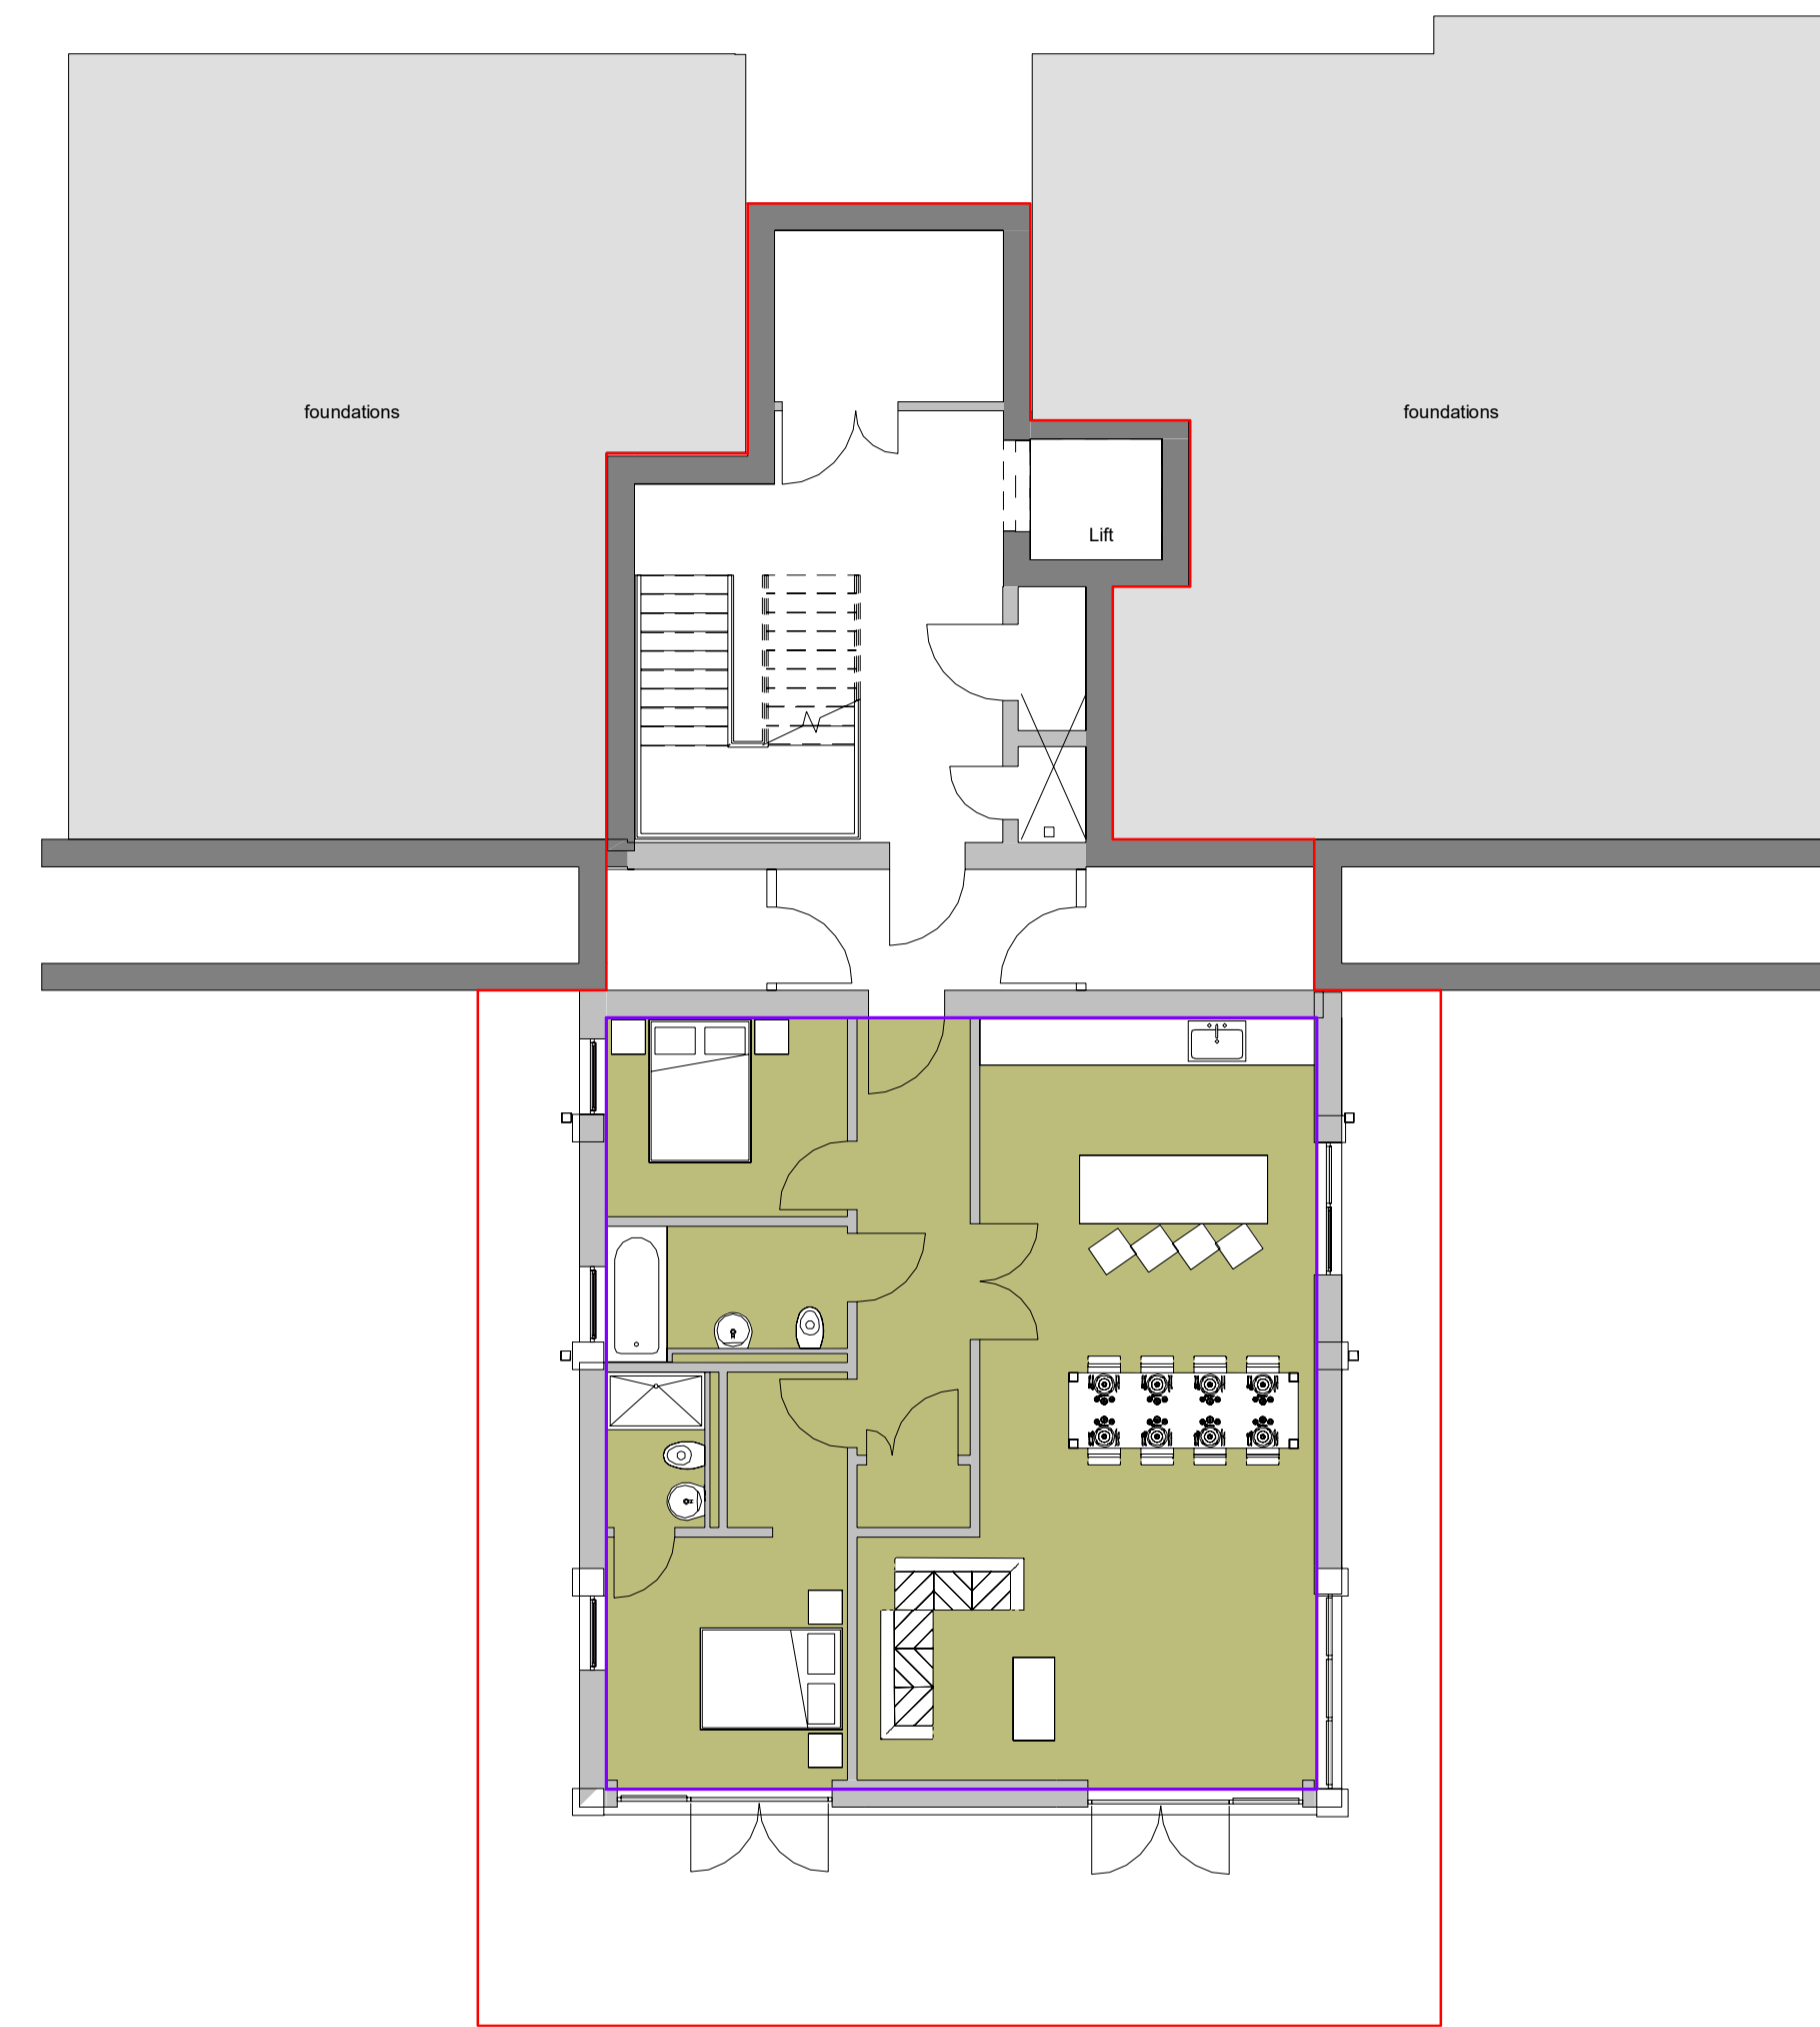

Proposed New LGFL Plan
1 : 100

P2	Client adjustments	17.10.23	RB	CB
P1	Red line added	12.10.23	RB	CB
	Revision	Date	By	Chk

All dimensions to be verified on site, and the Architect informed of any discrepancy. All drawings and specifications should be read in conjunction with the Health and Safety Plan, all conflicts should be reported to the appointed Principal Designer.



Bankhead Group
Residential Development
Clifford Road, Ilkley

Sheet Name: Approved & Proposed LGFL Plan

Purpose of issue: Planning Status:

Date: 09/28/23 Checked by: CB

Drawn by: RAB Scale @ A1: 1 : 100

Project No: 8594 Revision: P2

Drawing No : 8594-BOW-A-2021

