
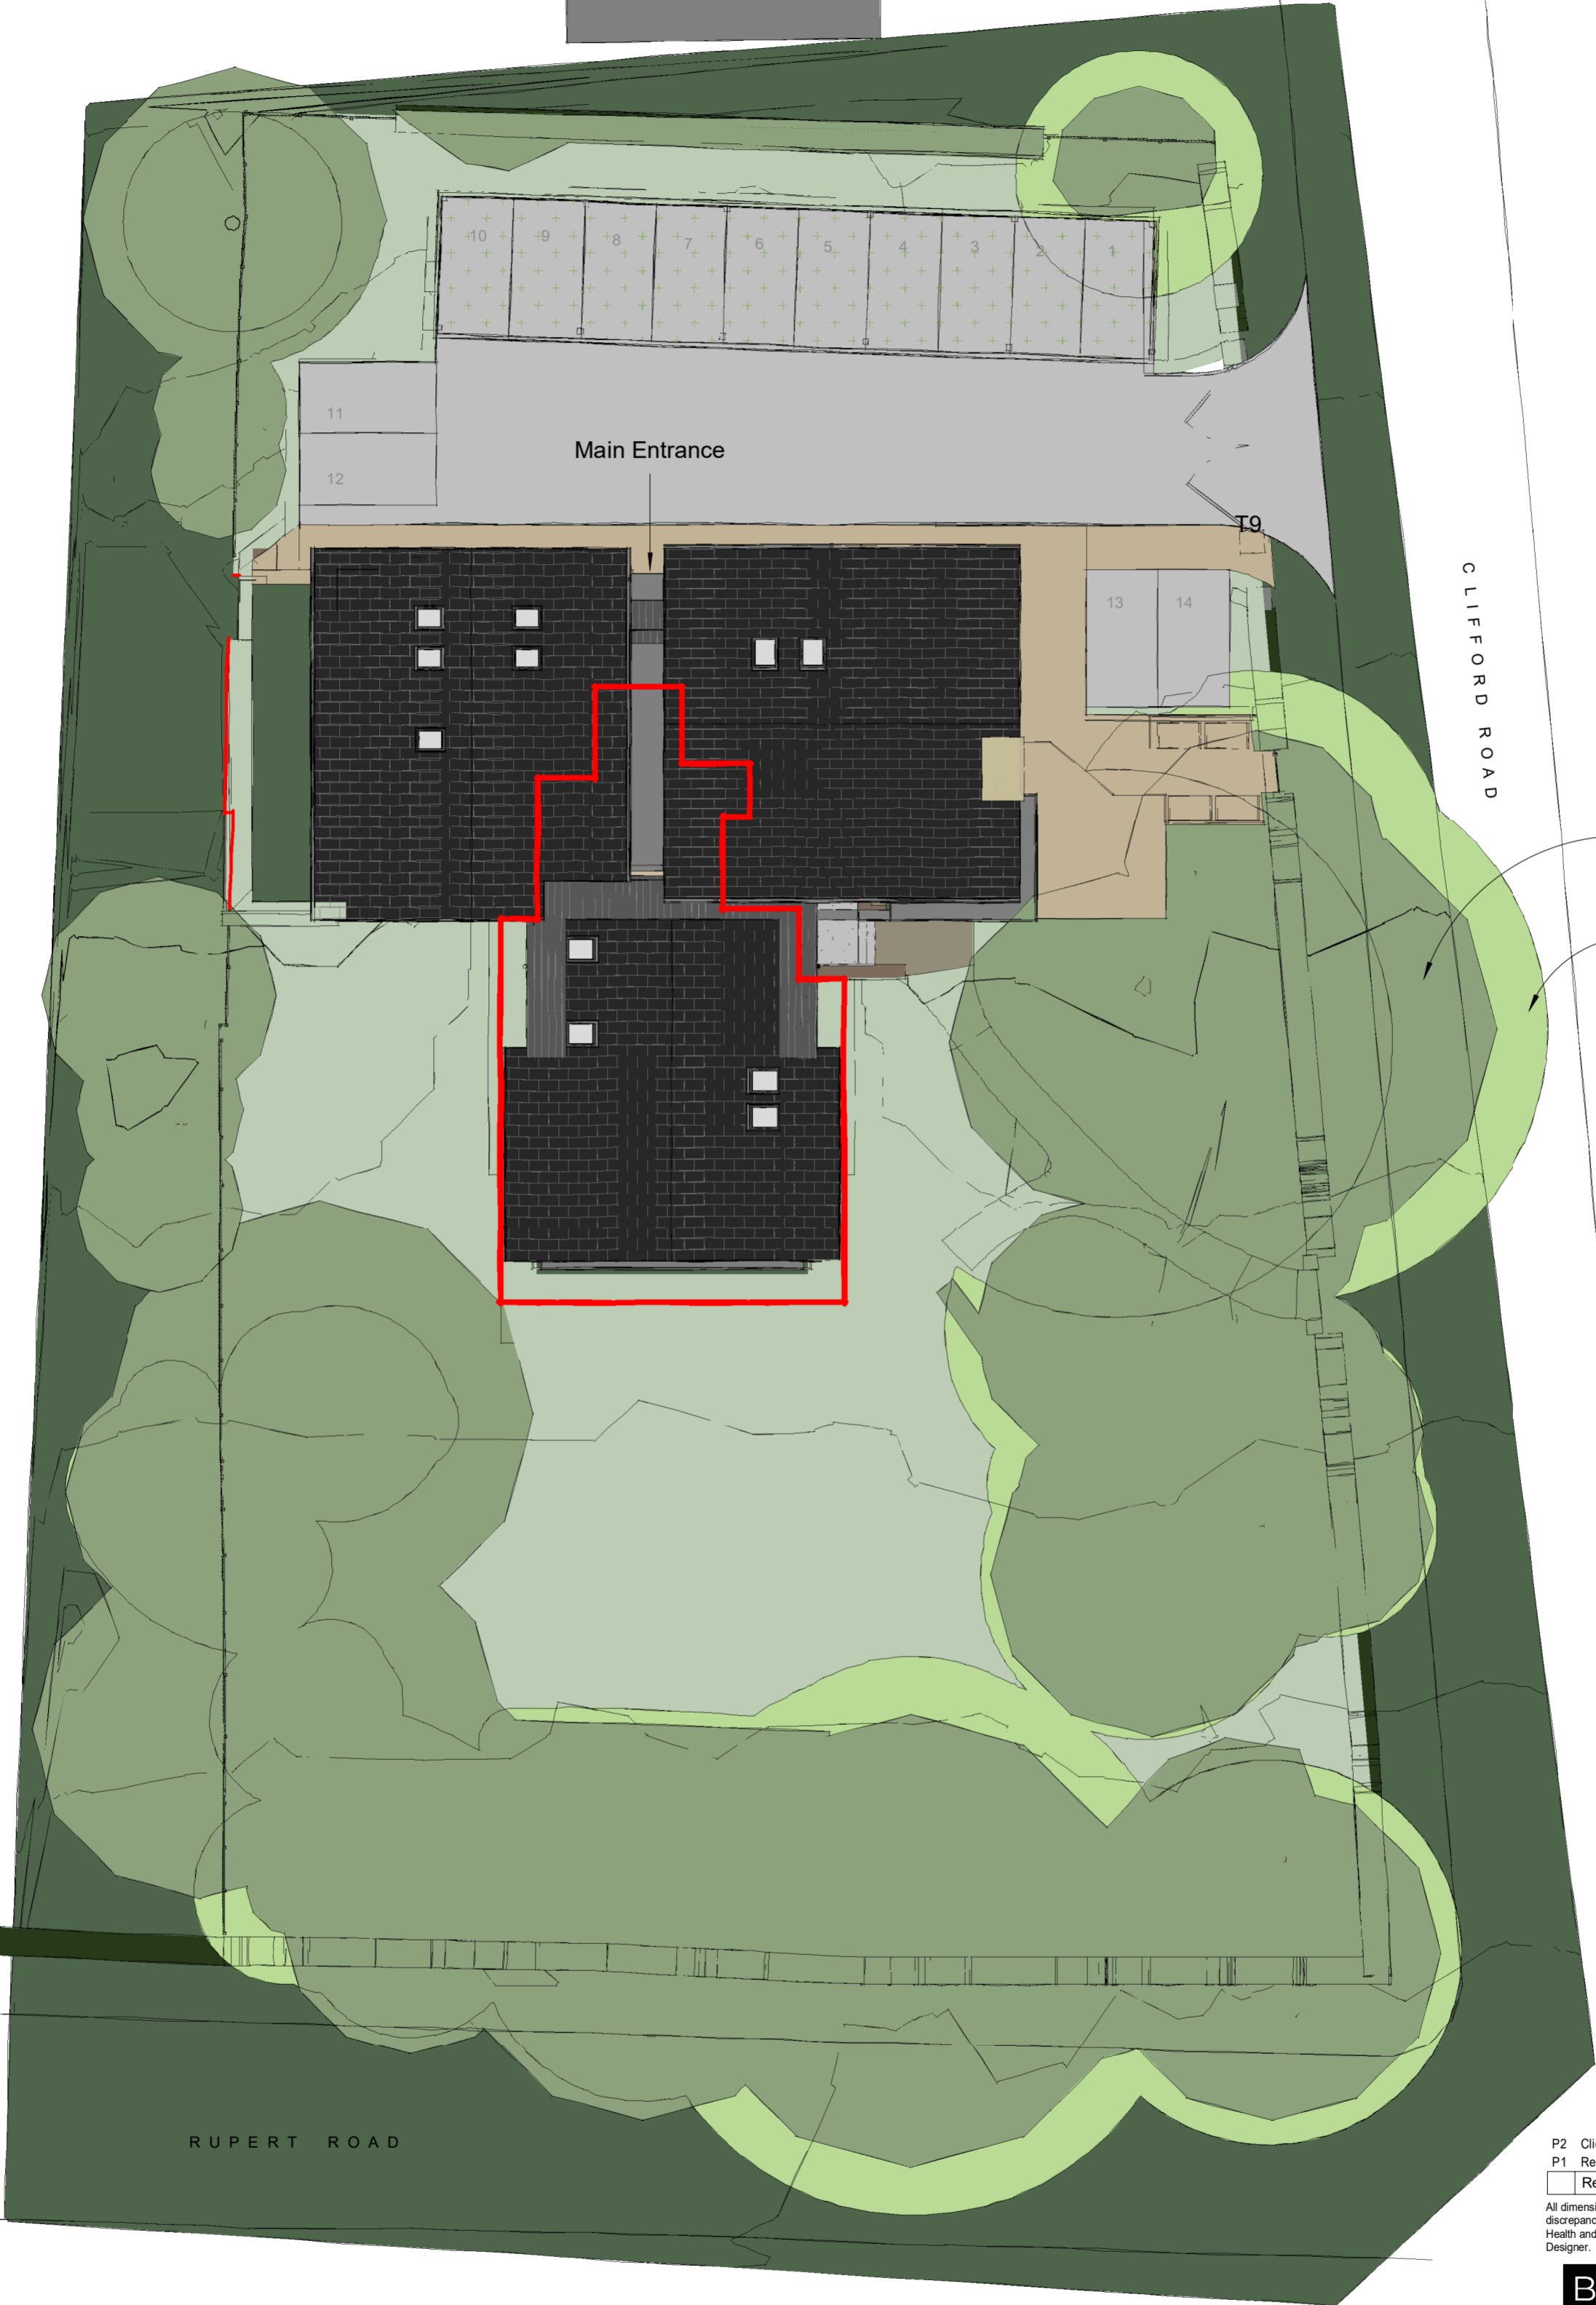



NEIGHBOURING PROPERTY
25 CLIFFORD ROAD

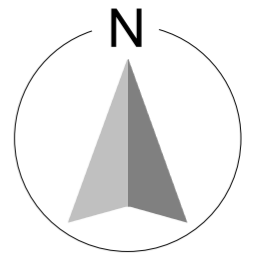

CLIFFORD ROAD

Root protection zones dark green- see arboricultural report
Extent of tree canopy light green

NEIGHBOURING PROPERTY
RUPERT ROAD

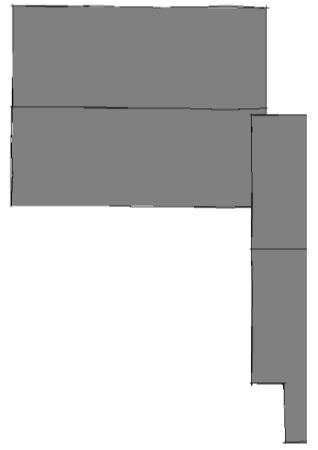

ROYD LODGE

RUPERT ROAD

P2	Client adjustment	17.10.23	RB	CB
P1	Red line Areas shown	12.10.23	RB	CB
Revision	Date	By	Chk	

All dimensions to be verified on site, and the Architect informed of any discrepancy. All drawings and specifications should be read in conjunction with the Health and Safety Plan; all conflicts should be reported to the appointed Principal Designer.



Site Plan Consented
1 : 200

Bankhead Group
Robin Hill Clifford Rd Ilkley
Project Address

Sheet Name: Approved Site Plan

Purpose of issue: Planning Status:

Date: 09/27/23 Checked by: CB
Drawn by: RAB Scale @ A2: 1 : 200

Project No: 8594 Revision: P2
Drawing No: 8594-BOW-A-2015

APPROVAL REF: 22/04364/FUL
Date: 08/08/2023



Do not scale from this drawing. This drawing is the copyright of Bowman Riley Architects Limited. © P:\Architectural\Residential\8594 - Clifford Road, Ilkley\8594 - 01 Revit\8594-BOW-A-2015-0001_Site_Hybrid Option 4.rvt