




Approved South Elevation  
1 : 100

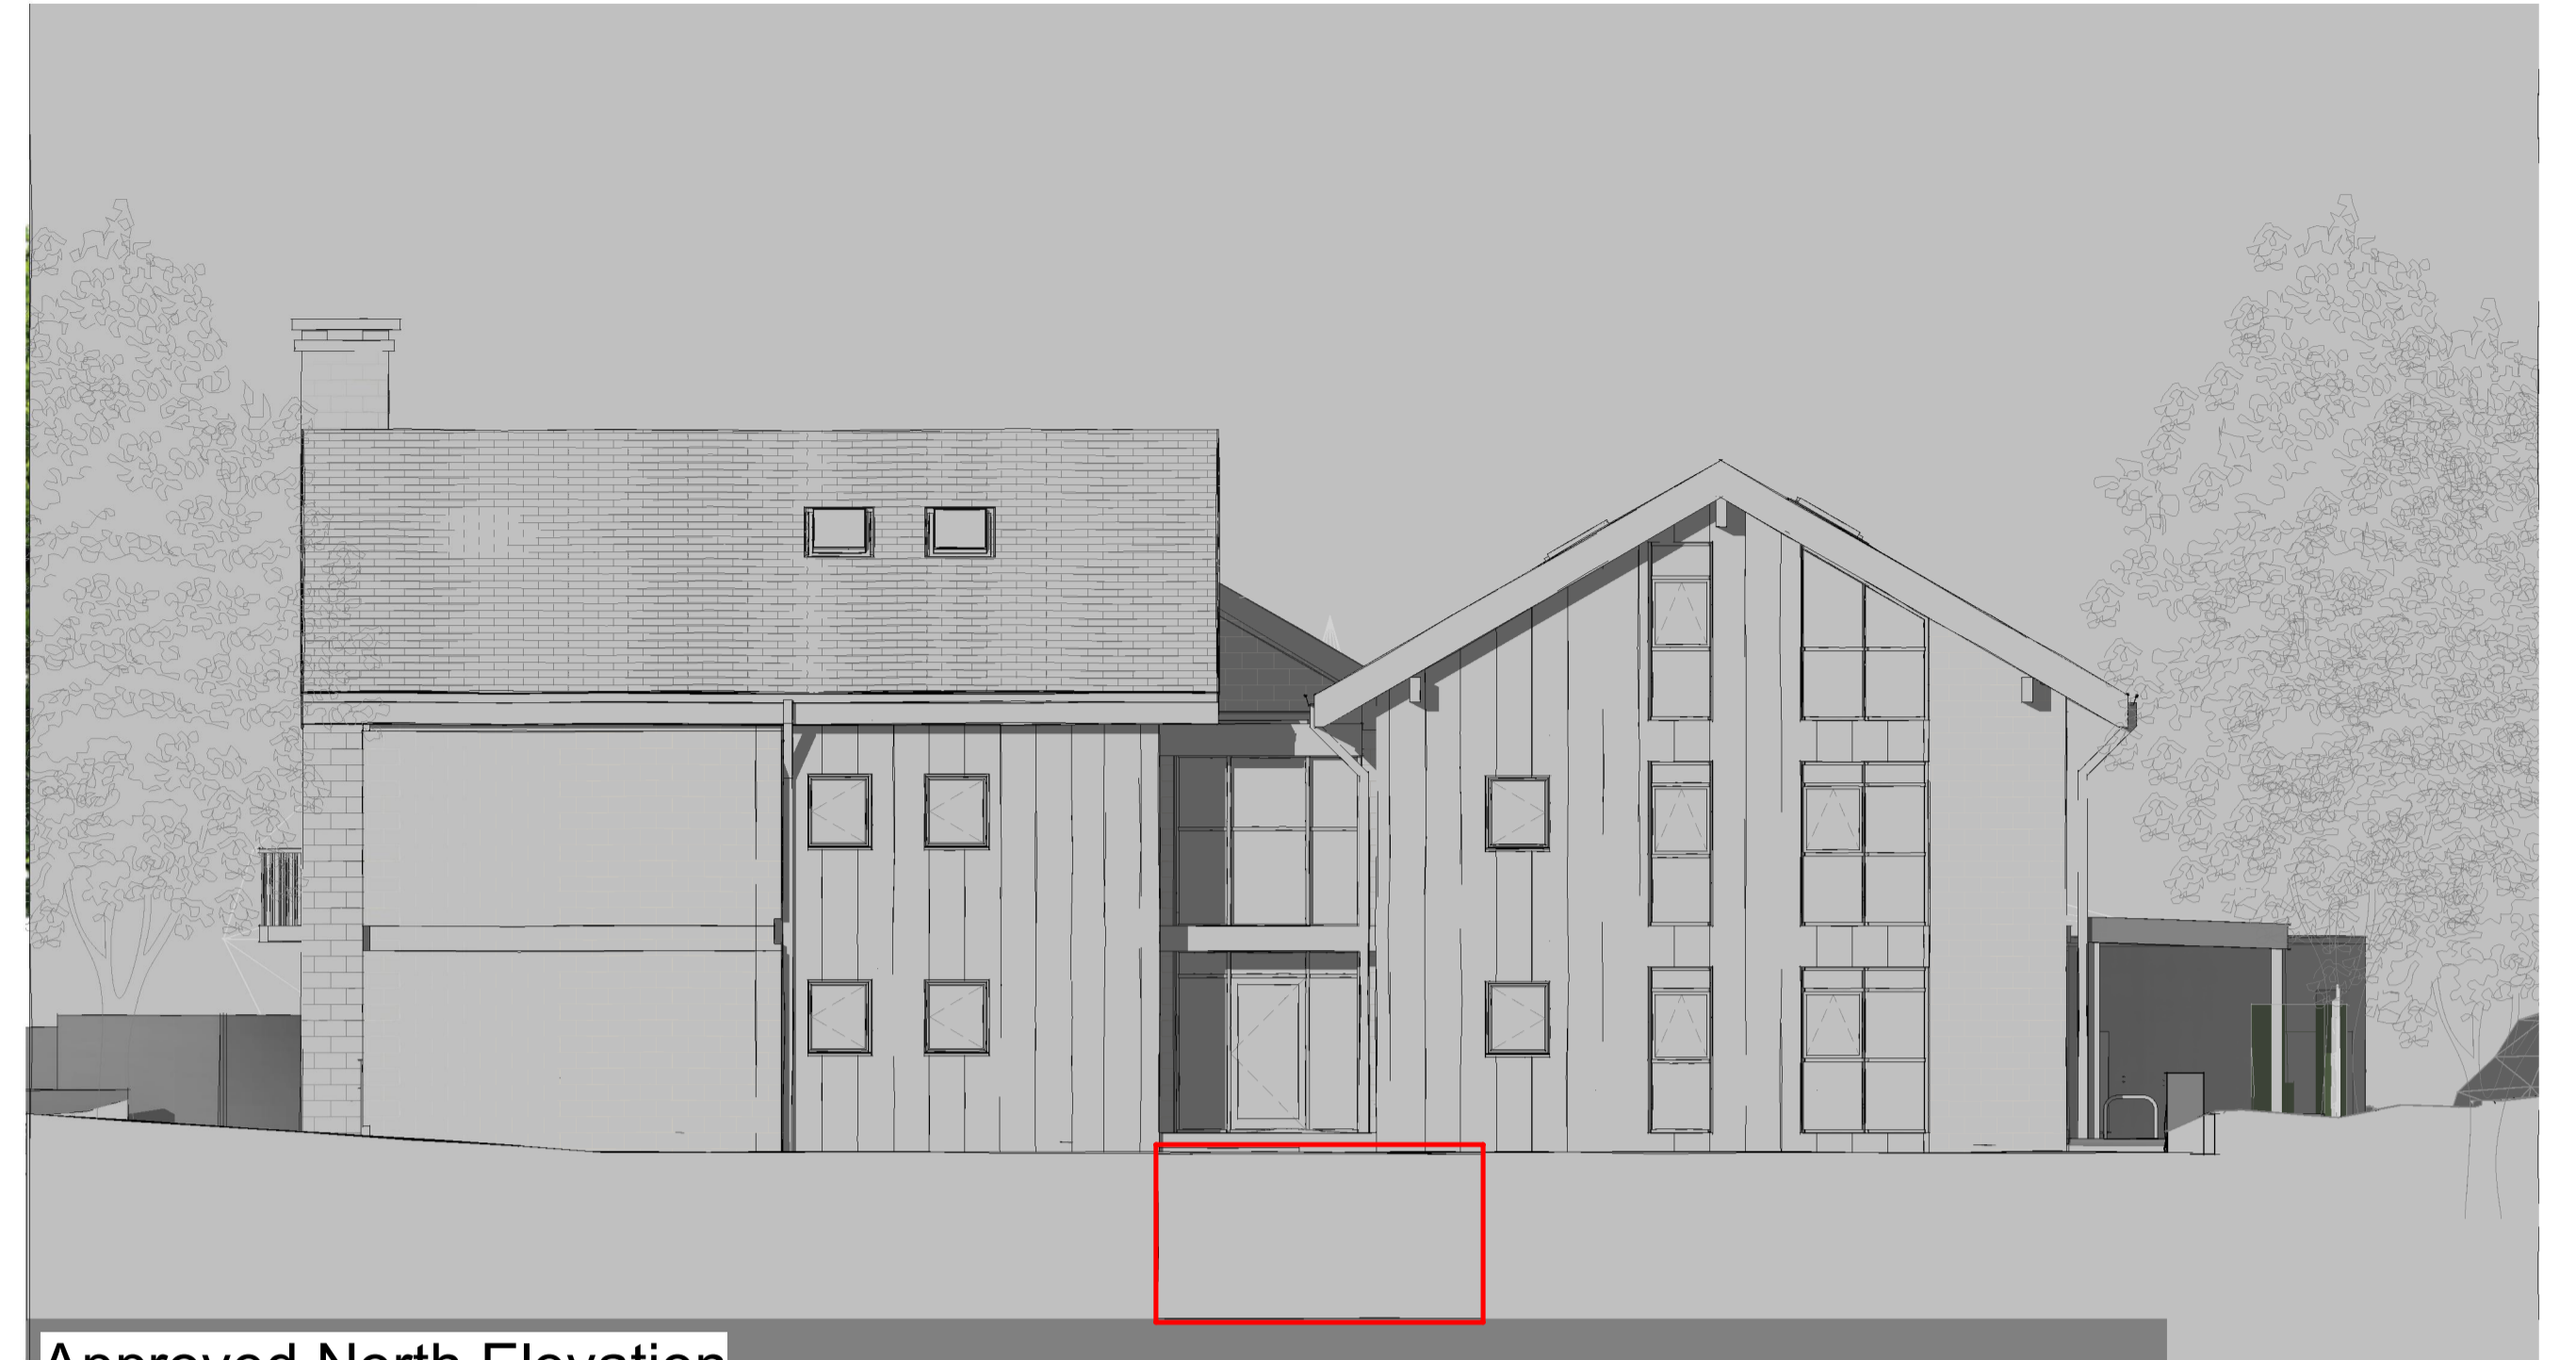

Approved North Elevation  
1 : 100



Approved West Elevation  
1 : 100



Approved East Elevation  
1 : 100

**APPROVAL NOTICE 22/04364/FUL**  
**Dated 08/08/2023**

|    |                      |          |    |     |
|----|----------------------|----------|----|-----|
| P2 | Client adjustment    | 17.10.23 | RB | CB  |
| P1 | Red line Areas shown | 12.10.23 | RB | CB  |
|    | Revision             | Date     | By | Chk |

All dimensions to be verified on site, and the Architect informed of any discrepancy. All drawings and specifications should be read in conjunction with the Health and Safety Plan, all conflicts should be reported to the appointed Principal Designer.



Bankhead Group  
Robin Hill Clifford Rd Ilkley  
Project Address

Sheet Name: Approved Site Elevations

Purpose of issue: Planning Status:

Date: 09/27/23 Checked by: CB

Drawn by: RAB Scale @ A1: 1 : 100

Project No: 8594 Revision: P2

Drawing No : 8594-BOW-A-3010



Do not scale from this drawing. This drawing is the copyright of Bowman Riley Architects Limited. © P:\Architectural\Residential\8594 - Clifford Road, Ilkley\8594 - 07 Revit\8594-BOW-A-0001\_Site Hybrid Option 4.rvt