



1:200

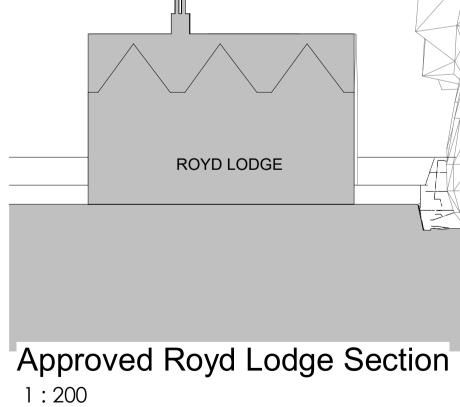

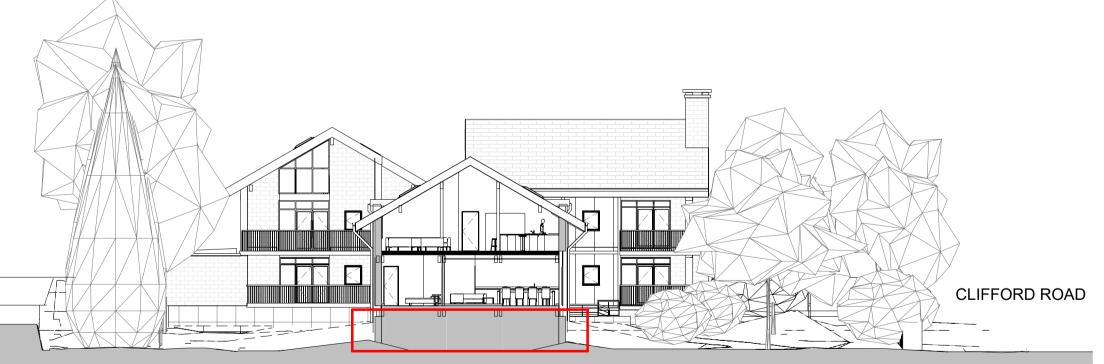

APPROVAL REF: 22/04364/FUL Date: 08/08/2023

Revision Date By Chk All dimensions to be verified on site, and the Architect informed of any discrepancy. All drawings and specifications should be read in conjunction with the Health and Safety Plan; all conflicts should be reported to the appointed Principal Designer. B \land N K H E A D GROUP Bankhead Group Robin Hill Clifford Rd Ilkley Project Address Sheet Name: Approved Site Sections 겁 Purpose of issue: Planning Status: Date: 09/27/23 Checked by: CB Drawn by: RAB Scale @ A1: 1 : 200 Revision: P2 Project No: 8594 8594-BOW-A-4010 Drawing No : BC MAN

**ARCHITECTS • BUILDING CONSULTANTS • INTERIORS** 

P2 Client adjustment P1 Red line Areas shown

17.10.23 RB CB 12.10.23 RB CB

