




Proposed New South Elevation
1 : 100

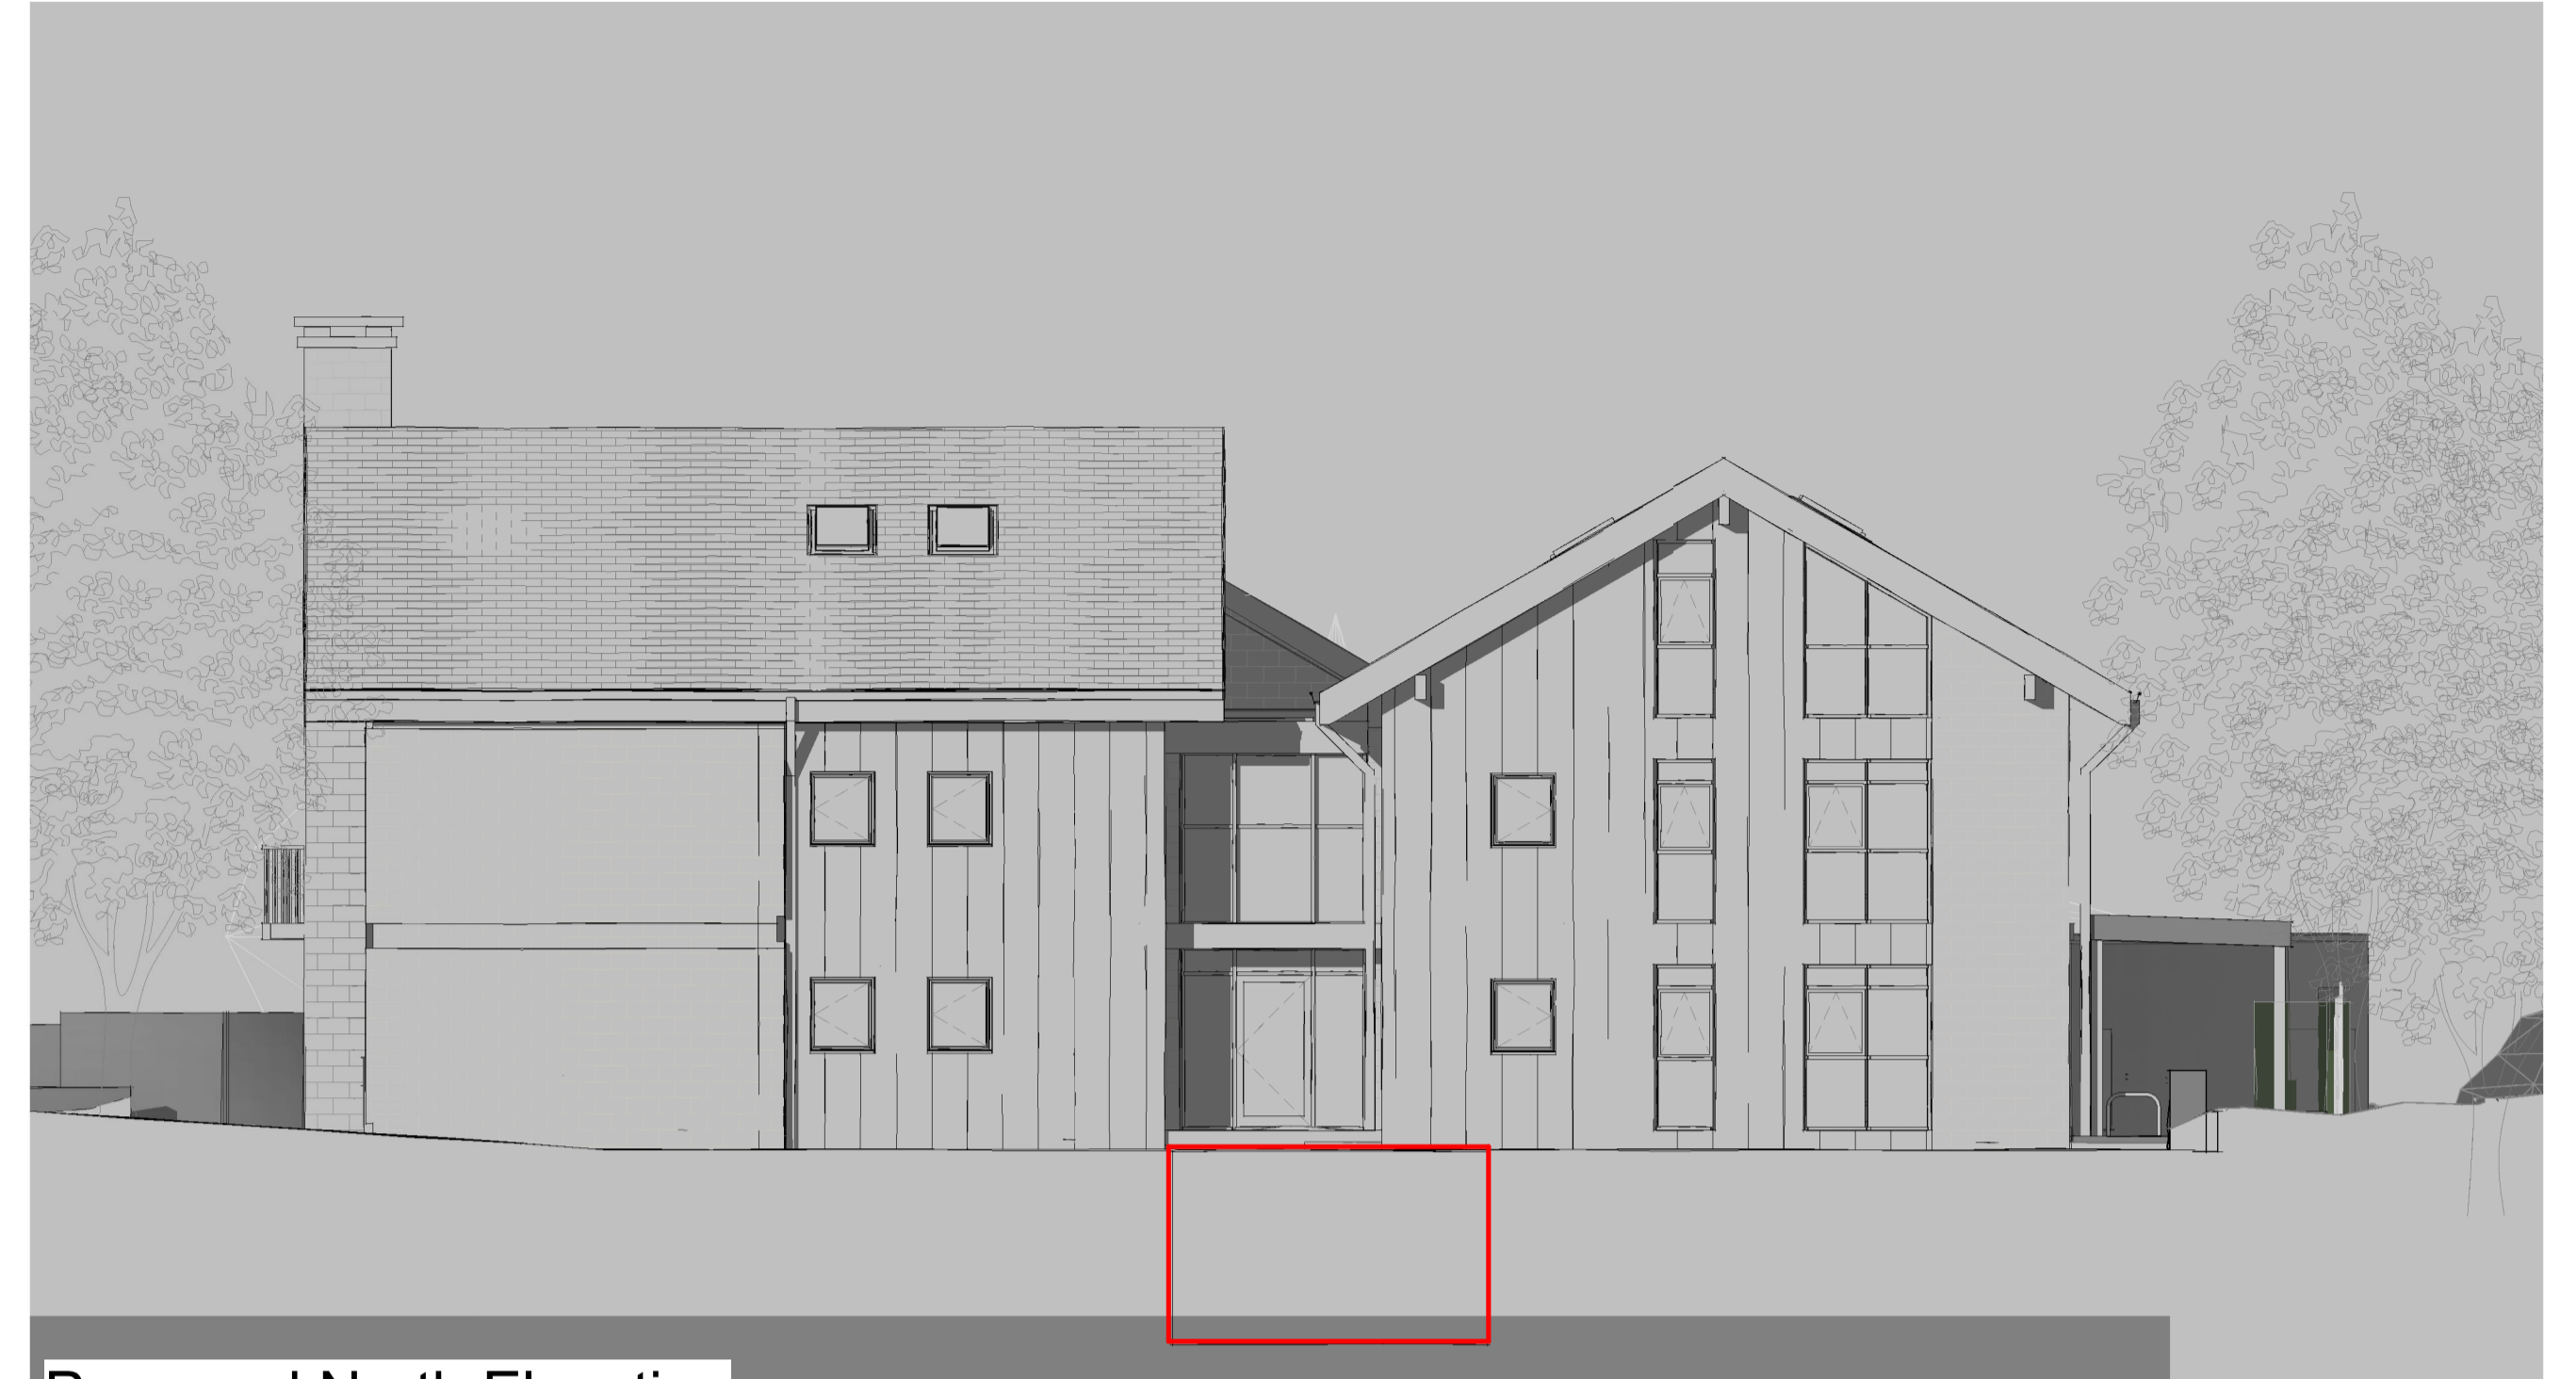

Proposed North Elevation
1 : 100



Proposed New West Elevation
1 : 100



Proposed New East Elevation
1 : 100

P2	Client adjustment	17.10.23	RB	CB
P1	Red line Areas shown	12.10.23	RB	CB
	Revision	Date	By	Chk

All dimensions to be verified on site, and the Architect informed of any discrepancy. All drawings and specifications should be read in conjunction with the Health and Safety Plan, all conflicts should be reported to the appointed Principal Designer.



Bankhead Group
Robin Hill Clifford Rd Ilkley
Project Address

Sheet Name: Proposed New Site Elevations

Purpose of issue: Planning Status:

Date: 09/27/23 Checked by: CB

Drawn by: RAB Scale @ A1: 1 : 100

Project No: 8594 Revision: P2

Drawing No : 8594-BOW-A-3011



Do not scale from this drawing. This drawing is the copyright of Bowman Riley Architects Limited. © P:\Architectural\Residential\8594 - Clifford Road, Ilkley\8594 - 07 Revit\8594-BOW-A-0001_Site_Hybrid Option 4.rvt