



Do not scale from this drawing.
 This drawing is the property of AiCM Scotland Limited and must not be copied, reproduced or disclosed without written permission.


revisions:

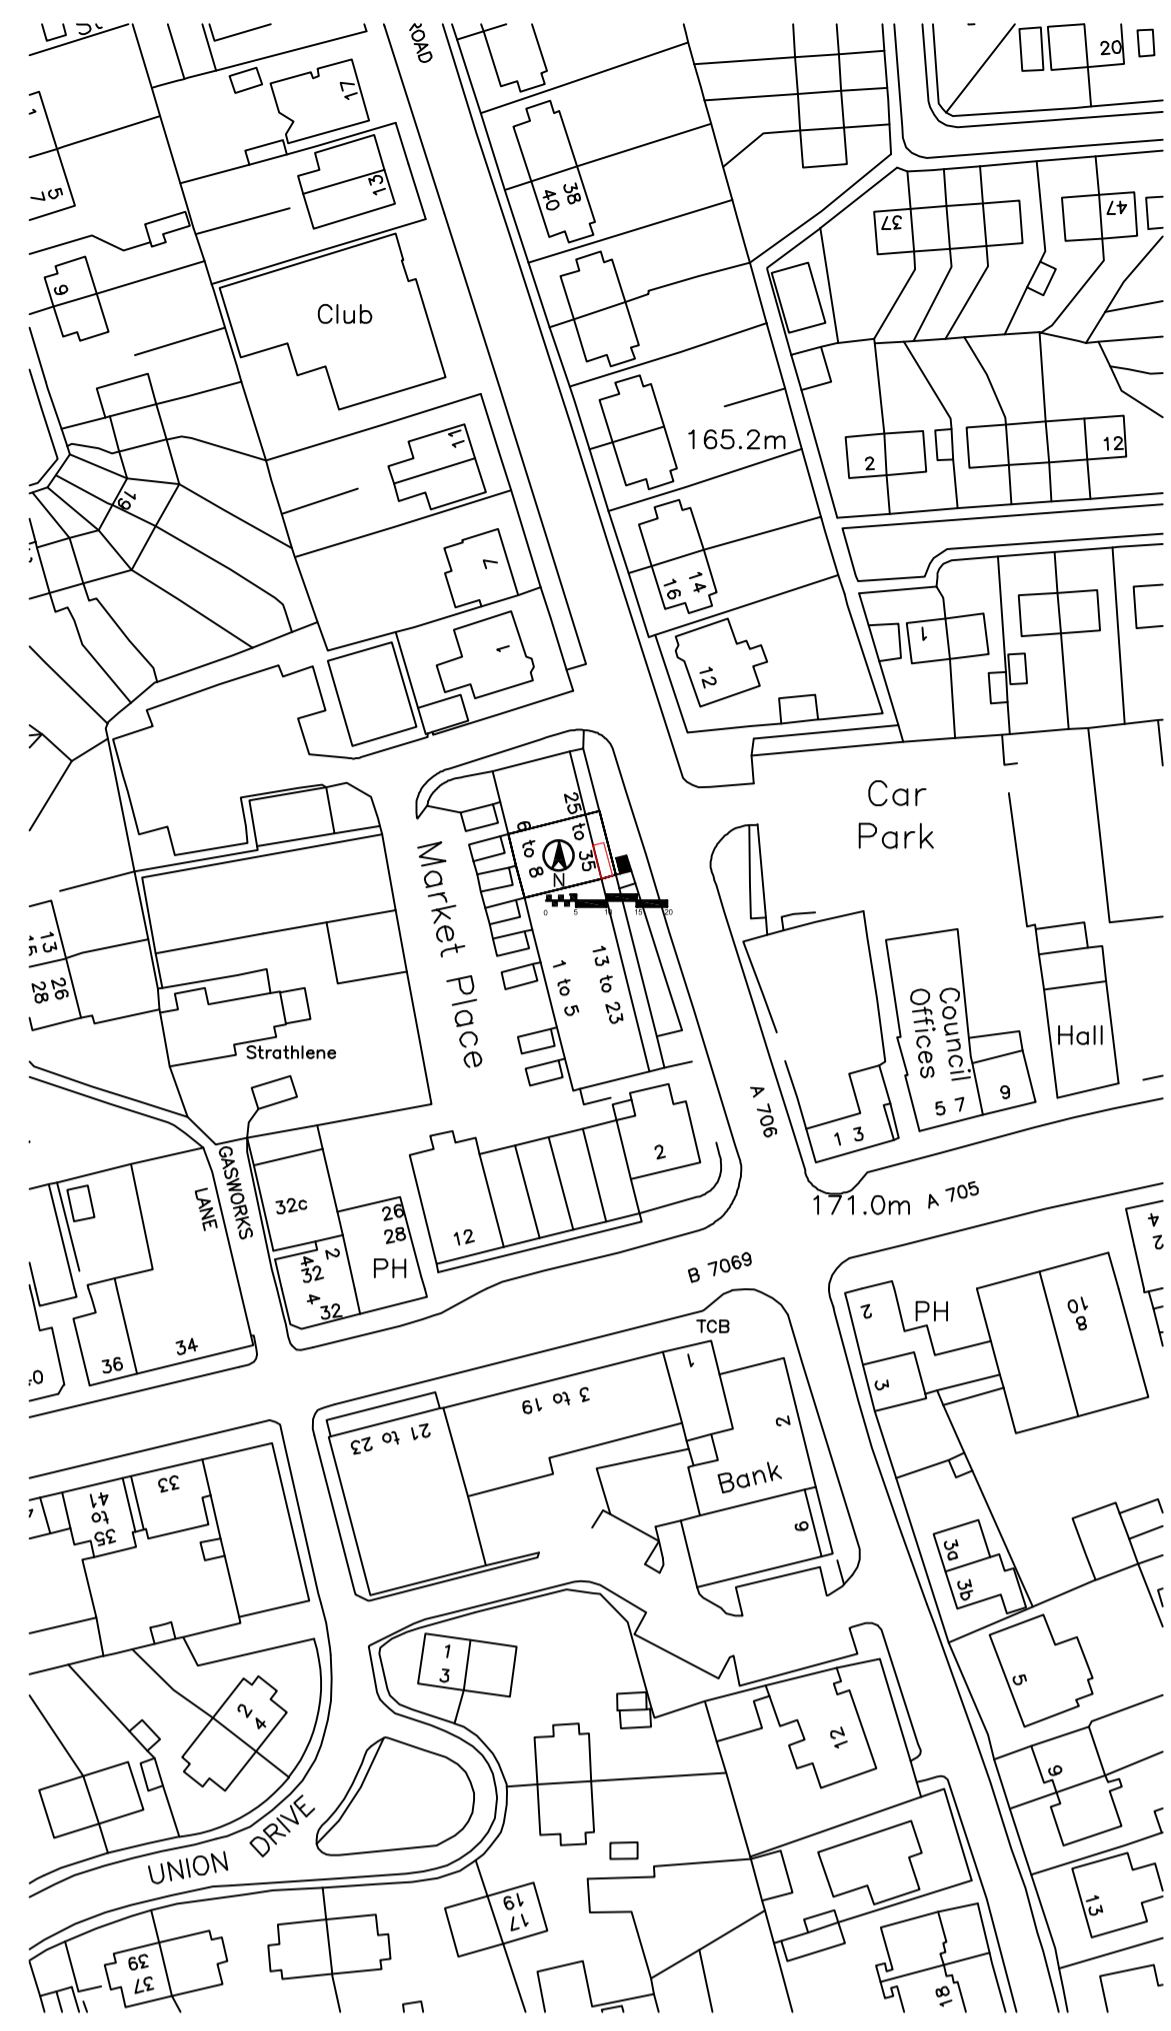


Location Plan
 Scale 1:1250

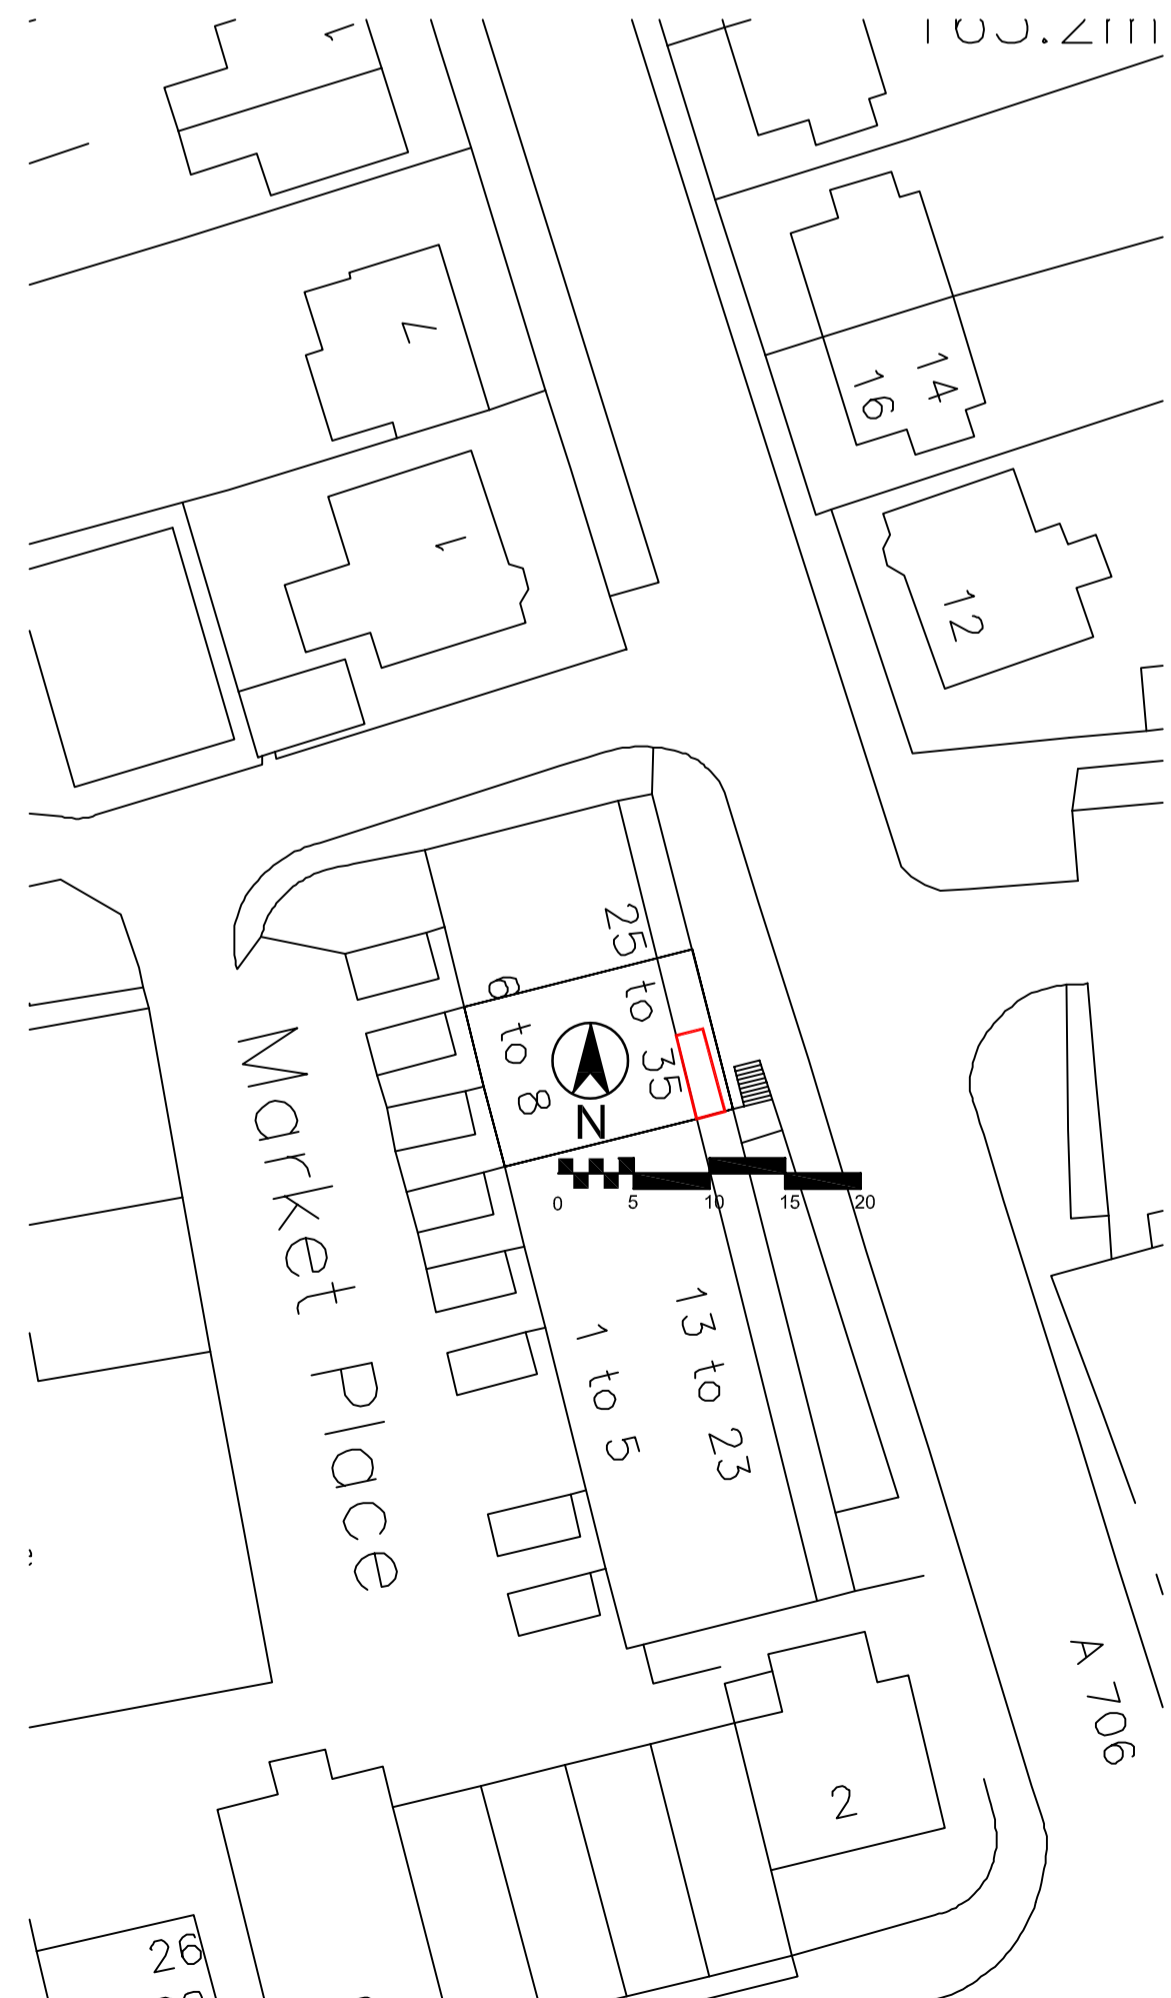


Development Plan
 Scale 1:500

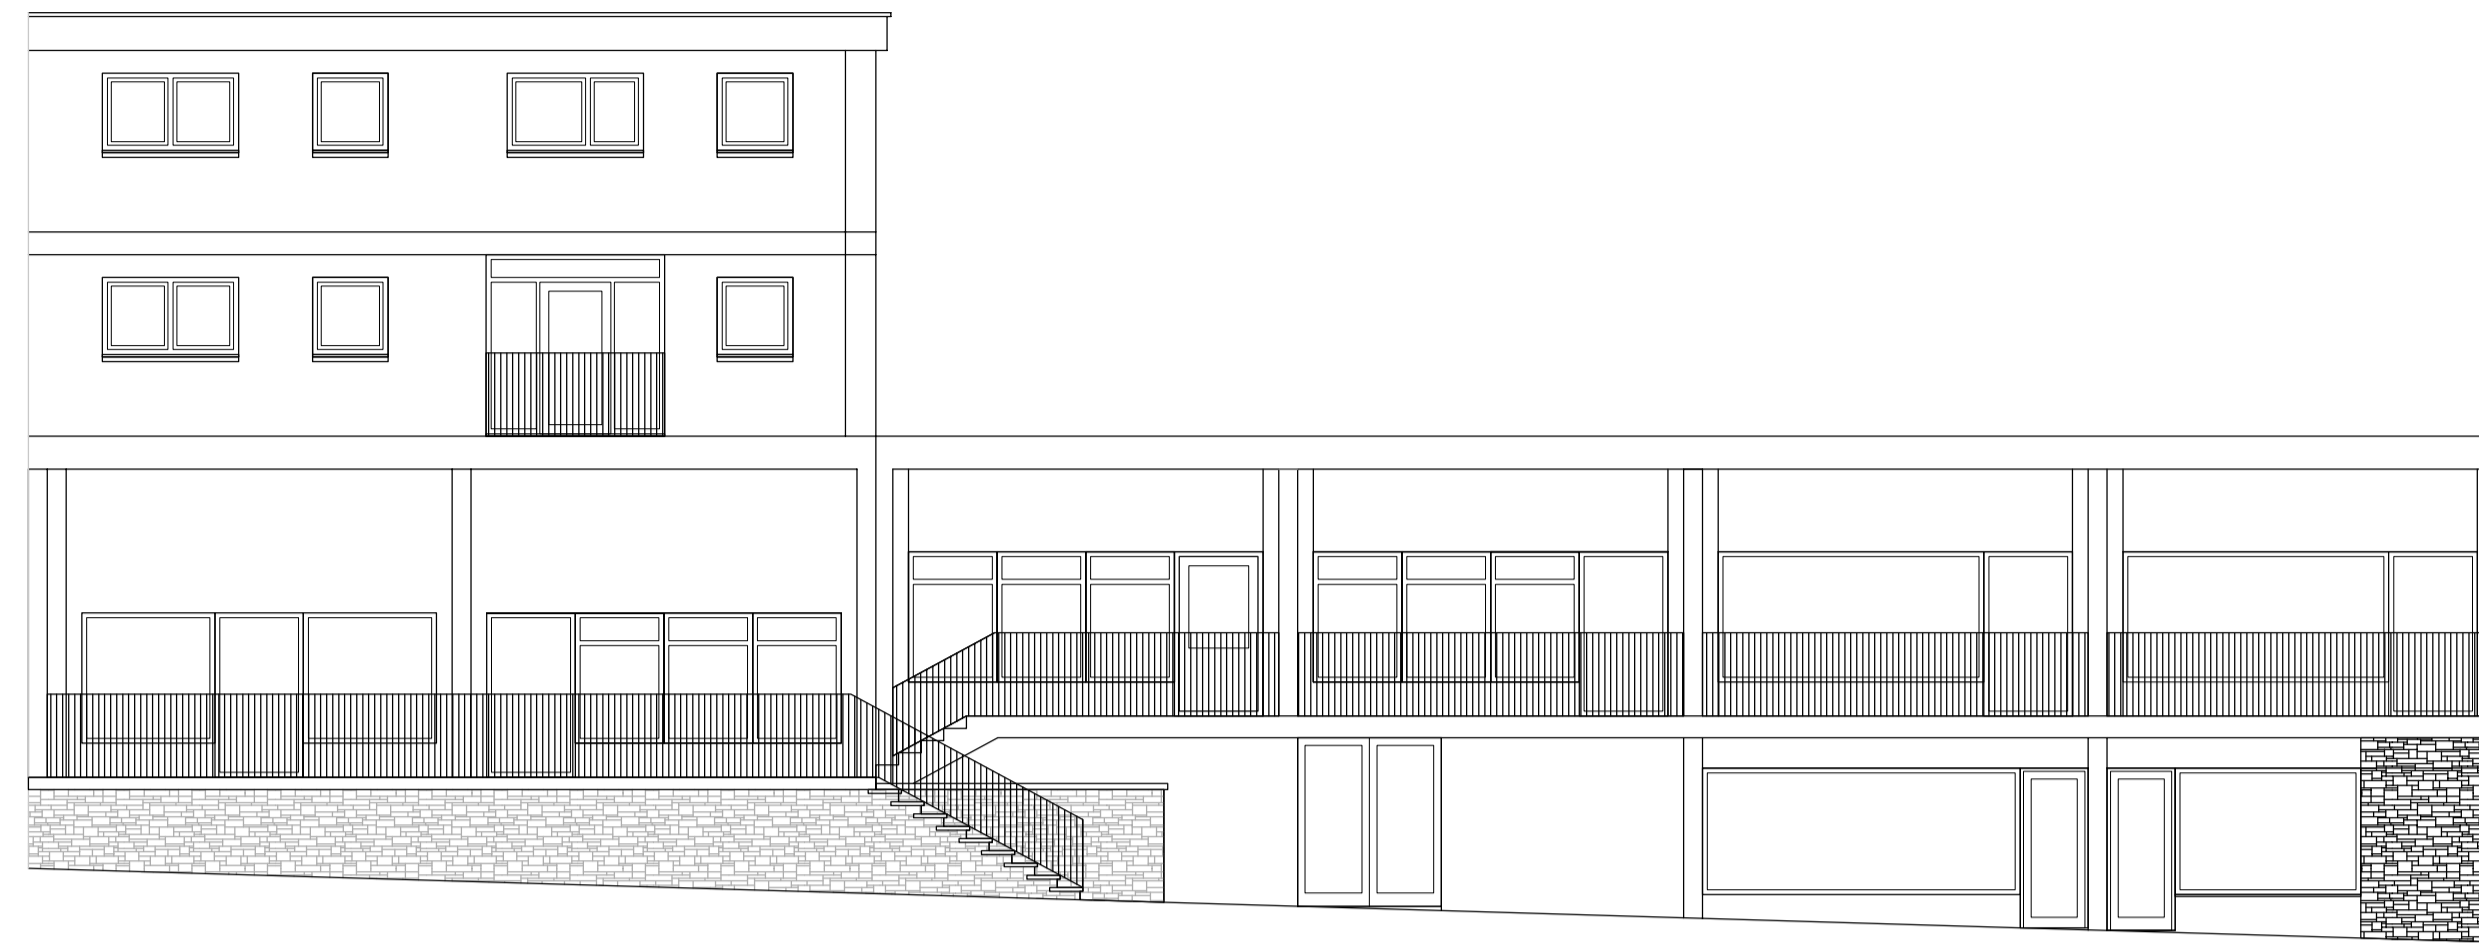


Ground Floor Plan - Existing
 Scale 1:100

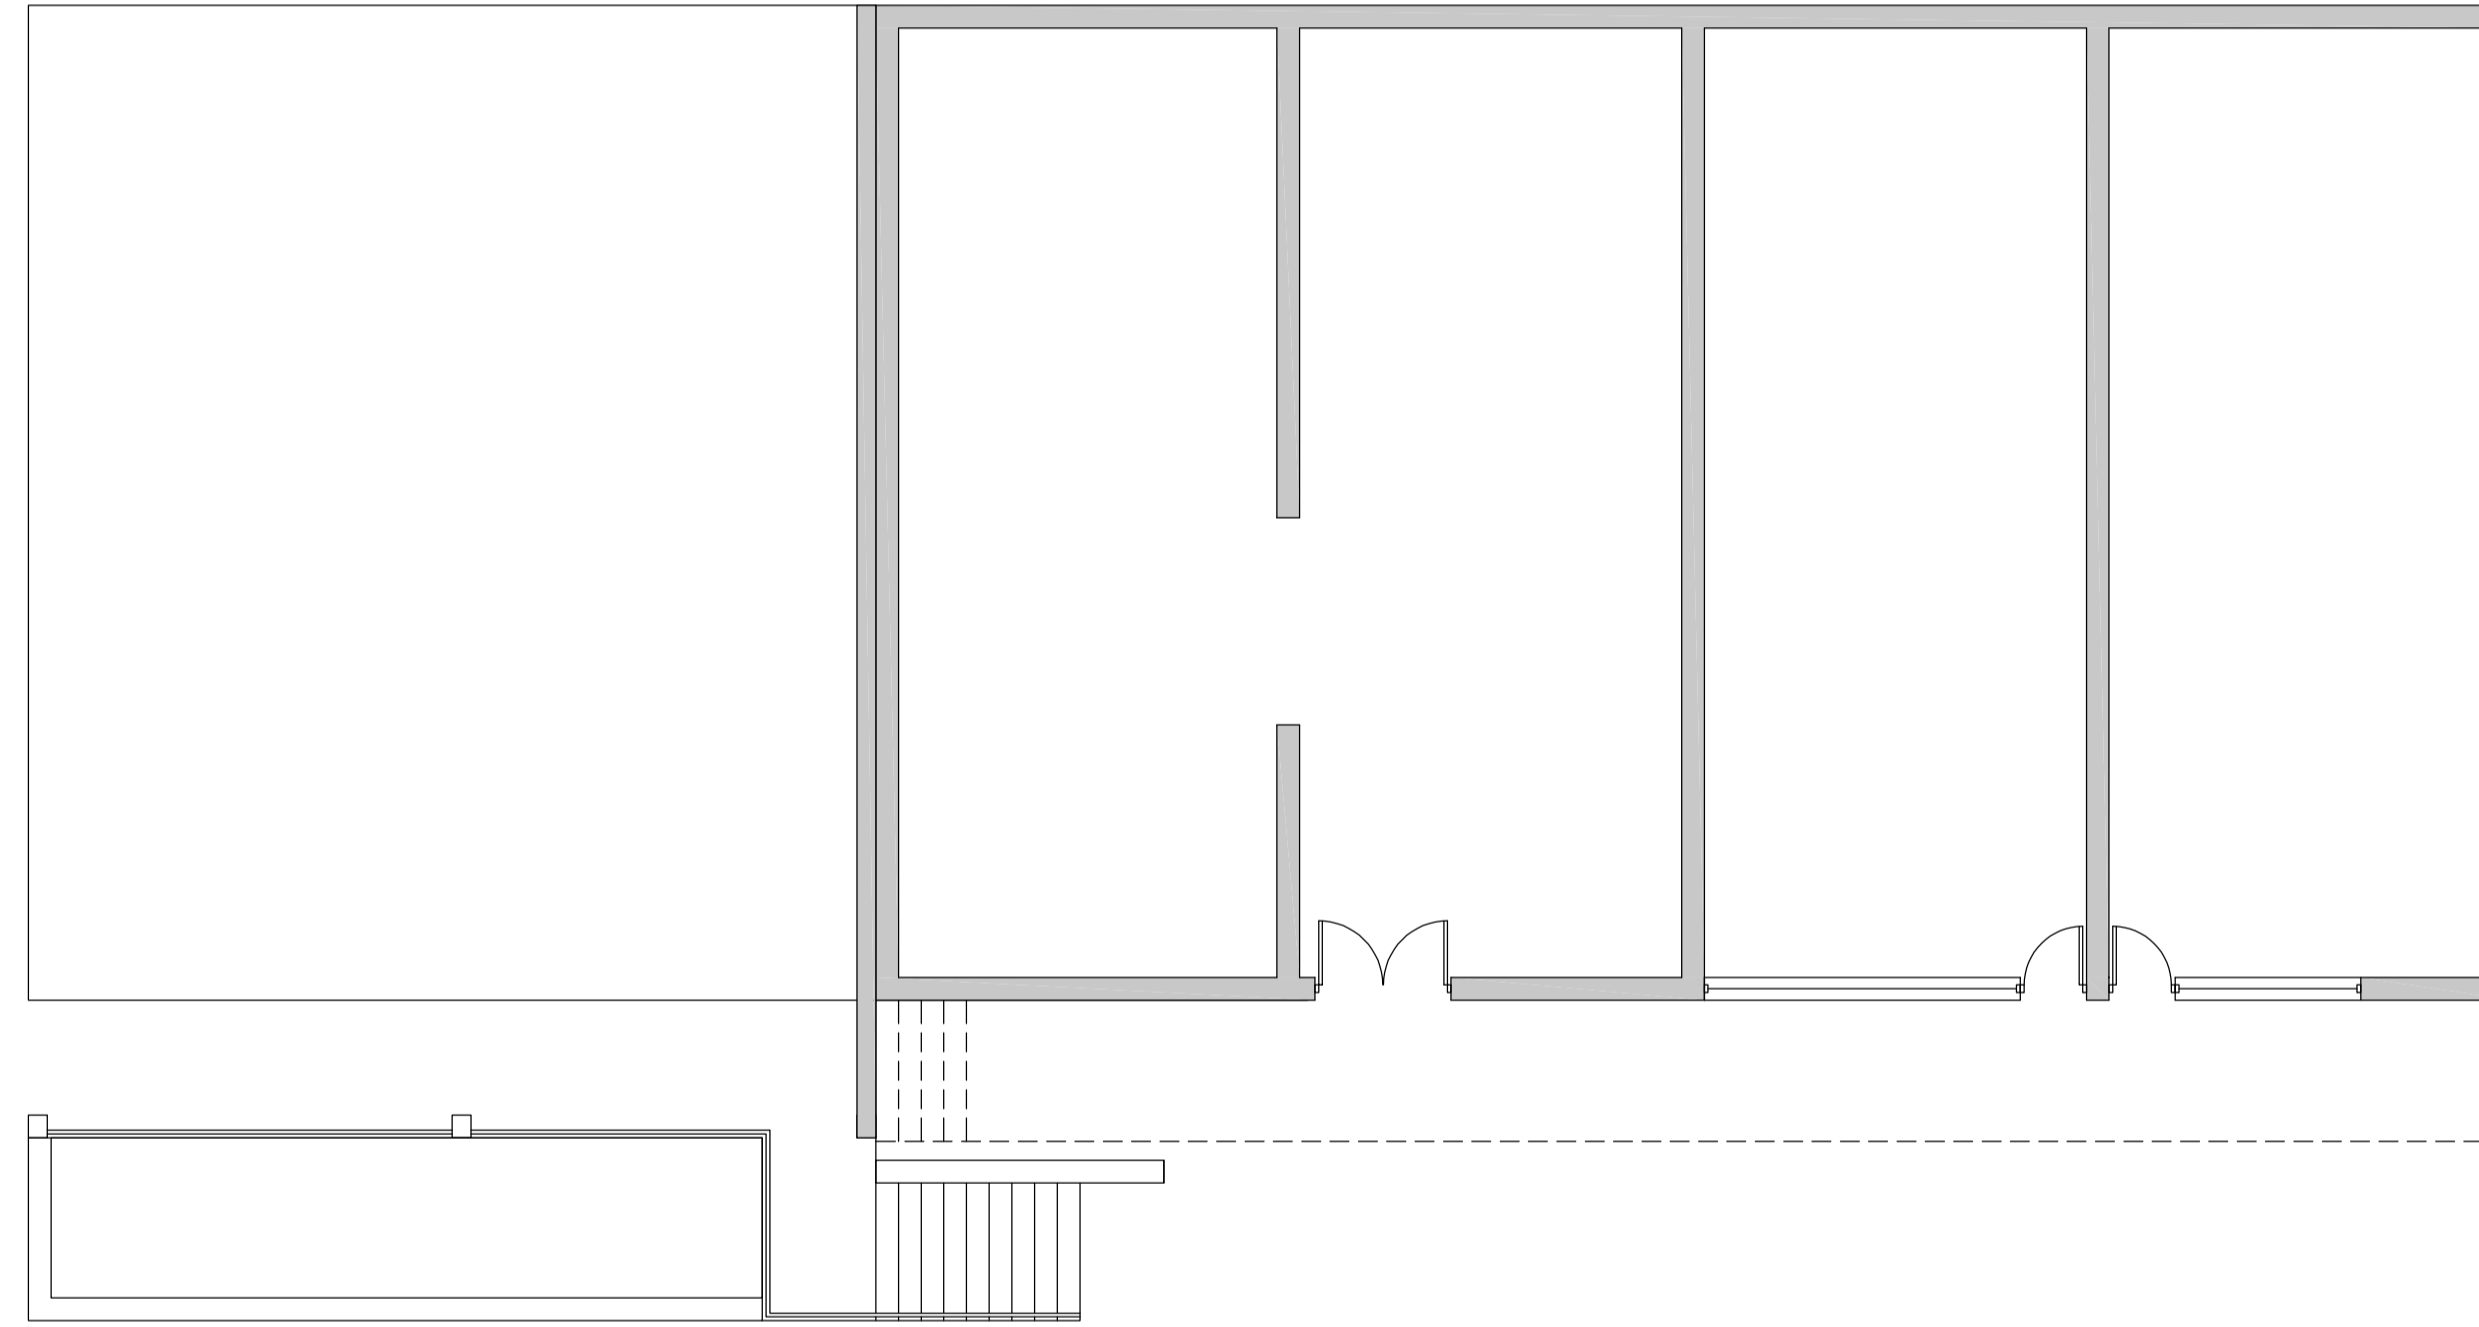


Ground Floor Plan - Existing
 Scale 1:100

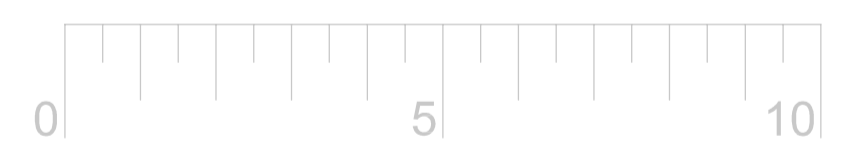


 AiCM Scotland Limited Architects, Interior Designers Construction Design & Management Telephone: 07770 432 759 E-mail: mail@aicm.co.uk		
drawing title: Original Layout		
issue stage: Statutory Consents		
date: April22	drawn: dgf	scale @ A3: as noted
drawing number: s23-767 AL(0)300	revision: A	

Do not scale from this drawing.
 This drawing is the property of AiCM Scotland Limited and must not be copied, reproduced or disclosed without written permission.


revisions:

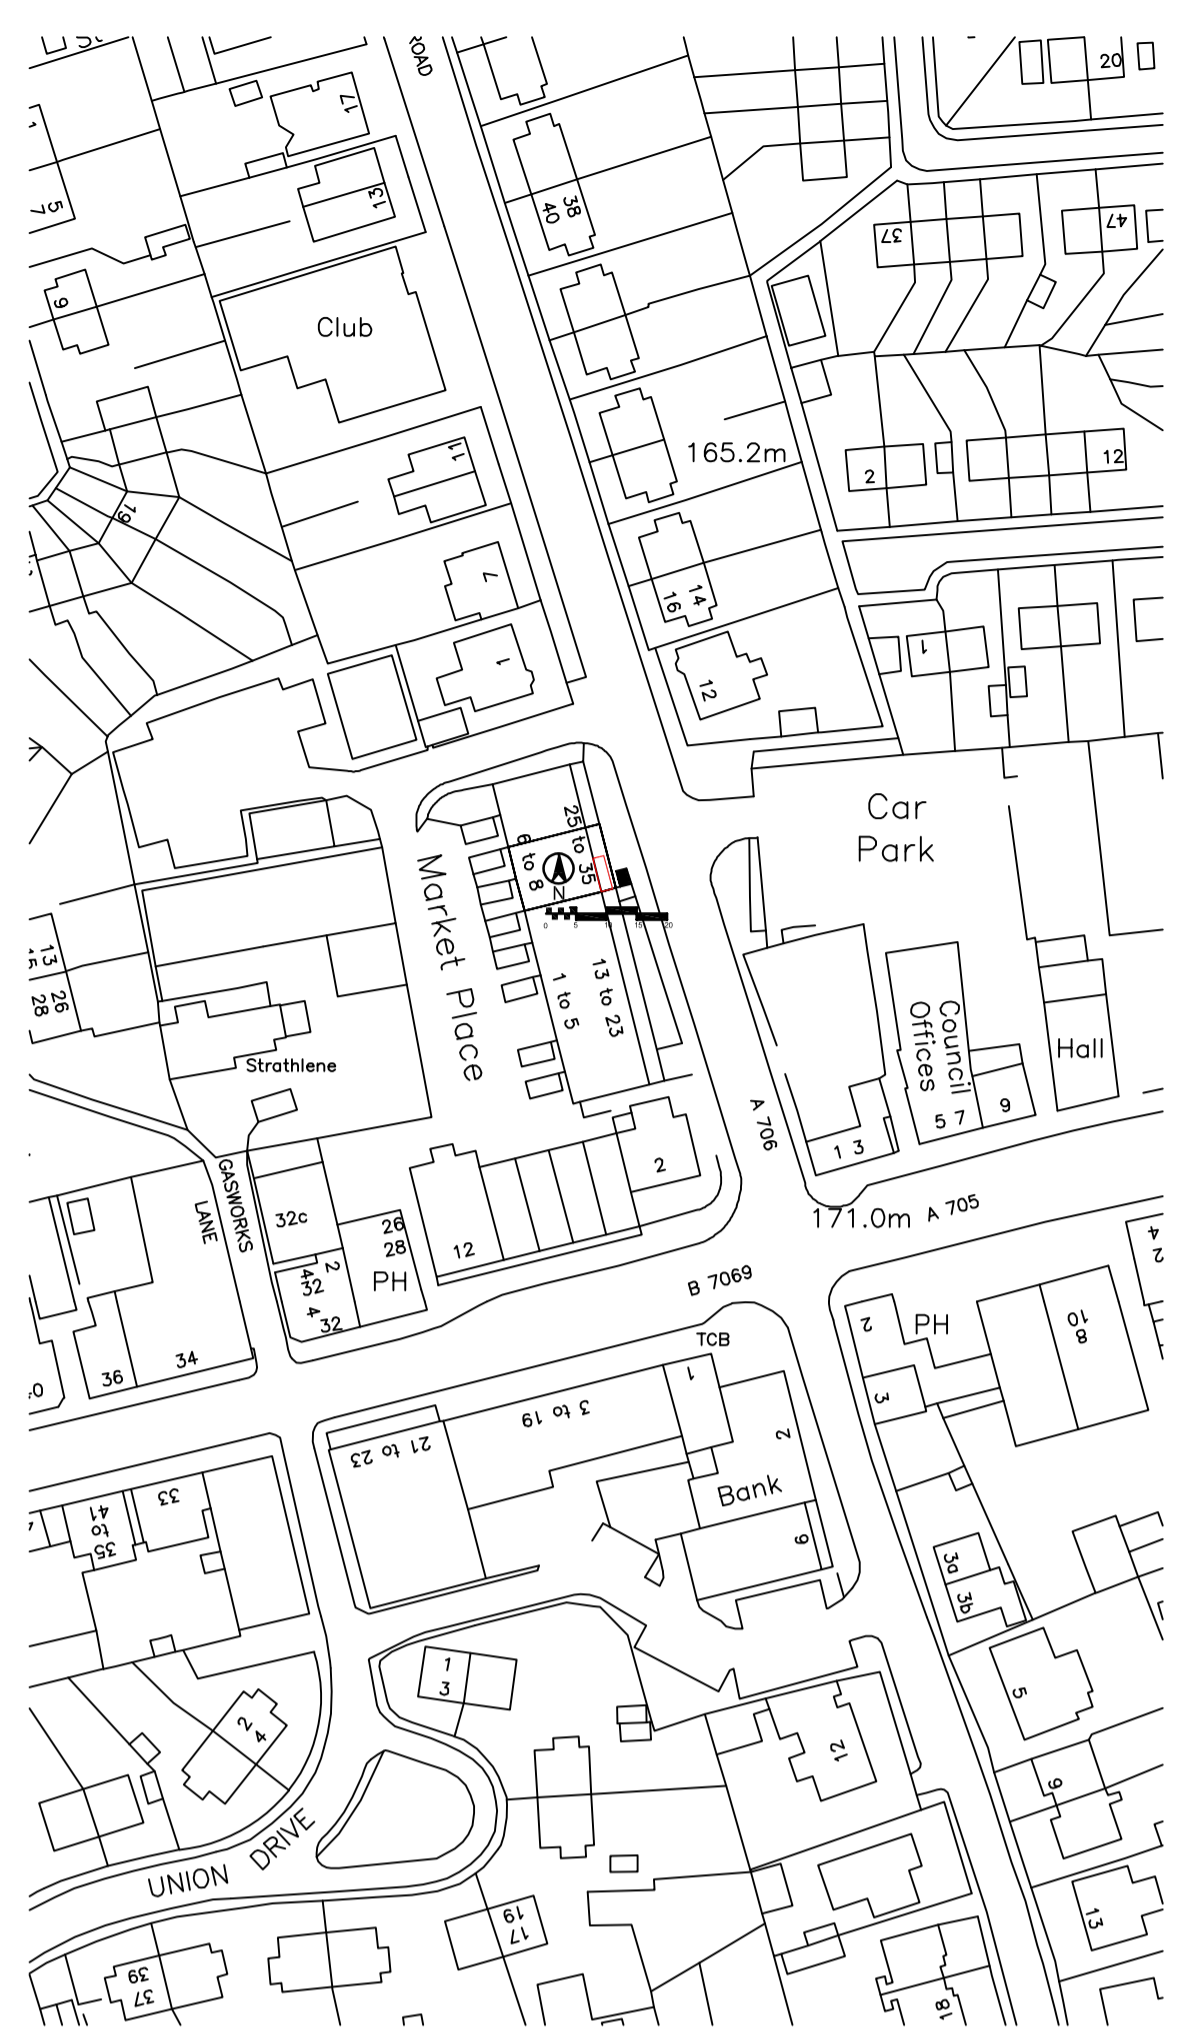


Location Plan
 Scale 1:1250

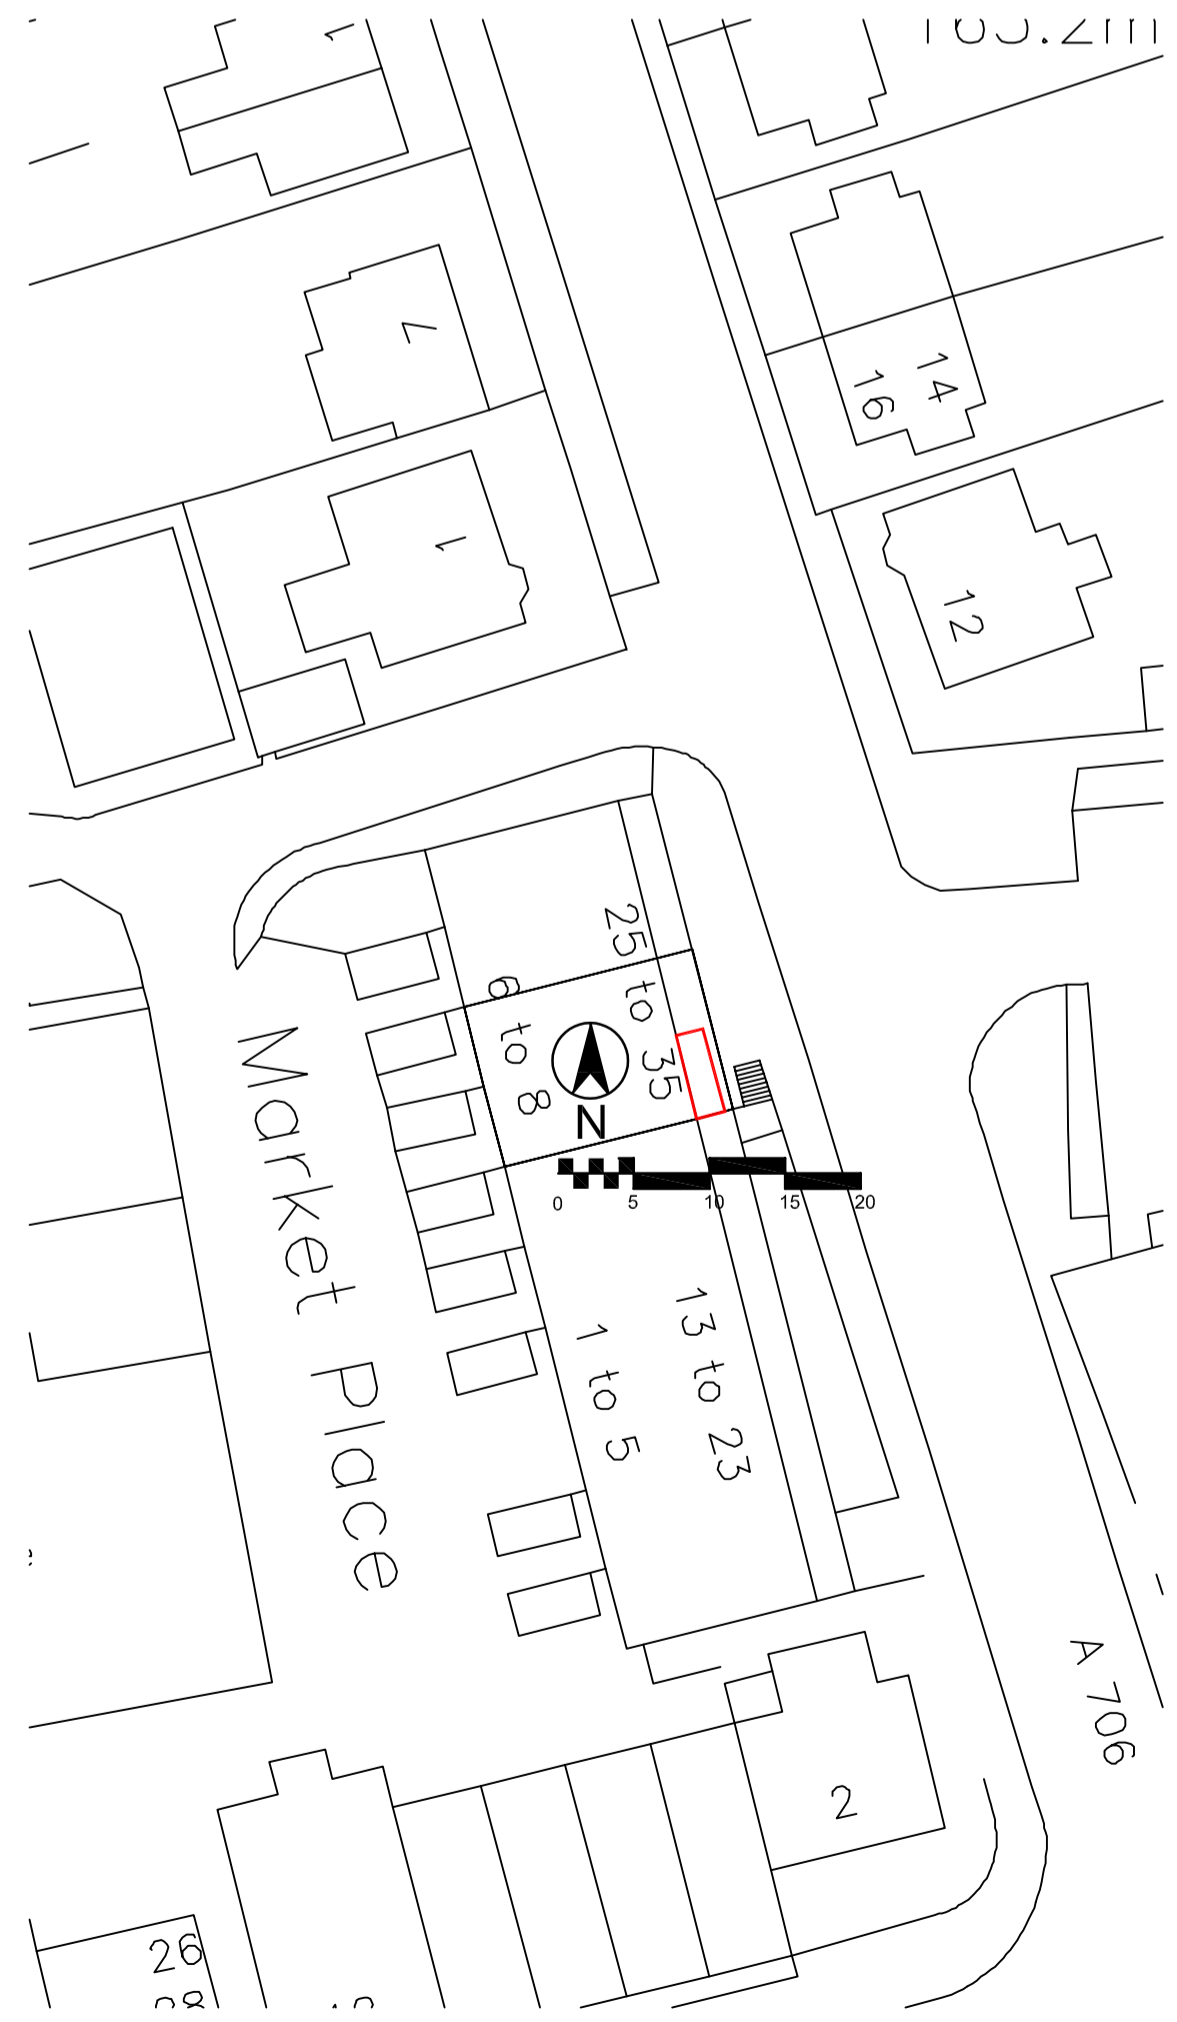


Development Plan
 Scale 1:500

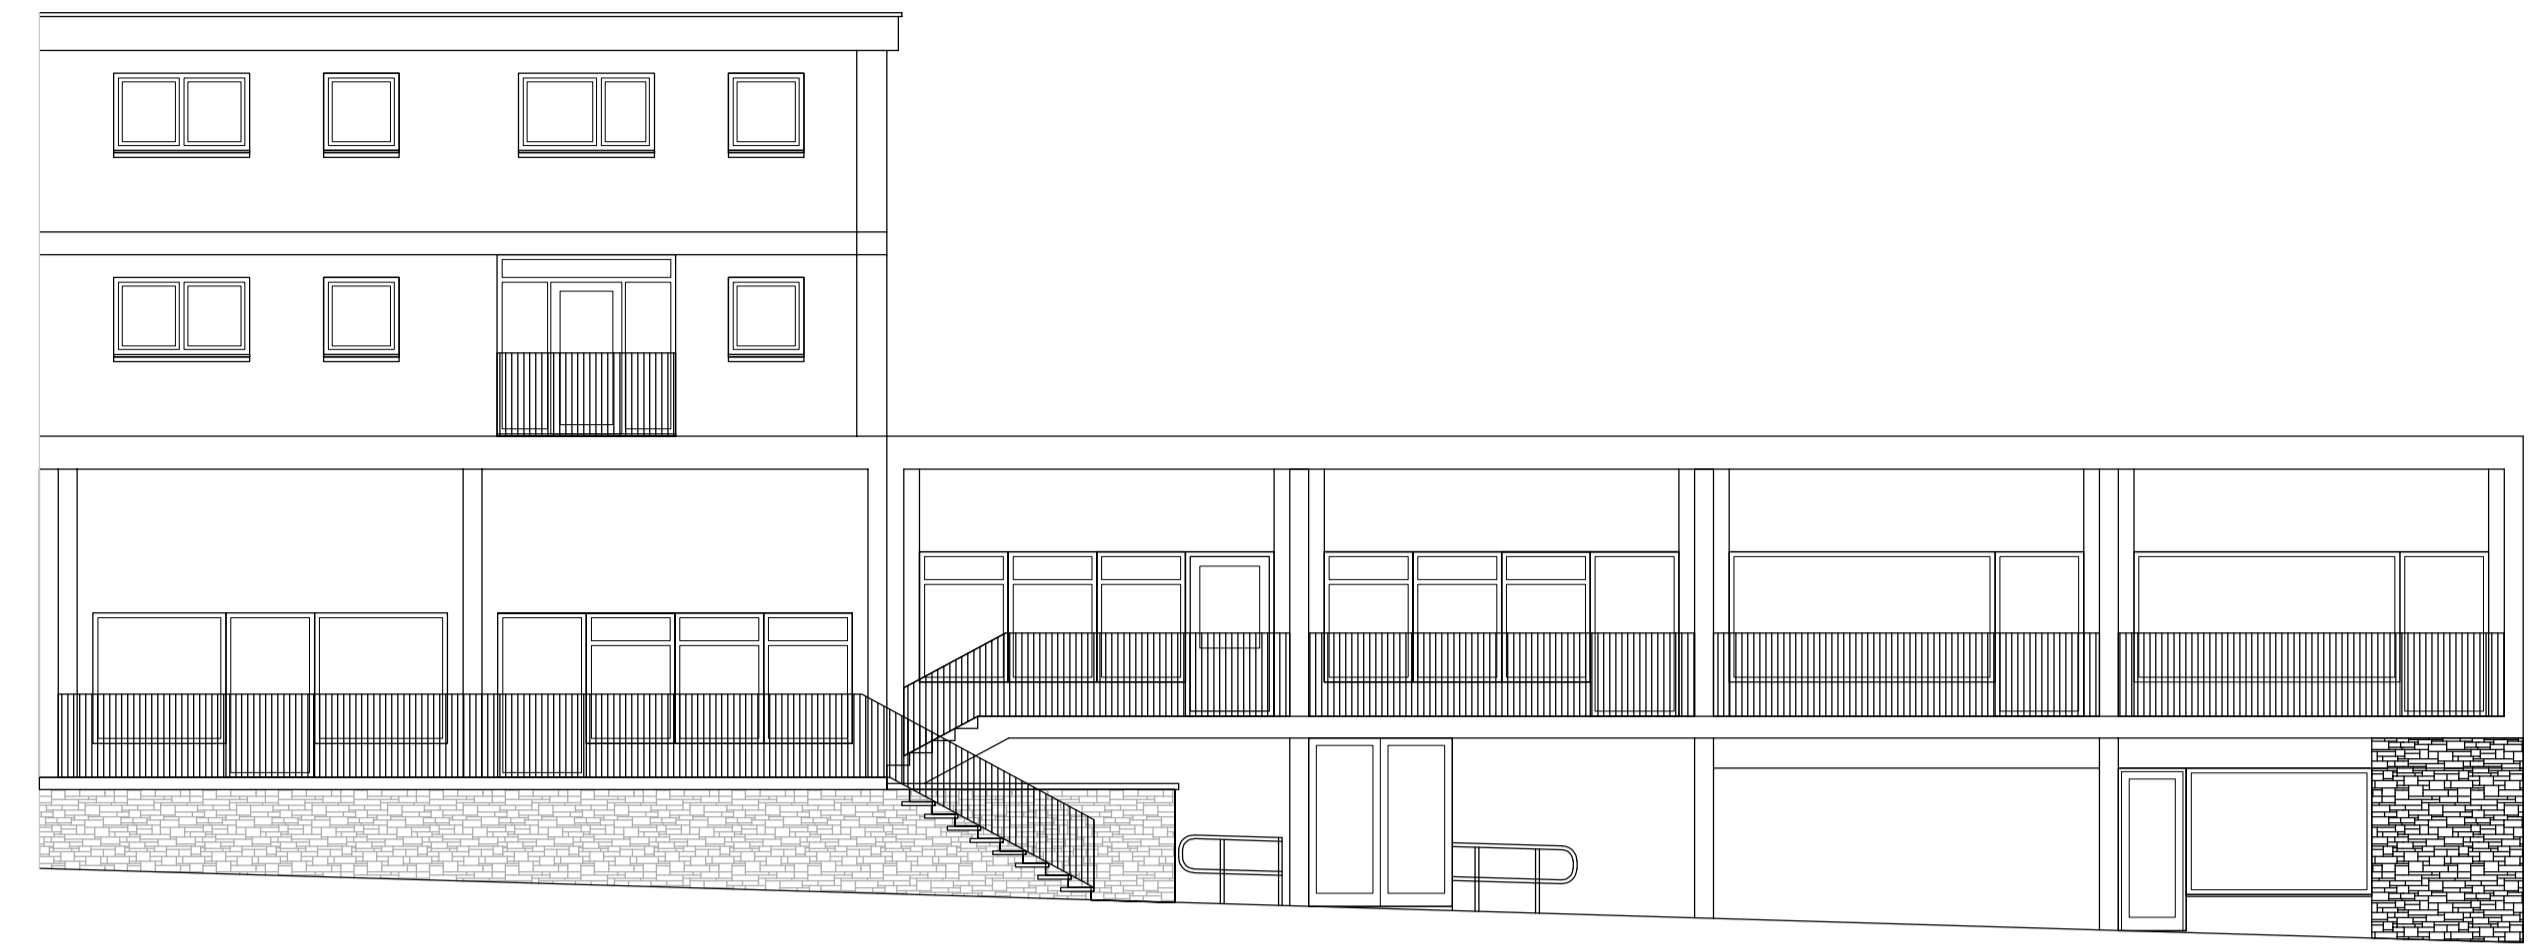


Ground Floor Plan - Proposed
 Scale 1:100

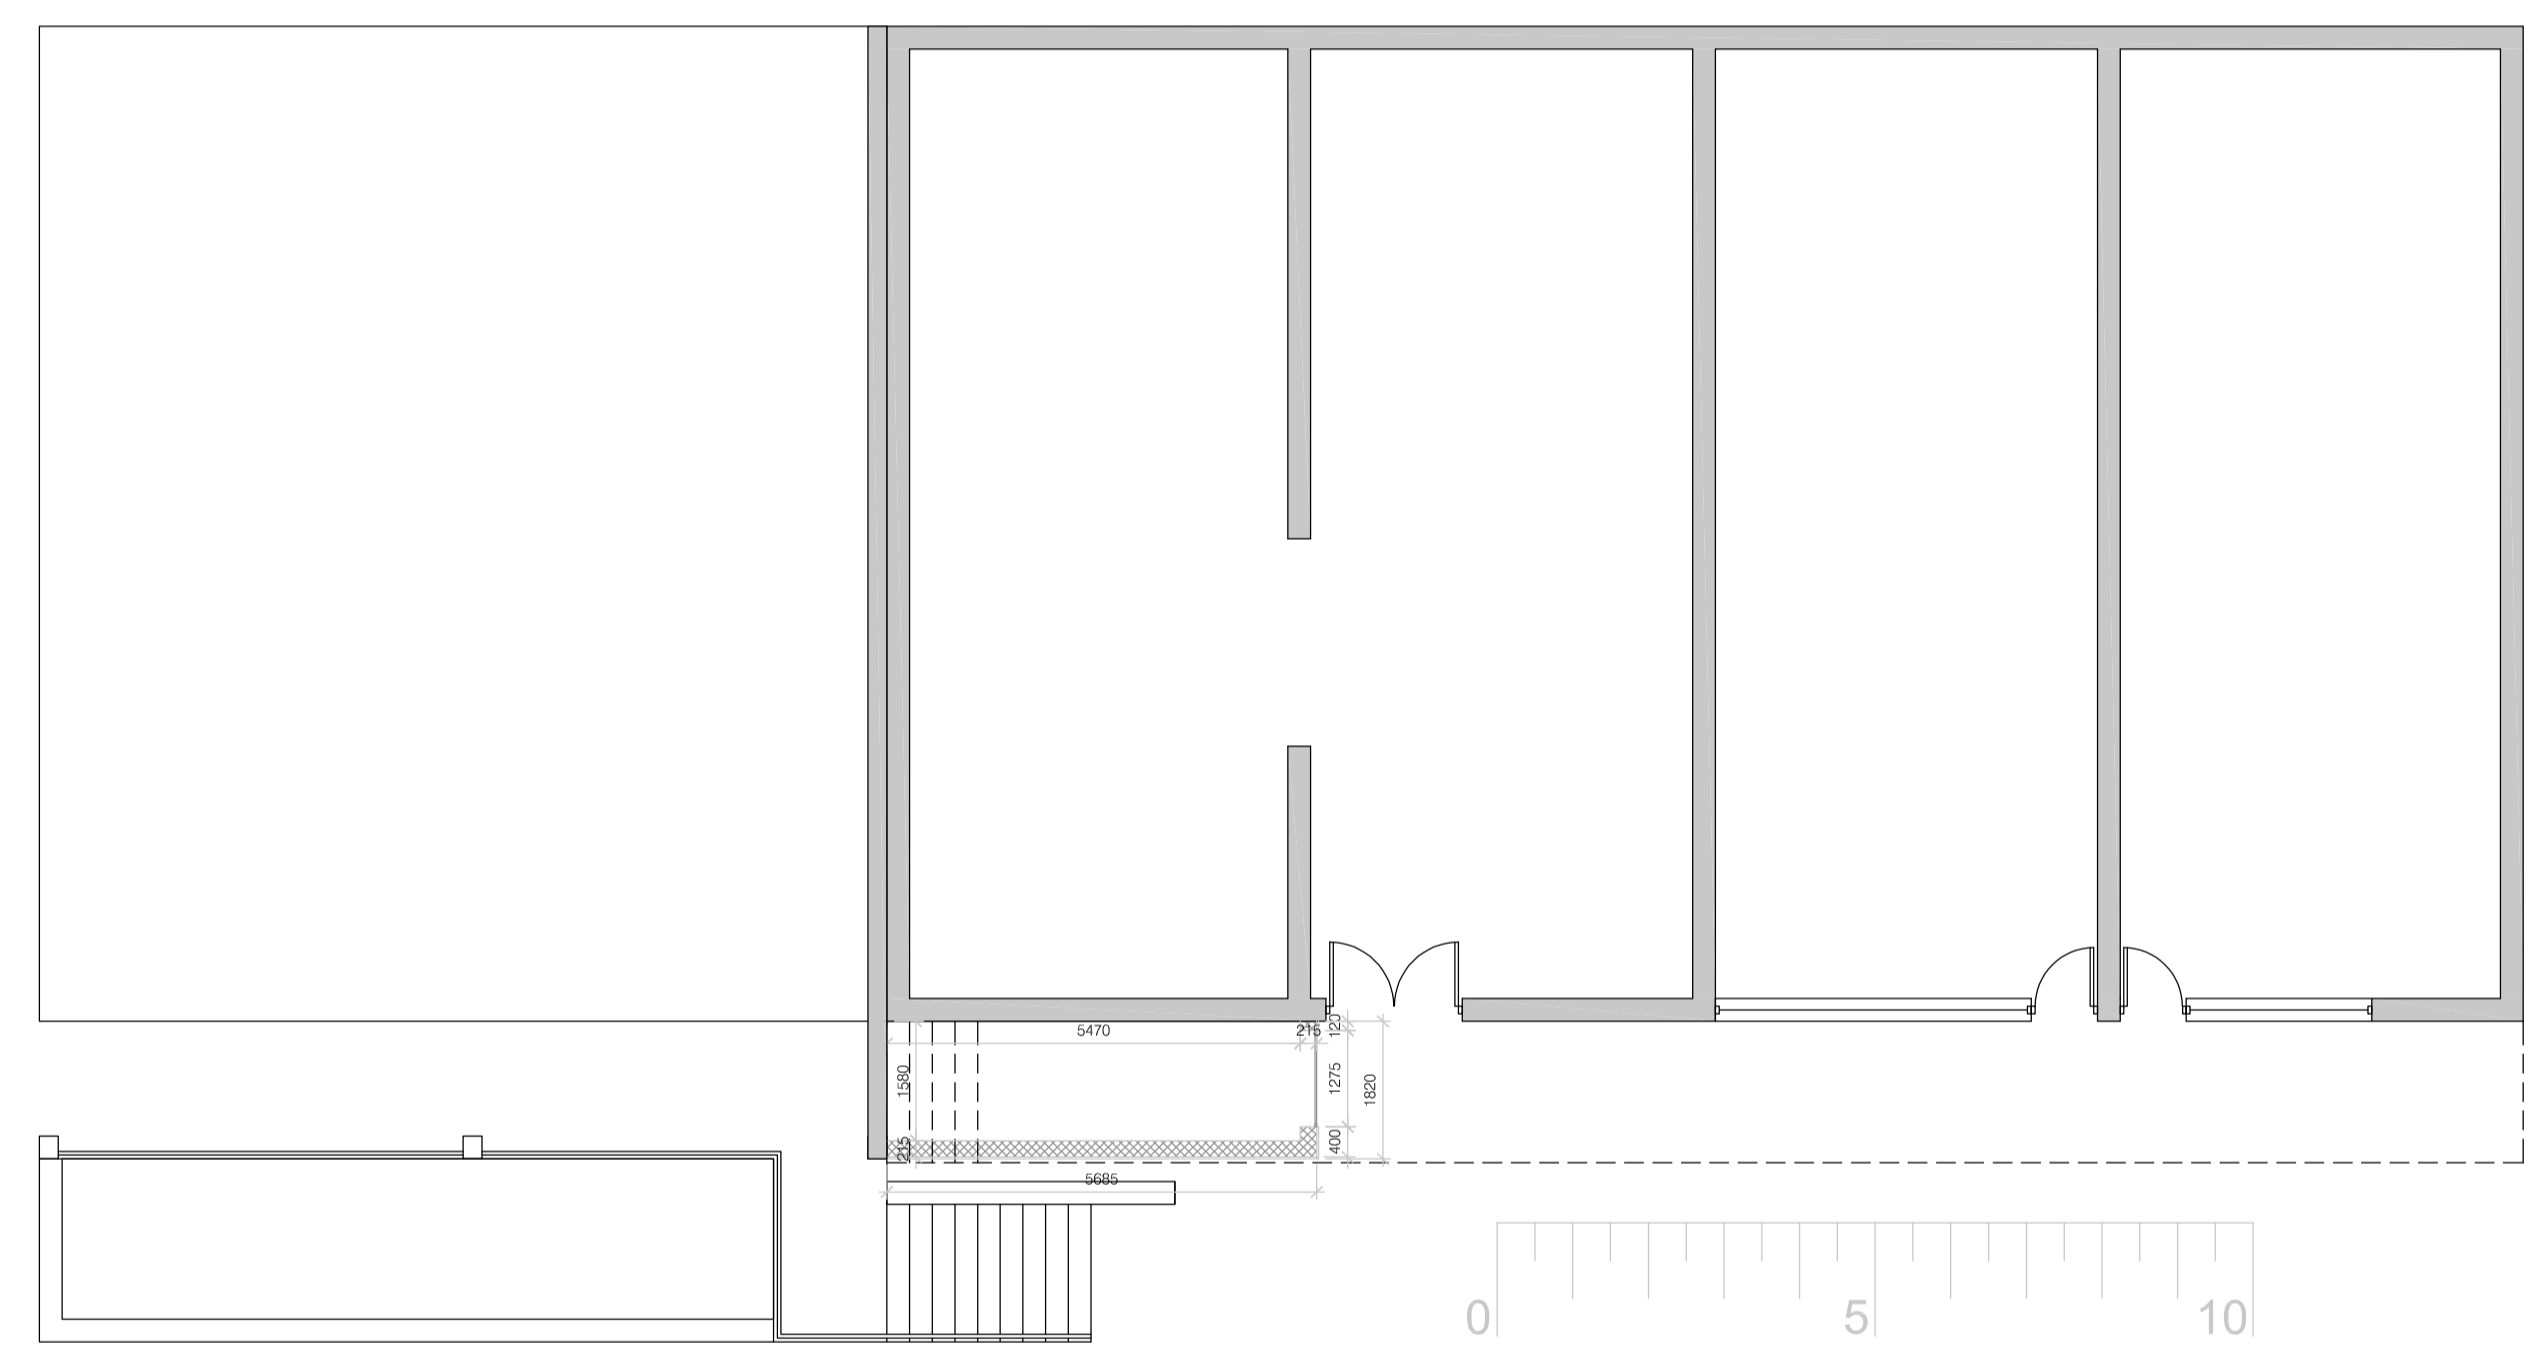

Ground Floor Plan - Proposed
 Scale 1:100

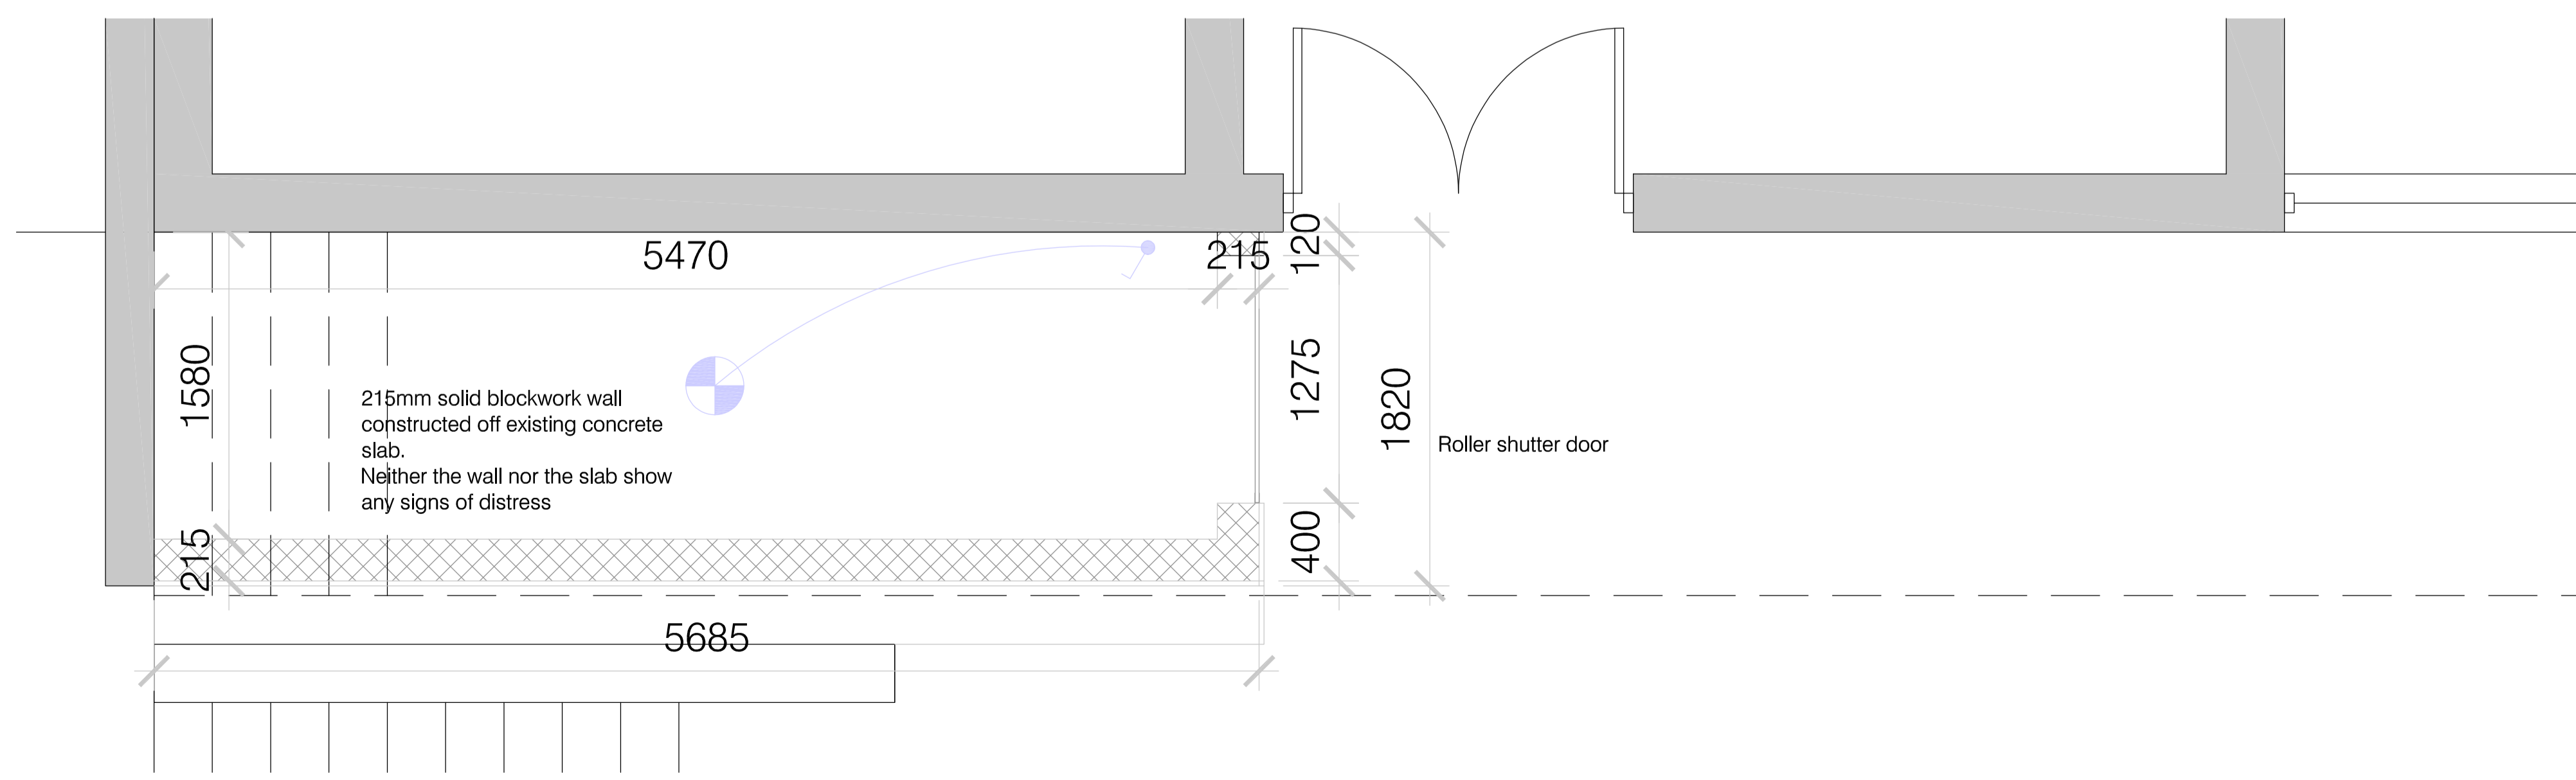

 AiCM Scotland Limited Architects, Interior Designers Construction Design & Management Telephone: 07770 432 759 E-mail: mail@aicm.co.uk		
drawing title: As built Layout		
issue stage: Statutory Consents		
date: April22	drawn: dgf	scale @ A3: as noted
drawing number: s23-767 AL(1)300		revision: A