

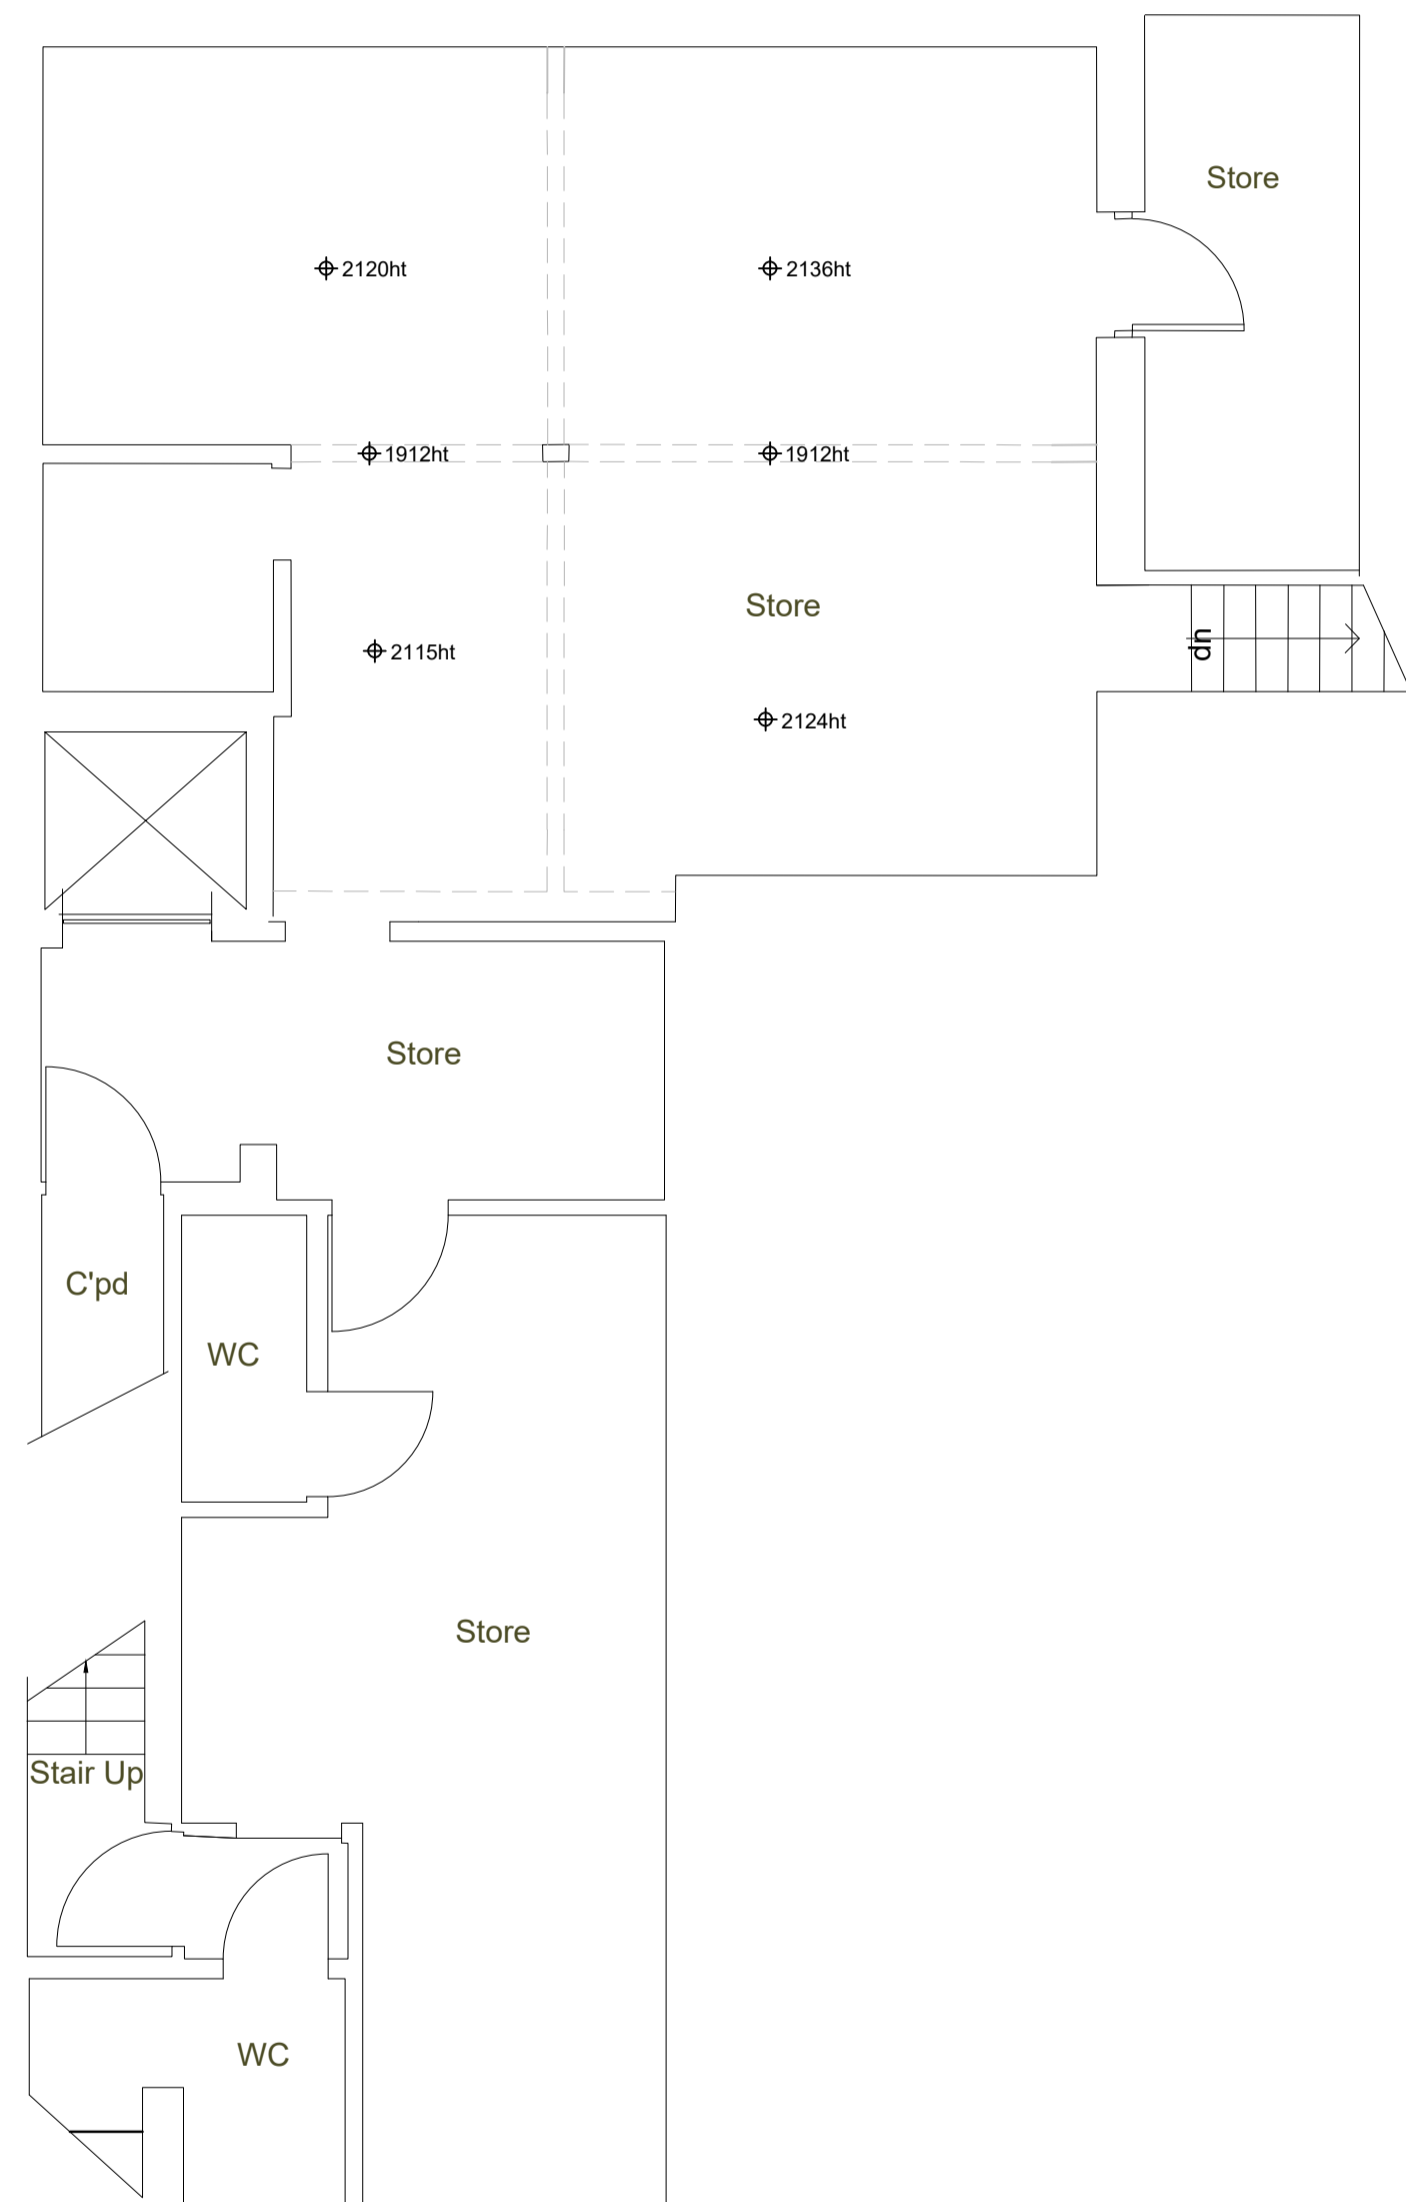


Location Plan

1:1250 0 10 20 30 40 50 60 70 80 90 100

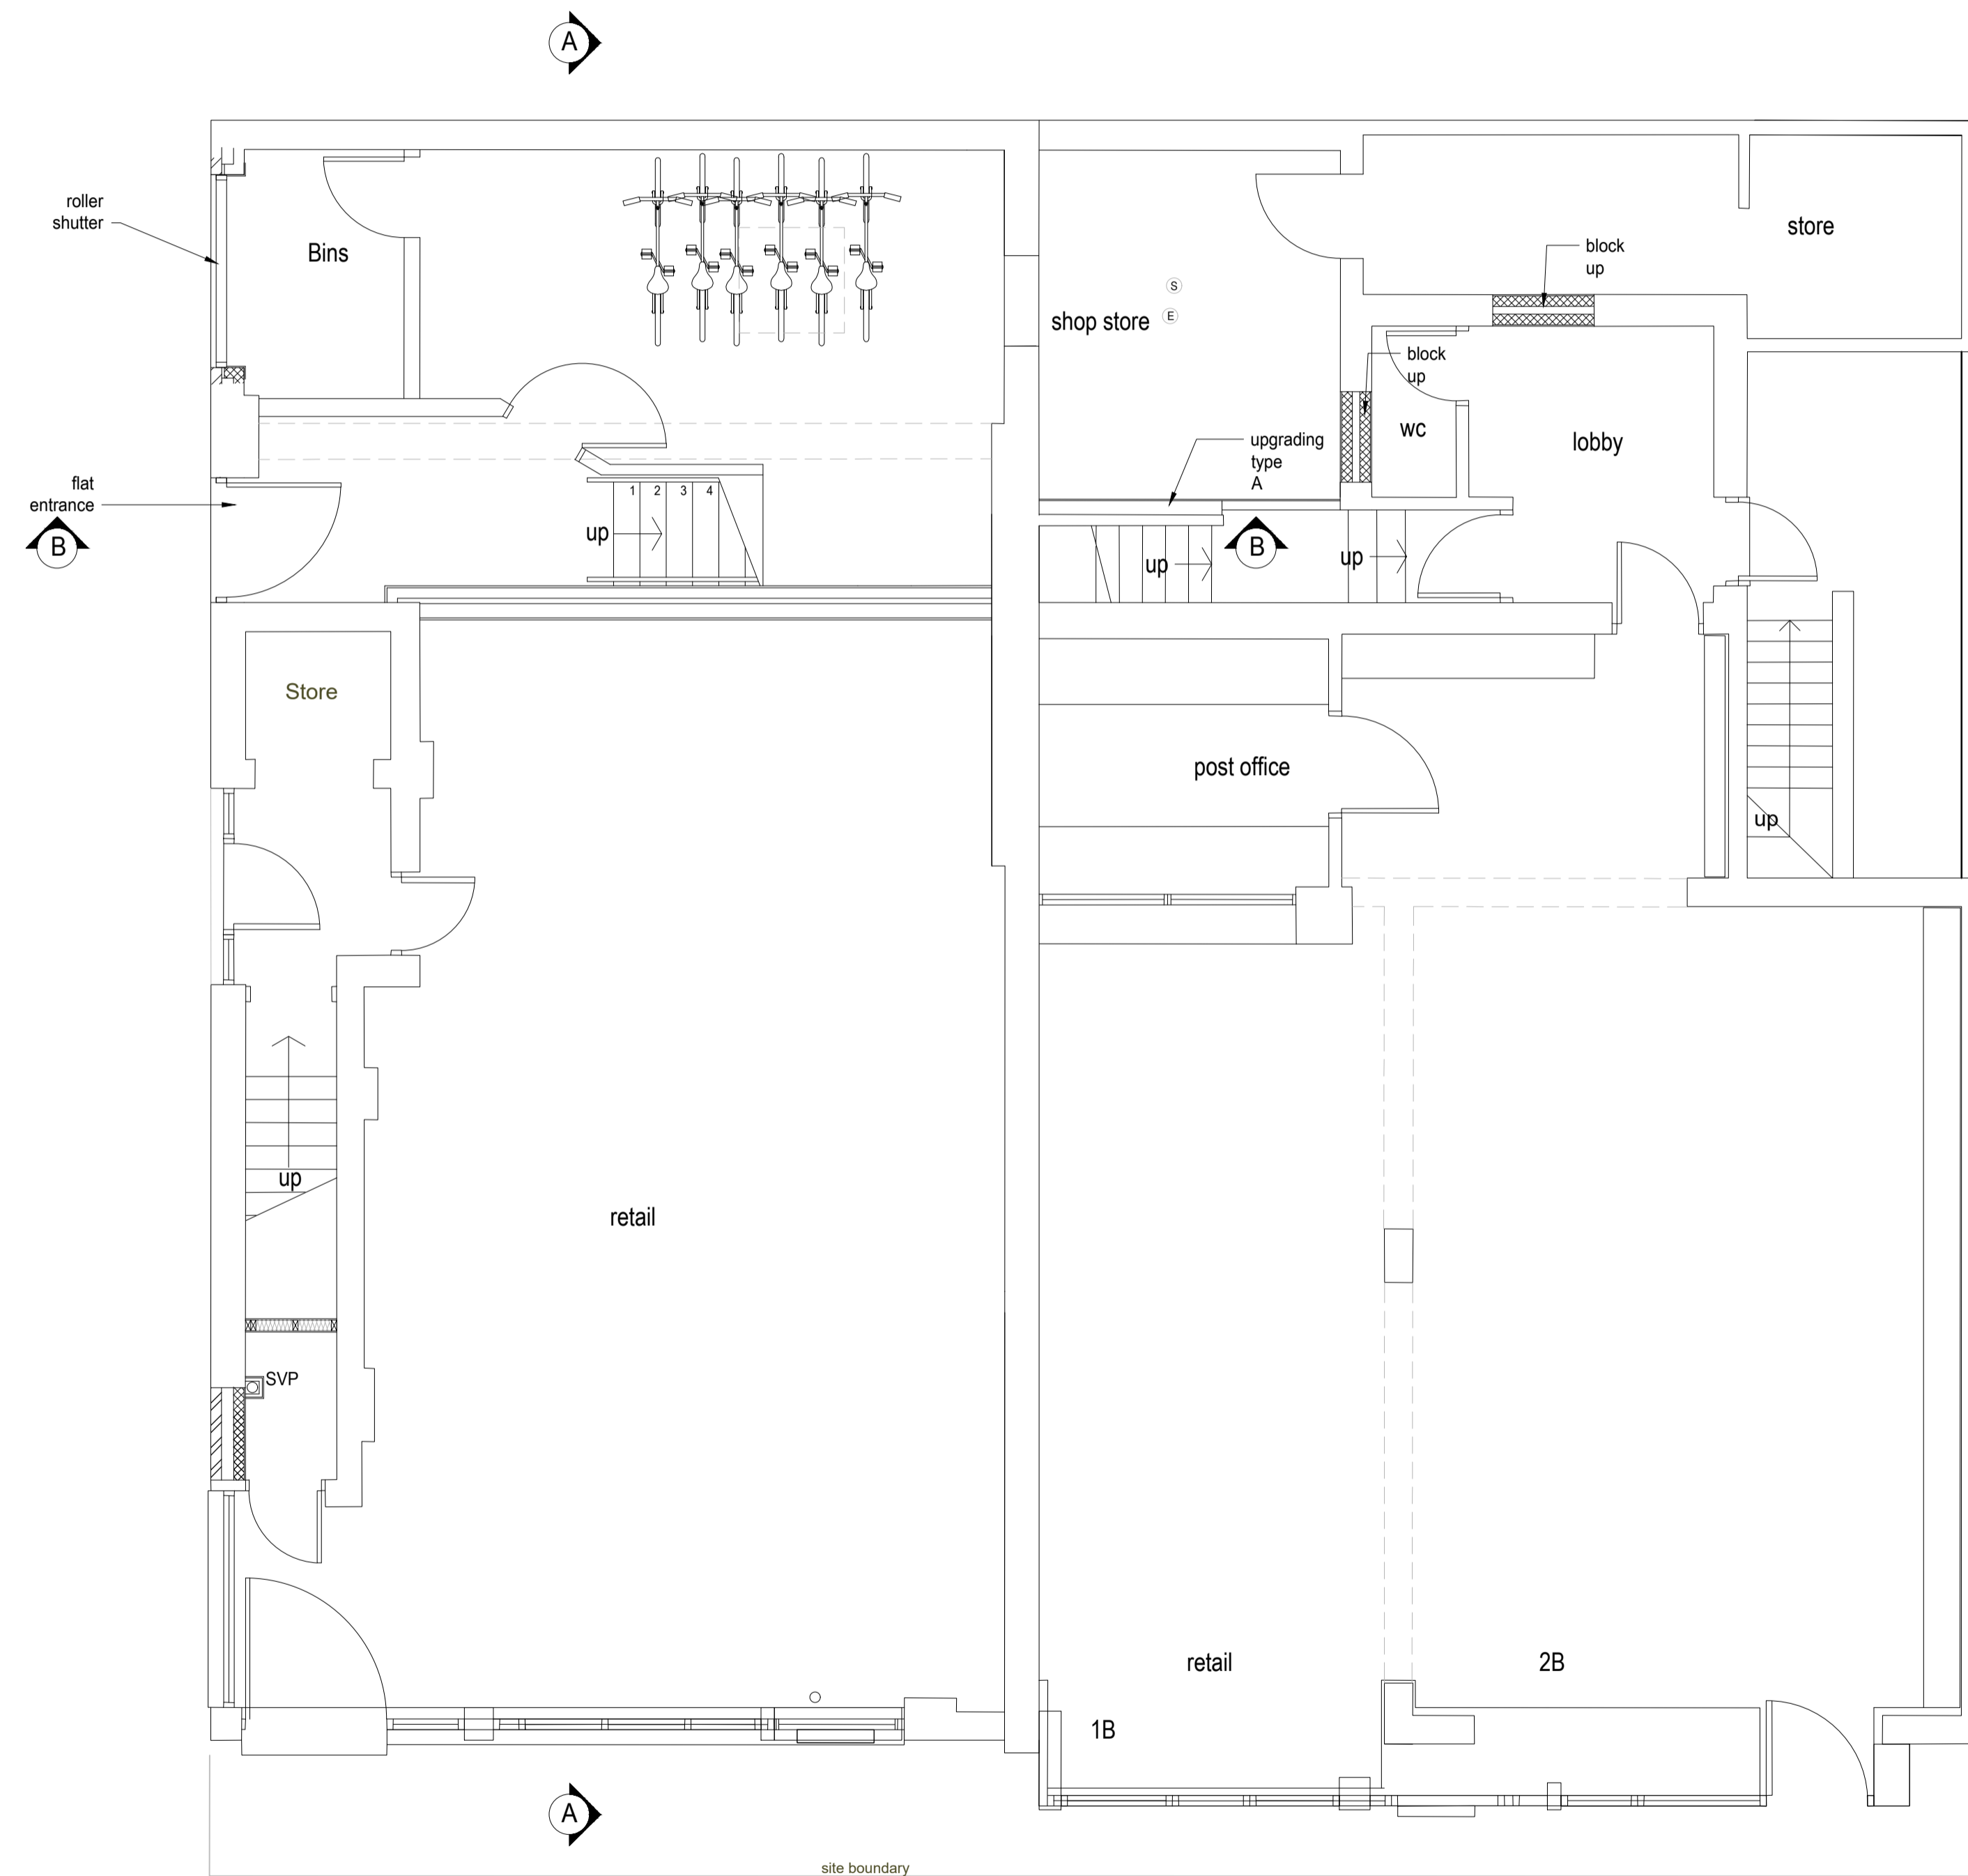

Proposed Basement Floor Plan 1:50

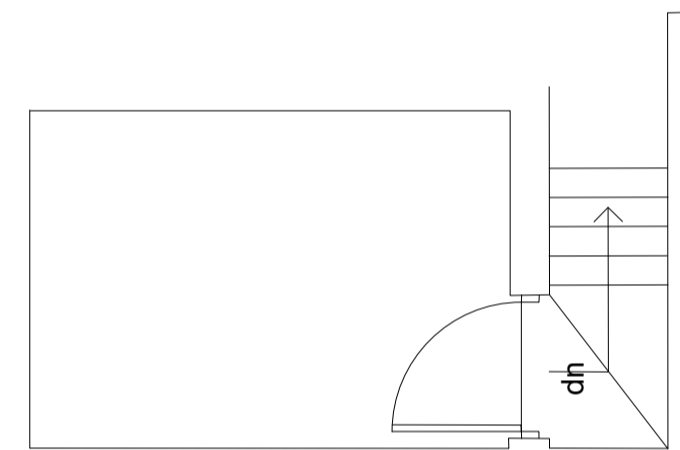

Proposed Ground Floor Plan 1:50

amendments
bpm Architectural Services Ltd.

client	Vijayaratham Thivakaran
project	1A to 2B Whitewalk Road Brighton East Sussex BN2 5FA
project ref.	2615 Drawing No. 100
drawing title	As built basement and ground floor plans
drawn by	J Boys
date	Dec 23 scale 1:50@ A1
	www.bpmnet.co.uk info@bpmnet.co.uk

1:50 0 1 2 3 4 5 6 7 8 9 10m

Do not scale off drawing, check all goods materials workmanship to all dimensions on site before all conform with current building regs BSS and COP's work is commenced