






01 - FRONT ELEVATION

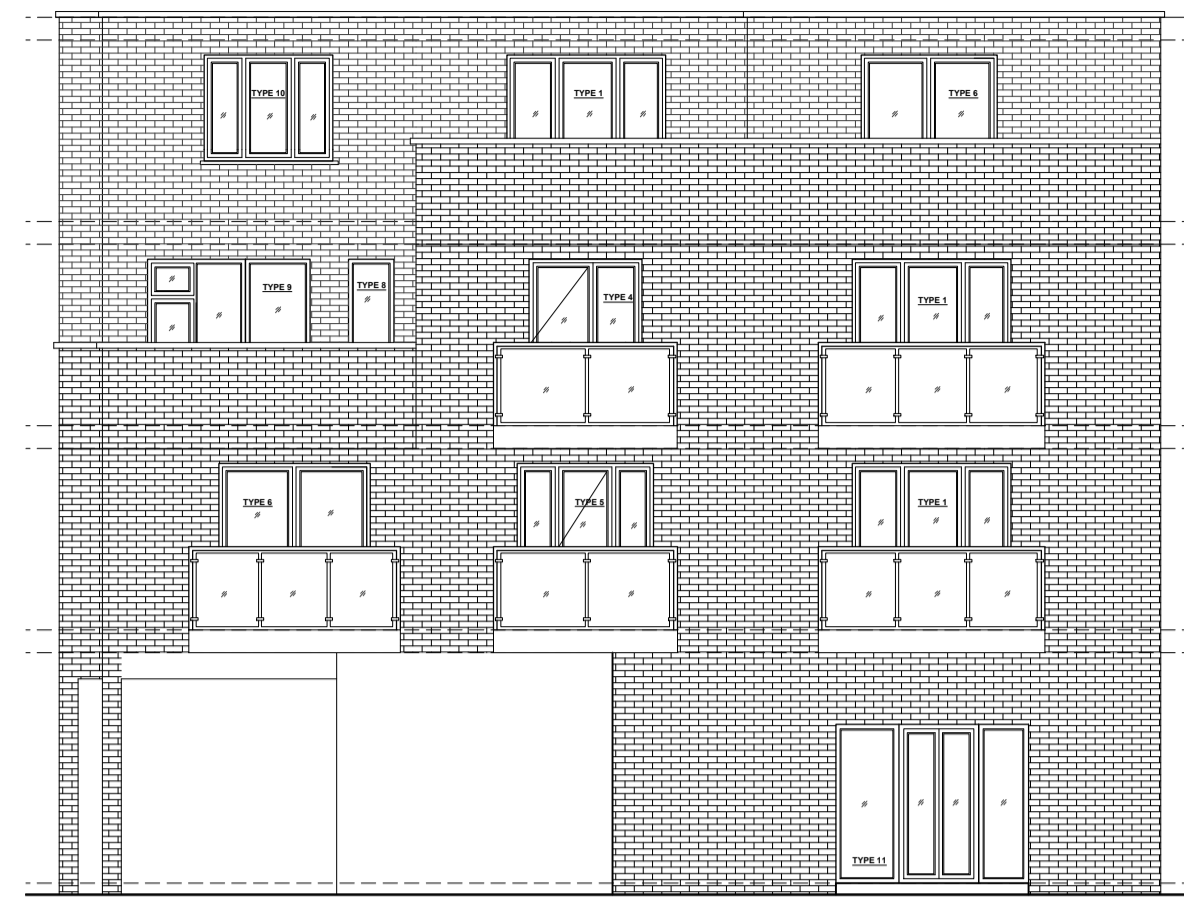

02 - REAR ELEVATION

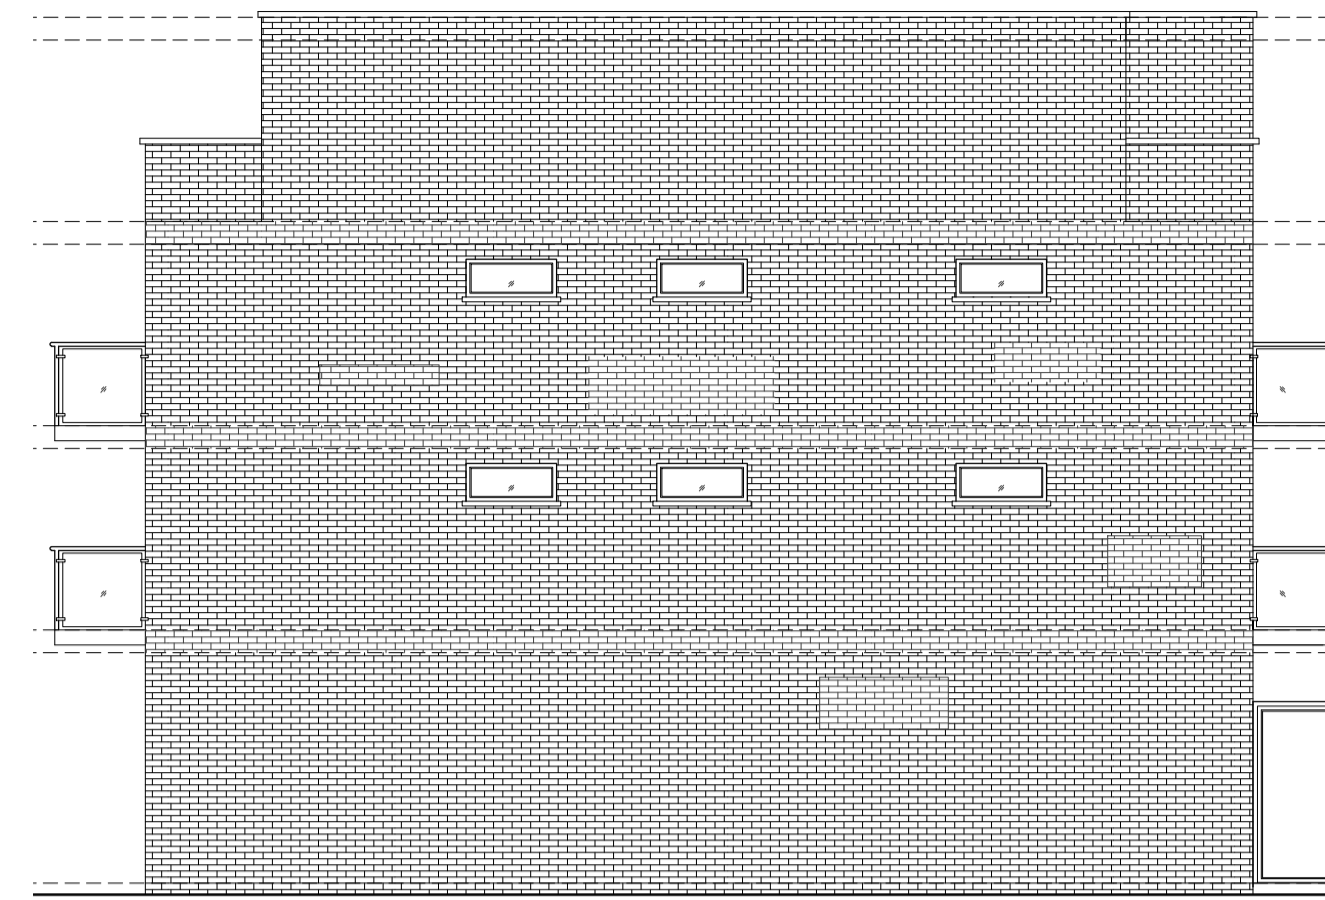

03 - LEFT SIDE ELEVATION

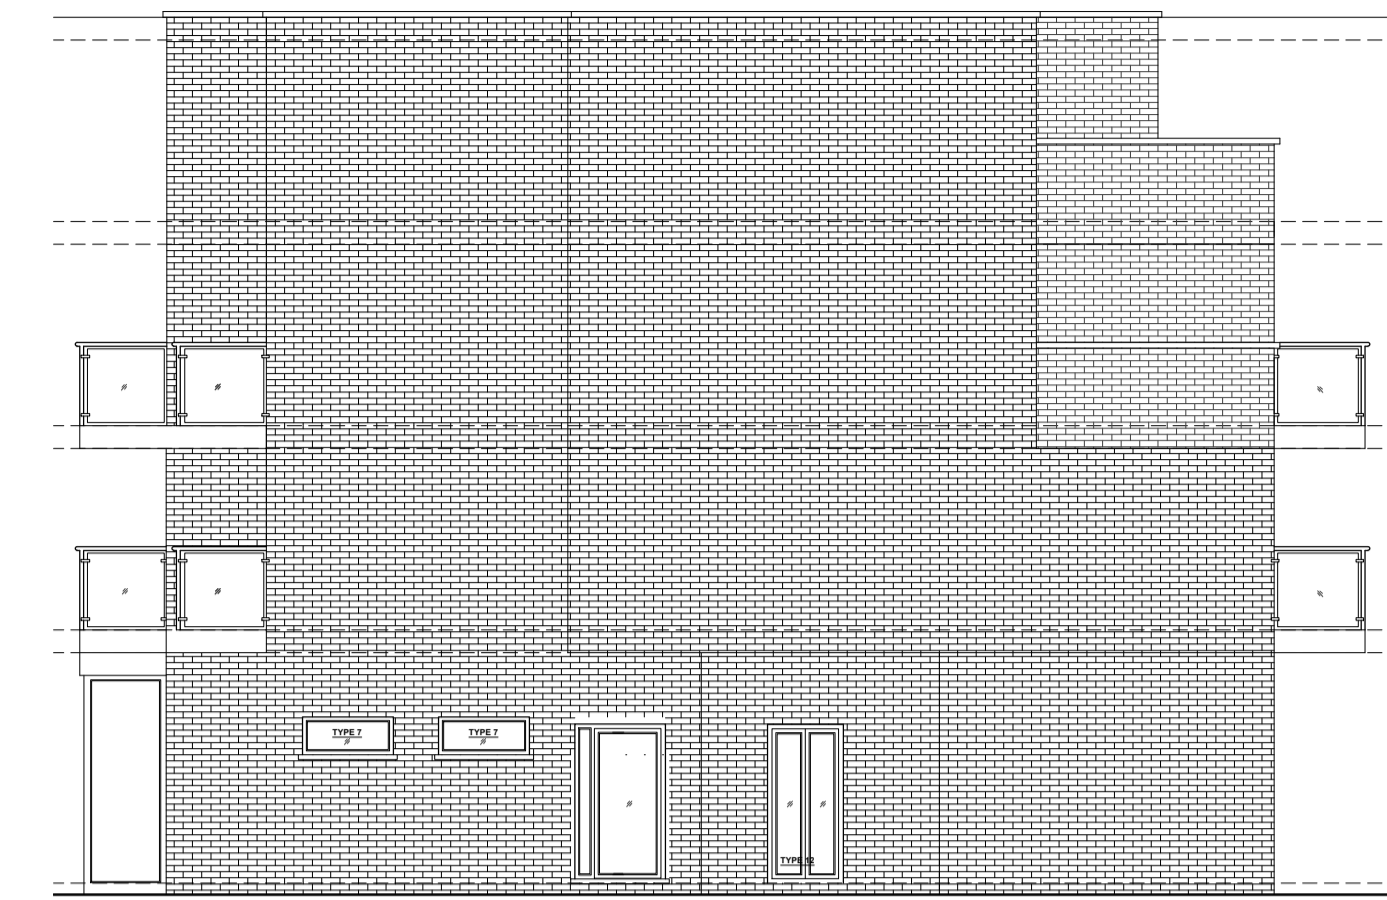

04 - RIGHT SIDE ELEVATION


**AS BUILT ELEVATIONS**




05 - FRONT ELEVATION



06 - REAR ELEVATION

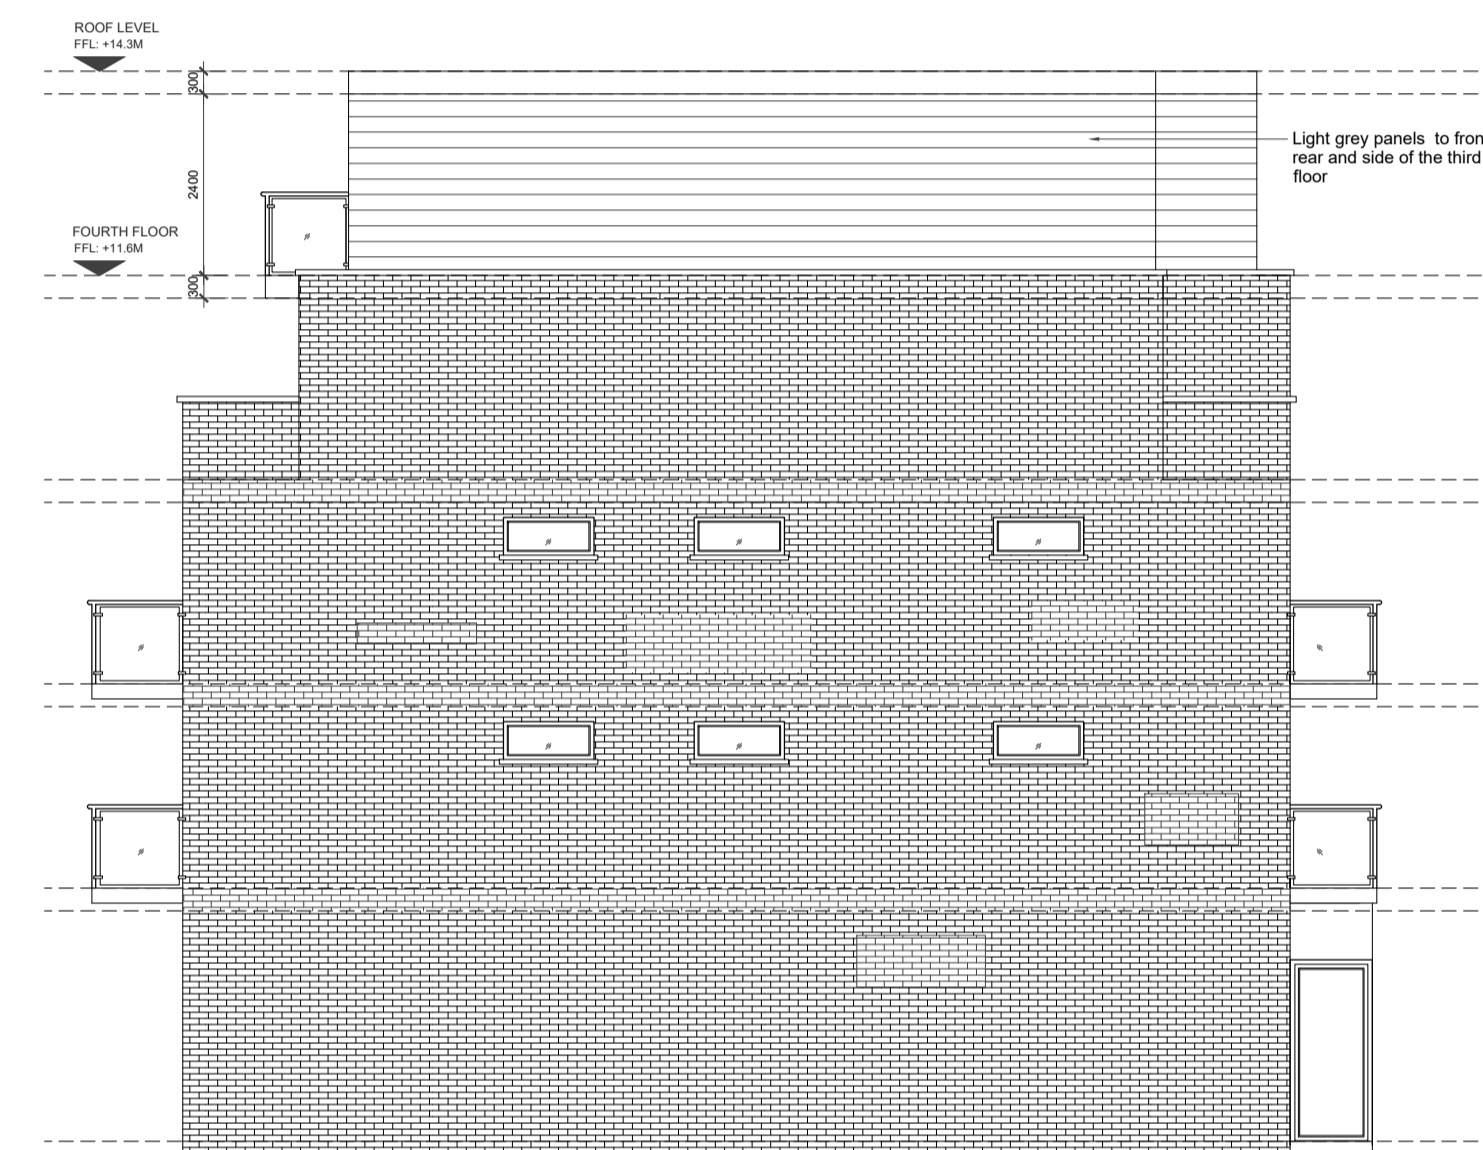


07 - LEFT SIDE ELEVATION

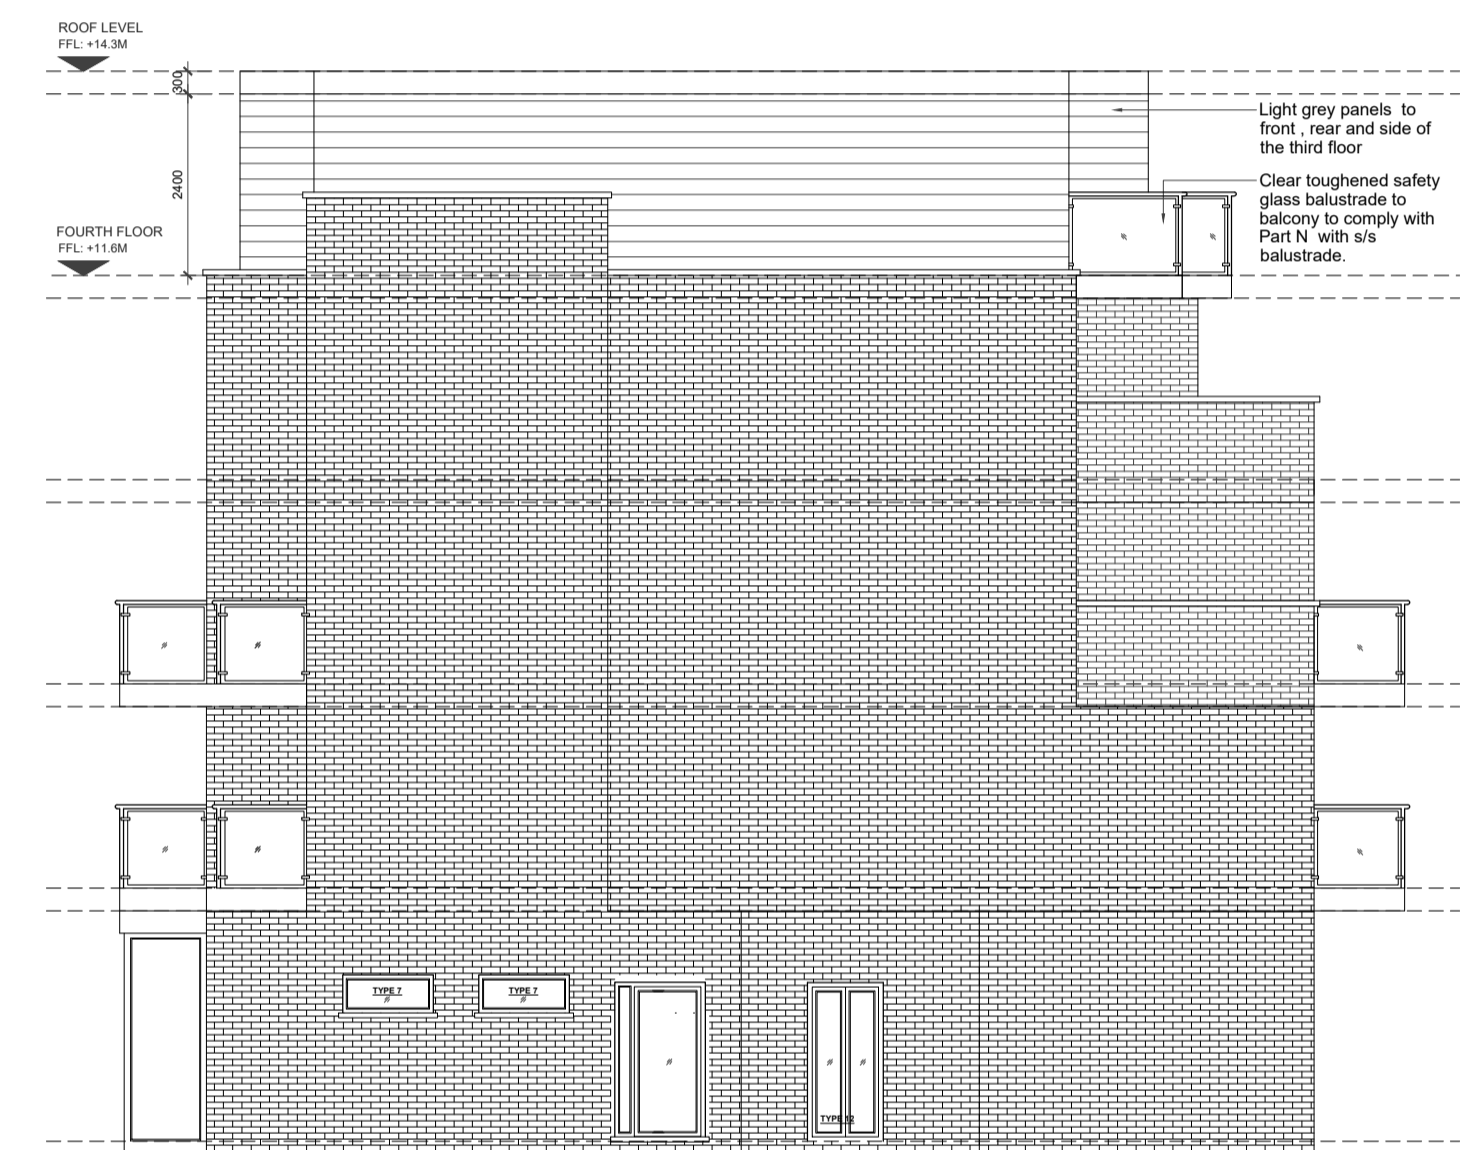


08 - RIGHT SIDE ELEVATION




09 - THIRD FLOOR PLAN

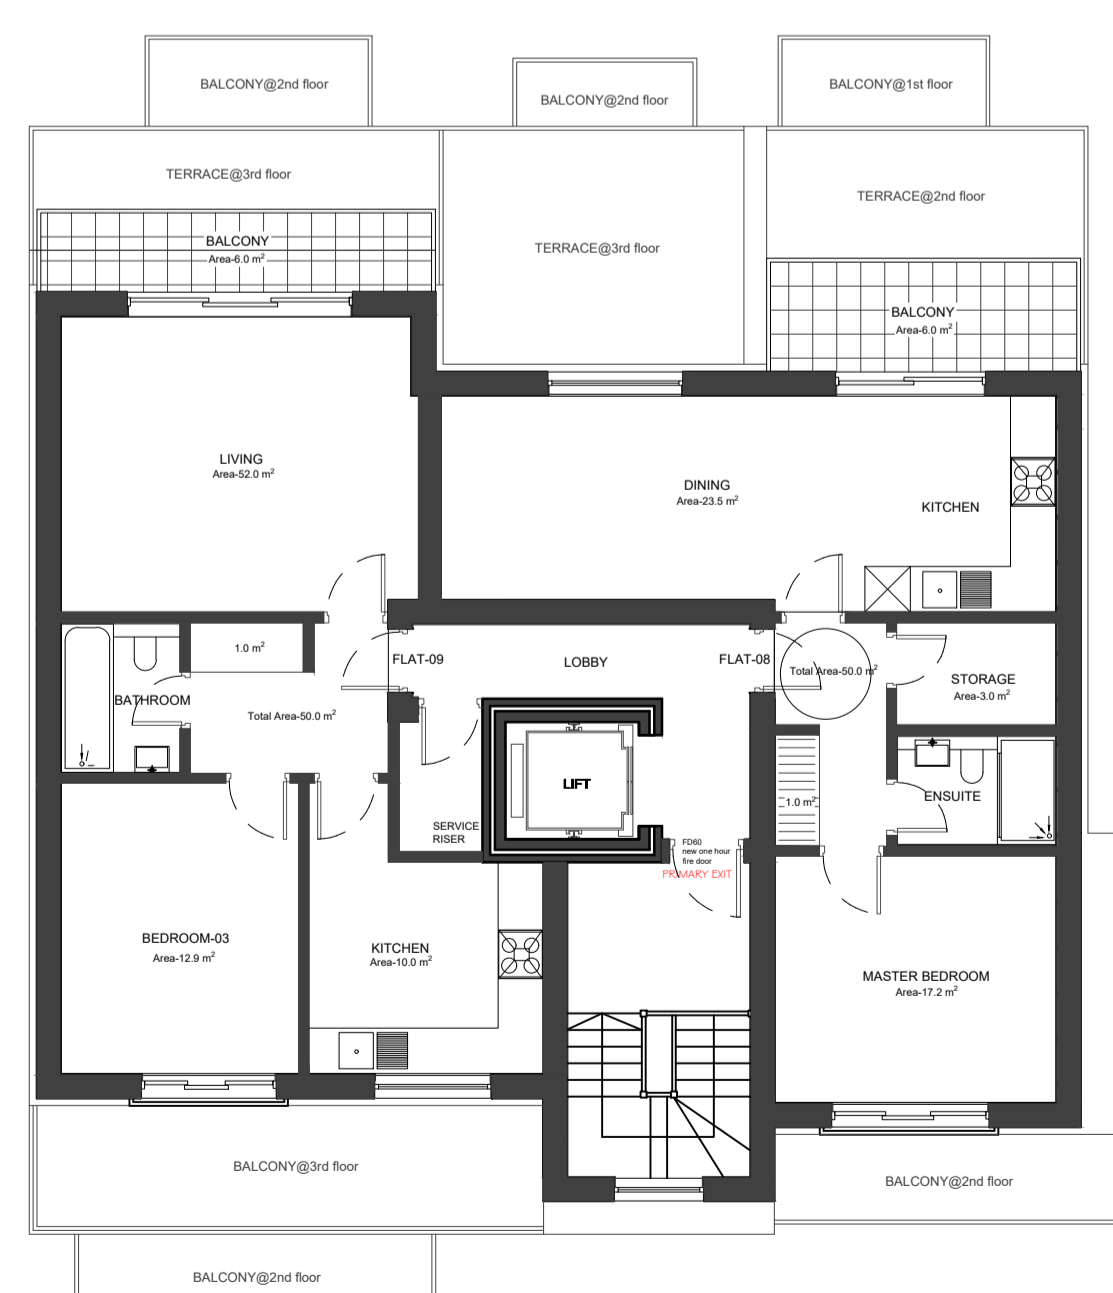

10 - FOURTH FLOOR PLAN

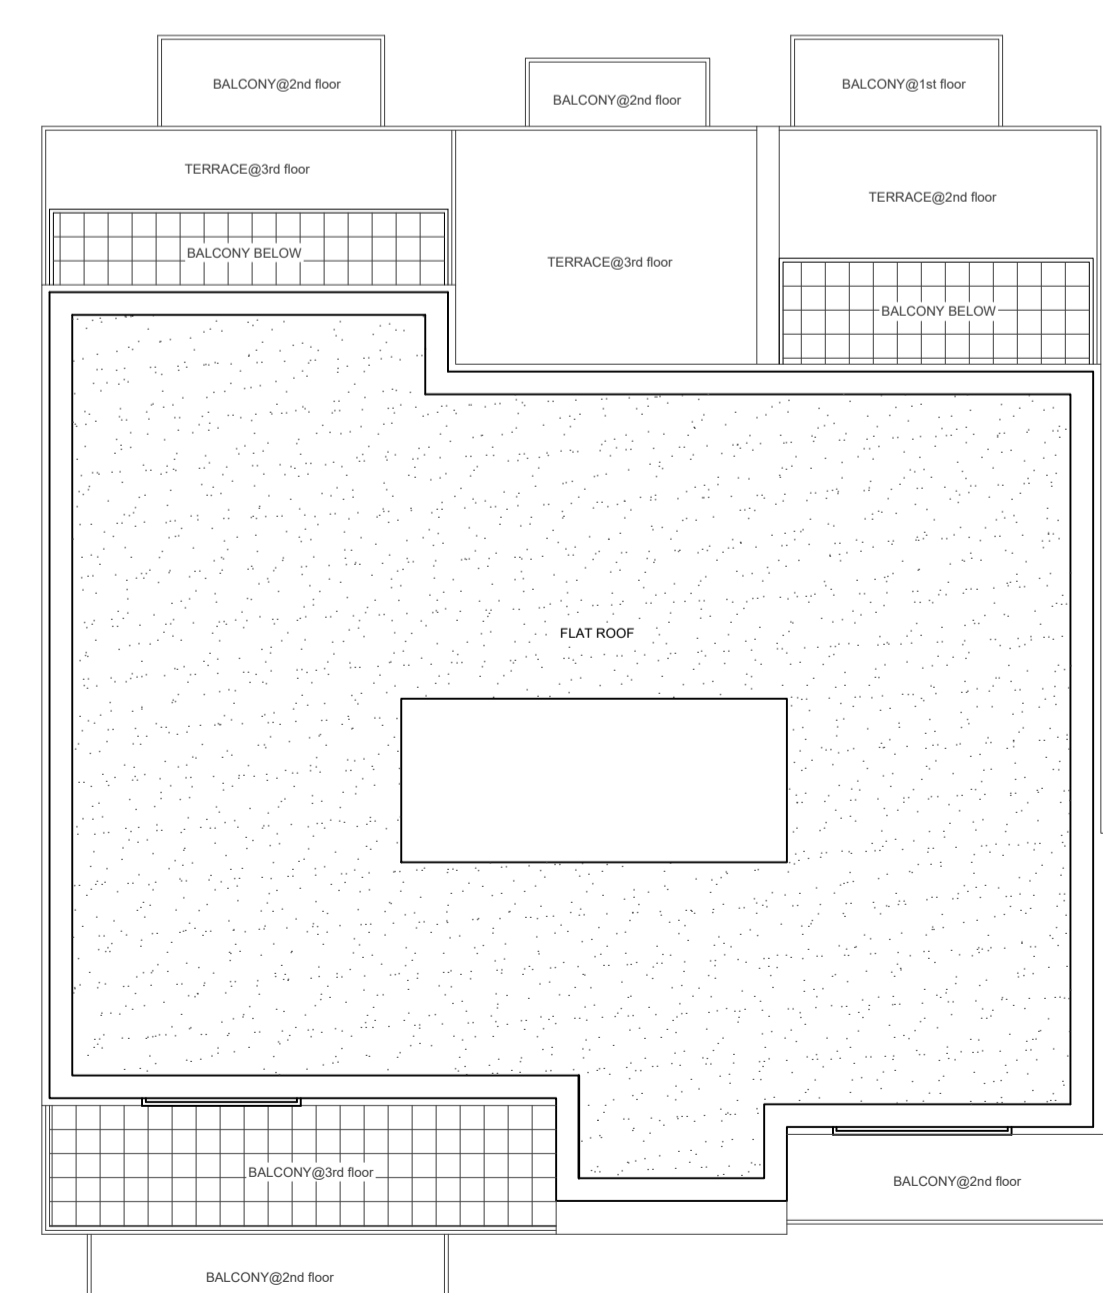

11 - ROOF PLAN

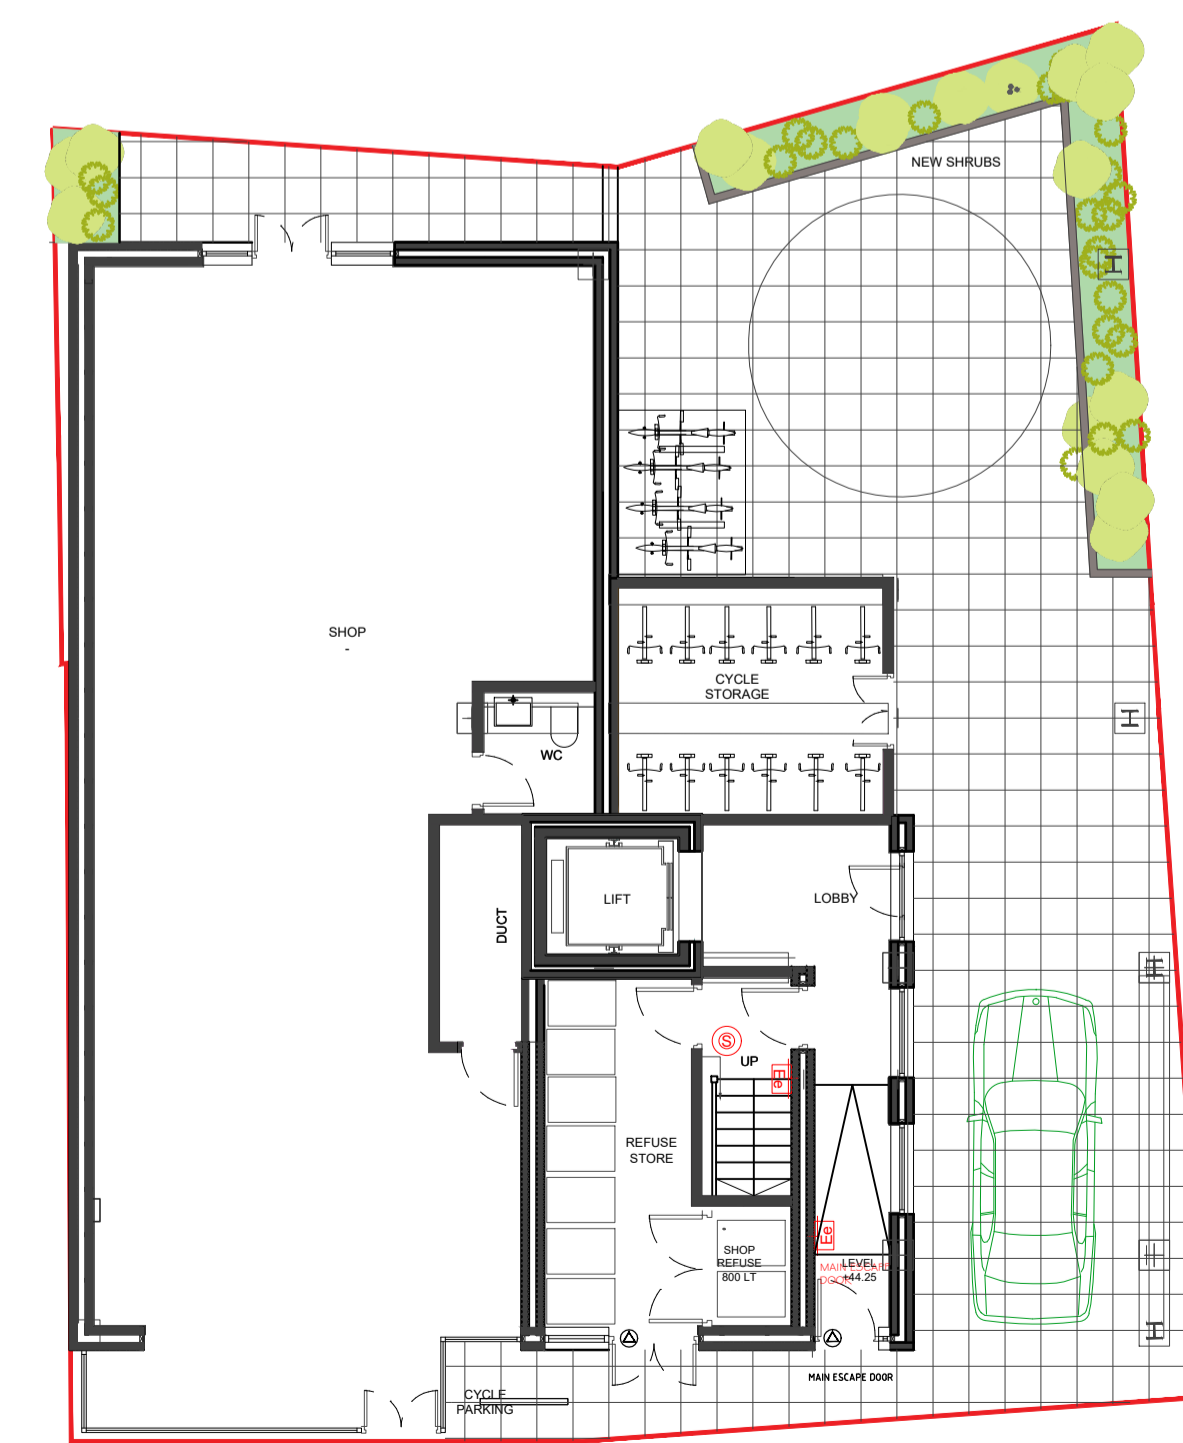

12 - GROUND FLOOR PLAN

**PROPOSED PLANS & ELEVATIONS**

REVISIONS			
NO.	DESCRIPTION	DATE	BY

**DESIGN ENDEAVOURS**  
03 BENHAM GARDENS, LONDON, TW3 2HB  
M: 07869580774, 07883602259  
E: design.endeavour@gmail.com

Project	<b>755-757 LONDON ROAD</b> LONDON, CR7 6AW		
Title	<b>AS BUILT &amp; PROPOSED PLANS &amp; ELEVATIONS</b>		
Scale	Drawn	Approved	Date
1:100@A1	FA		NOV 23
Job No.	Drawing No.	Rev.	
DAC-140/23	PF-757CR-02	-	

