





FRONT ELEVATION AS PROPOSED

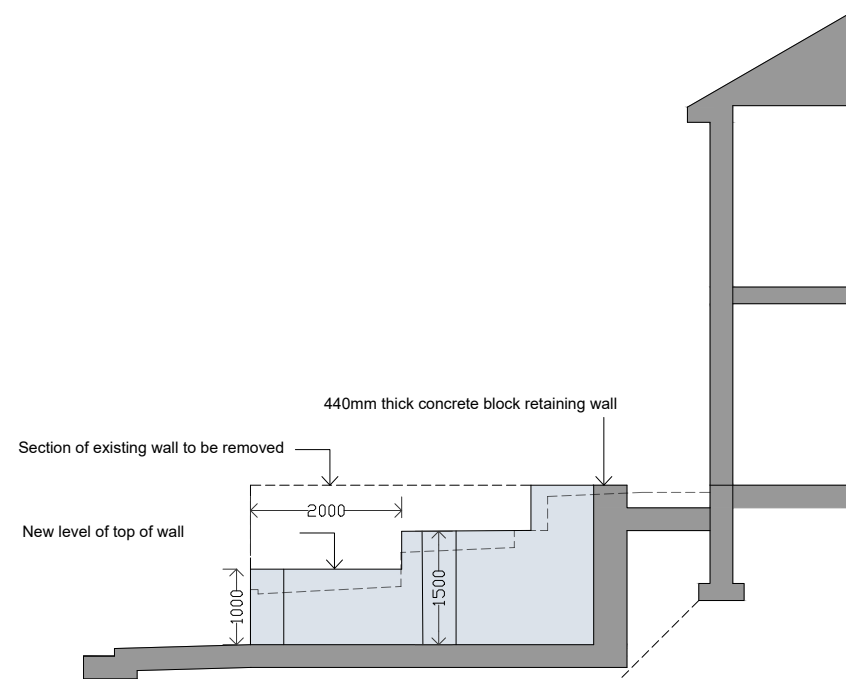


SECTION A. LOOKING SOUTH

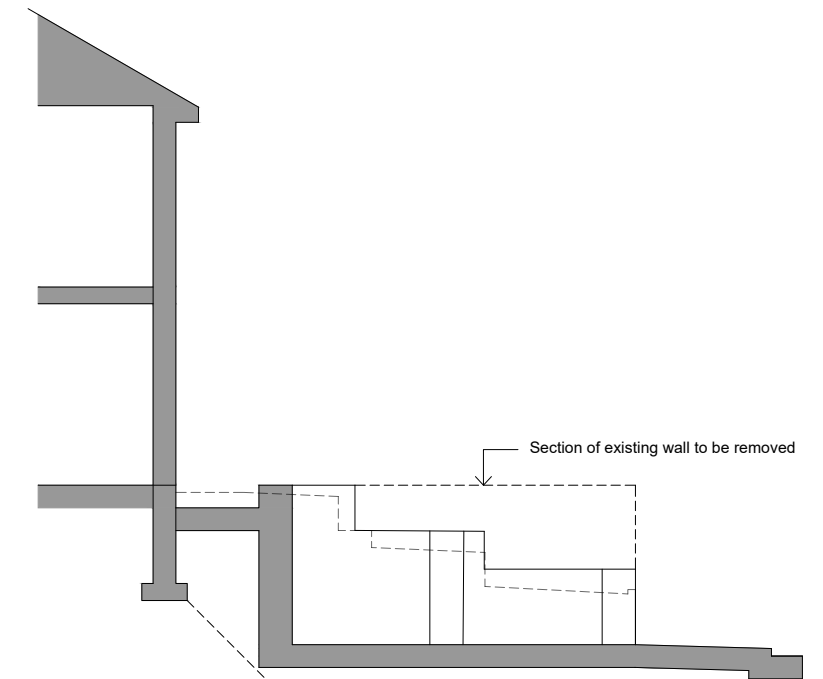


SECTION B. LOOKING NORTH


CROSS SECTIONS AND SIDE ELEVATIONS AS PROPOSED

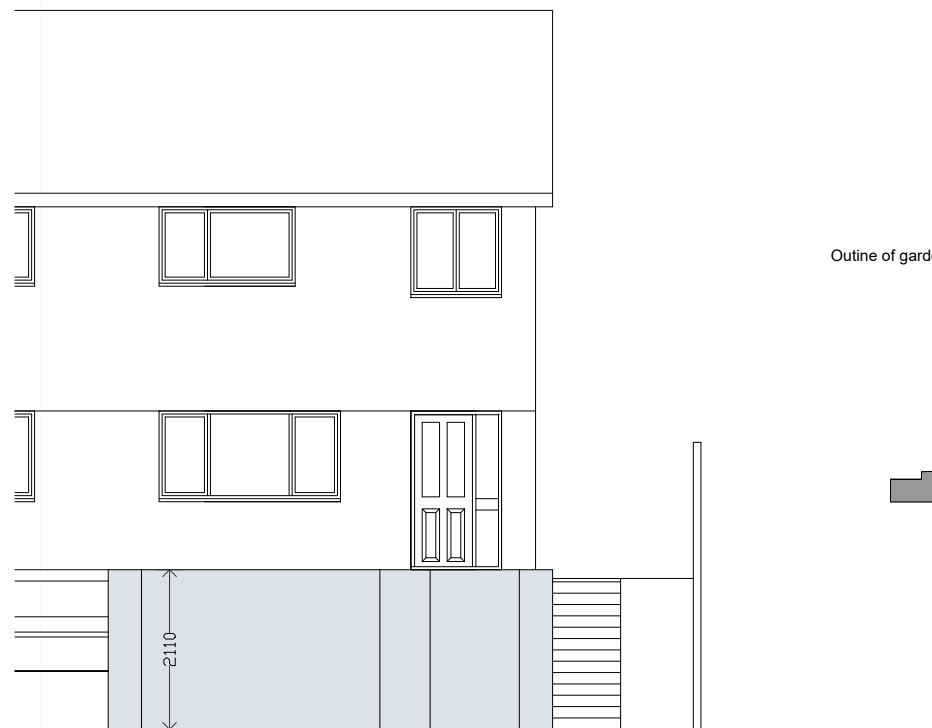

FRONT ELEVATION AS BUILT

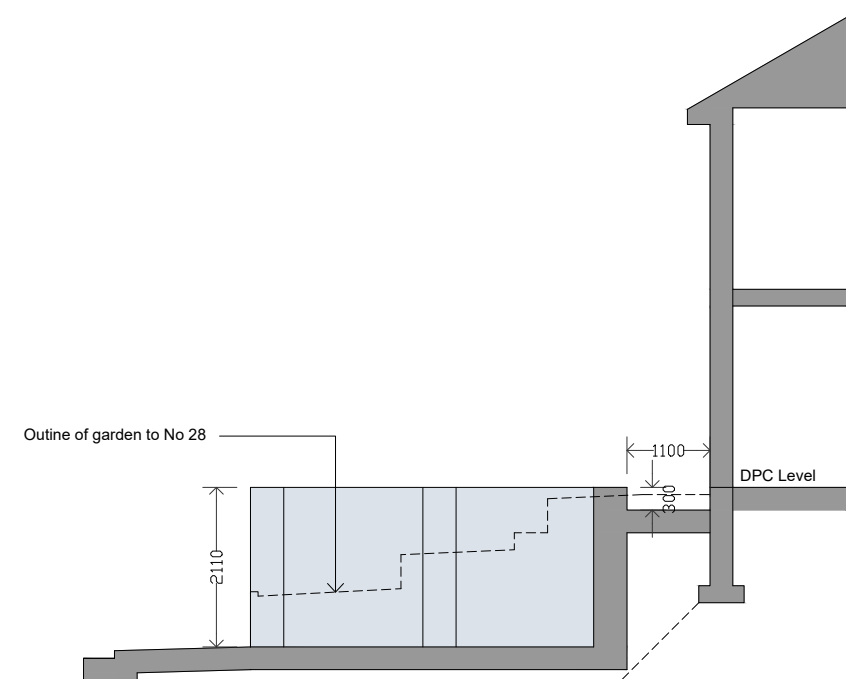

SECTION A. LOOKING SOUTH

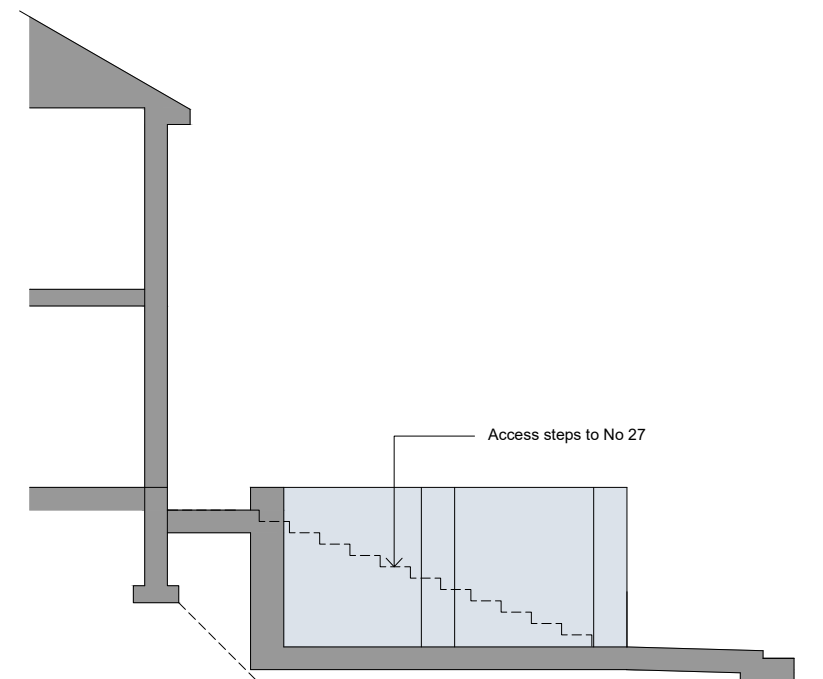

SECTION B. LOOKING NORTH

CROSS SECTIONS AND SIDE ELEVATIONS AS BUILT

**k.j.loyd** AADip. RIBA  
 CHARTERED ARCHITECT

49 Coed Y Pia, LLanbradach  
 Caerphilly, CF83 3PT

PROJECT  
 20 WHITCHURCH ROAD  
 CARDIFF  
 CF14 3LW

SCALE 1:100 @ A3 DATE JAN 2023  
 DRAWN KL DRG. NO. 03

DRAWING EXISTING AND PROPOSED ELEVATIONS AND SECTIONS

THIS DRAWING IS COPYRIGHT