


This drawing is the copyright of Elmstone Architectural Ltd. The Contractor is to check all site dimensions and levels before work commences. Do not scale from drawings. This drawing must be read with and checked against all structural and other specialist drawings, specifications and bills of quantity. Contractor is to notify Architect of any discrepancies. The contractor is to comply with all current Building Standards, Building Regulations and CDM Health and Safety Requirements whether or not specifically stated on these drawings.

Notes:
NOTE: TREE & SHRUB POSITIONS INDICATIVE ONLY
PLEASE NOTE: ONLY THE SOUTH & SOUTH WEST RELEVANT ELEVATIONS ARE BEING ALTERED & SO HAVE BEEN SURVEYED. THE CLIENT HAS PROVIDED FLOOR PLANS FOR THE INTERNAL & OTHER AREAS AND ARE INTENDED FOR INDICATIVE REFERENCE PURPOSES ONLY

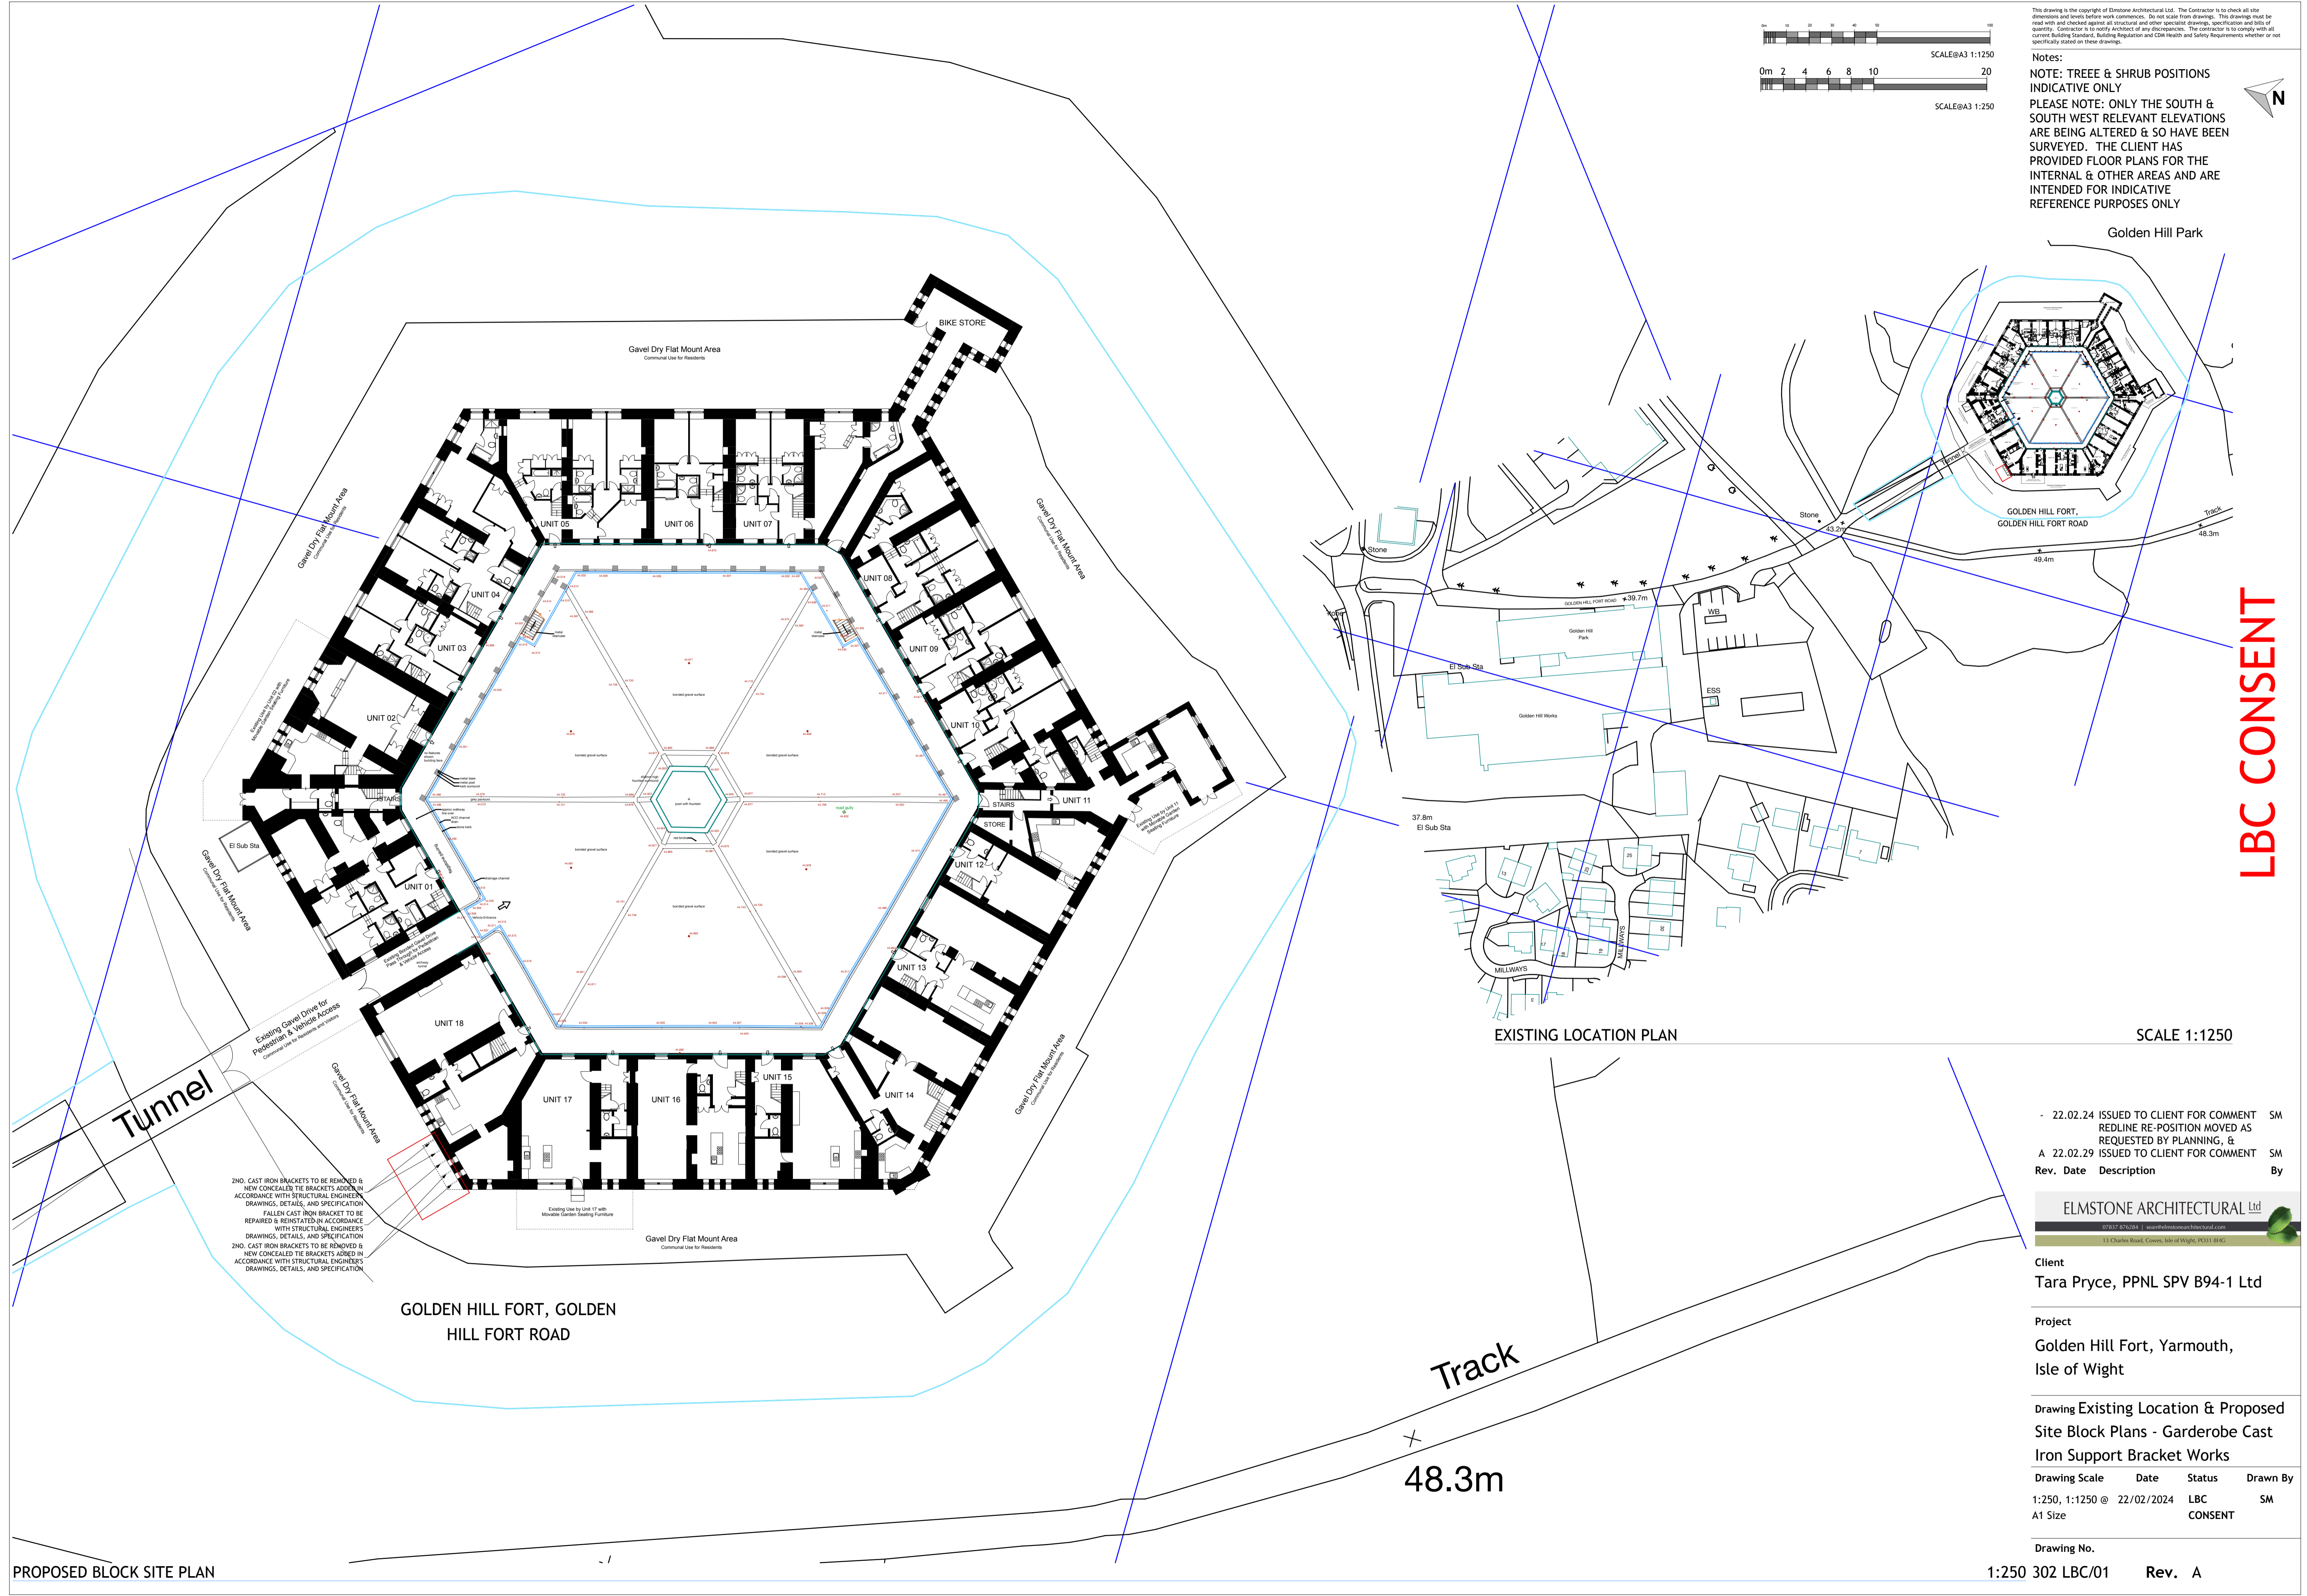

2ND. CAST IRON BRACKETS TO BE REMOVED & NEW CONCEALED TIE BRACKETS ADDED IN ACCORDANCE WITH STRUCTURAL ENGINEER'S DRAWINGS, DETAILS, AND SPECIFICATION
 FALLEN CAST IRON BRACKET TO BE REPAIRED & REINSTATED IN ACCORDANCE WITH STRUCTURAL ENGINEER'S DRAWINGS, DETAILS, AND SPECIFICATION
 2ND. CAST IRON BRACKETS TO BE REMOVED & NEW CONCEALED TIE BRACKETS ADDED IN ACCORDANCE WITH STRUCTURAL ENGINEER'S DRAWINGS, DETAILS, AND SPECIFICATION

Rev.	Date	Description	By
-	22.02.24	ISSUED TO CLIENT FOR COMMENT REDLINE RE-POSITION MOVED AS REQUESTED BY PLANNING, &	SM
A	22.02.29	ISSUED TO CLIENT FOR COMMENT	SM

ELMSTONE ARCHITECTURAL Ltd
 07937 476264 | www.elmstonearchitectural.com
 13 Charles Road, Cowes, Isle of Wight, PO31 8HG

Client
 Tara Pryce, PPNL SPV B94-1 Ltd

Project
 Golden Hill Fort, Yarmouth, Isle of Wight

Drawing Existing Location & Proposed Site Block Plans - Garderobe Cast Iron Support Bracket Works

Drawing Scale	Date	Status	Drawn By
1:250, 1:1250 @ A1 Size	22/02/2024	LBC CONSENT	SM

Drawing No.
 1:250 302 LBC/01 **Rev. A**