
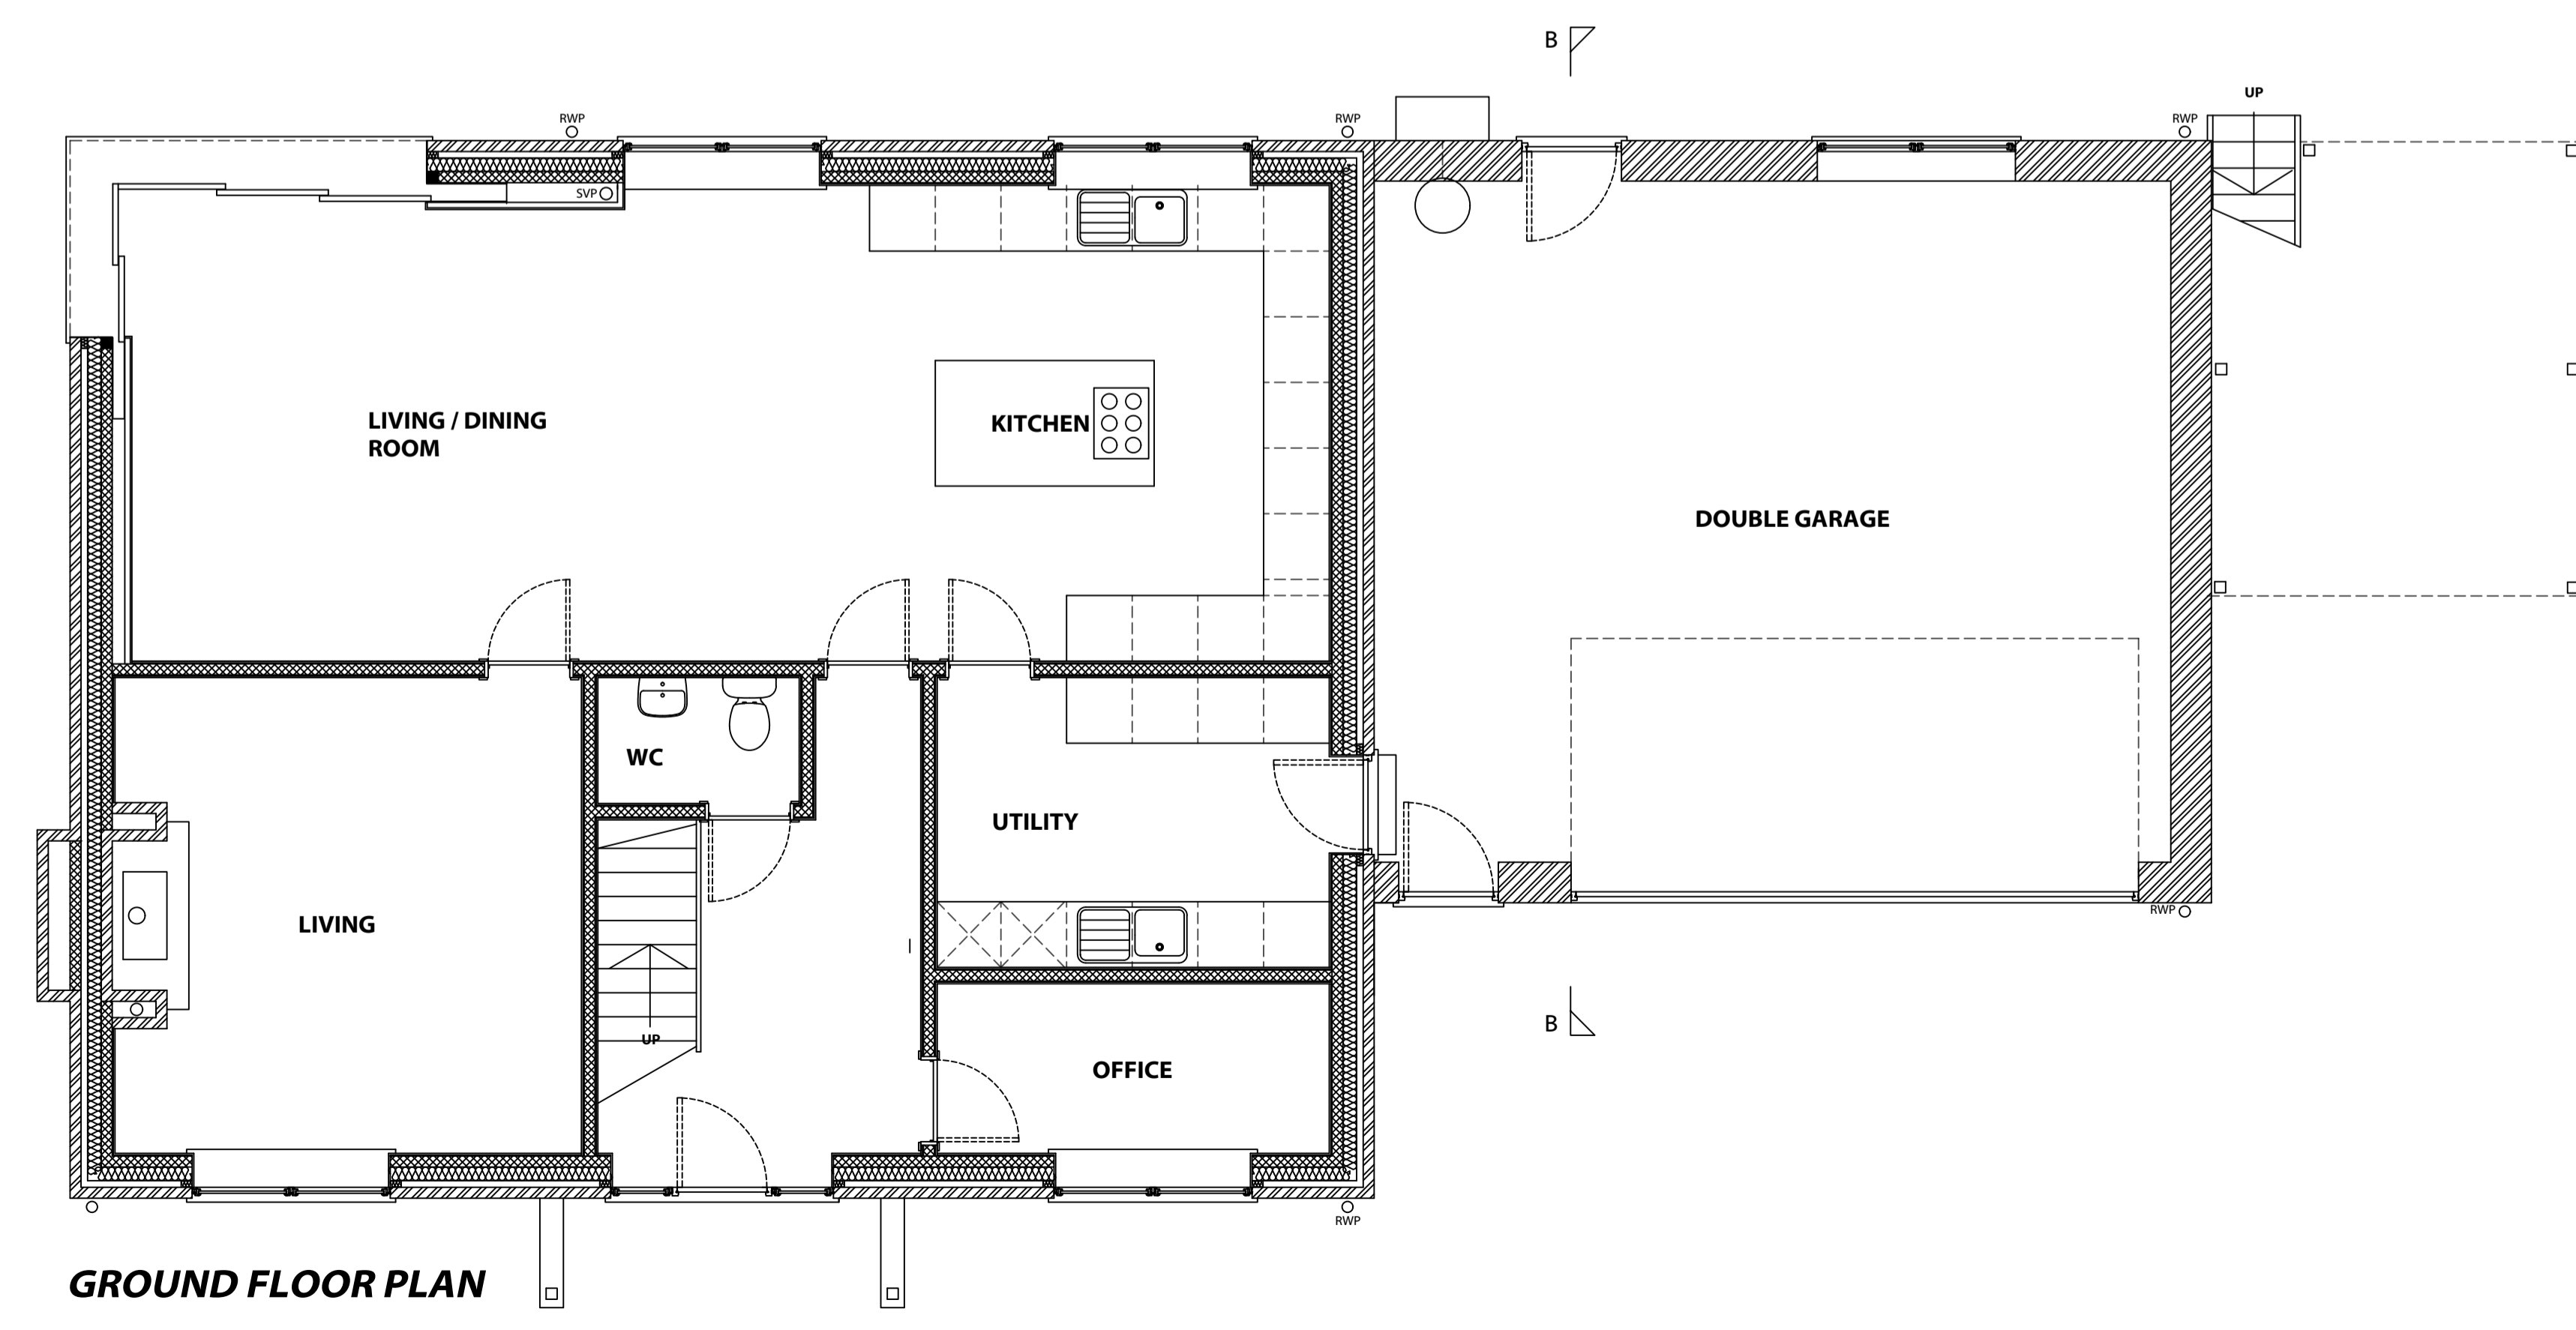


This drawing is COPYRIGHT. It must not be reproduced or disclosed to third parties without our prior permission. Do not scale from this drawing, or interrogate and use electronic information. Any discrepancies should be reported immediately. Any surveyed information incorporated within this drawing cannot be guaranteed as accurate unless confirmed by a fixed dimension. All dimensions are in millimetres unless noted otherwise.

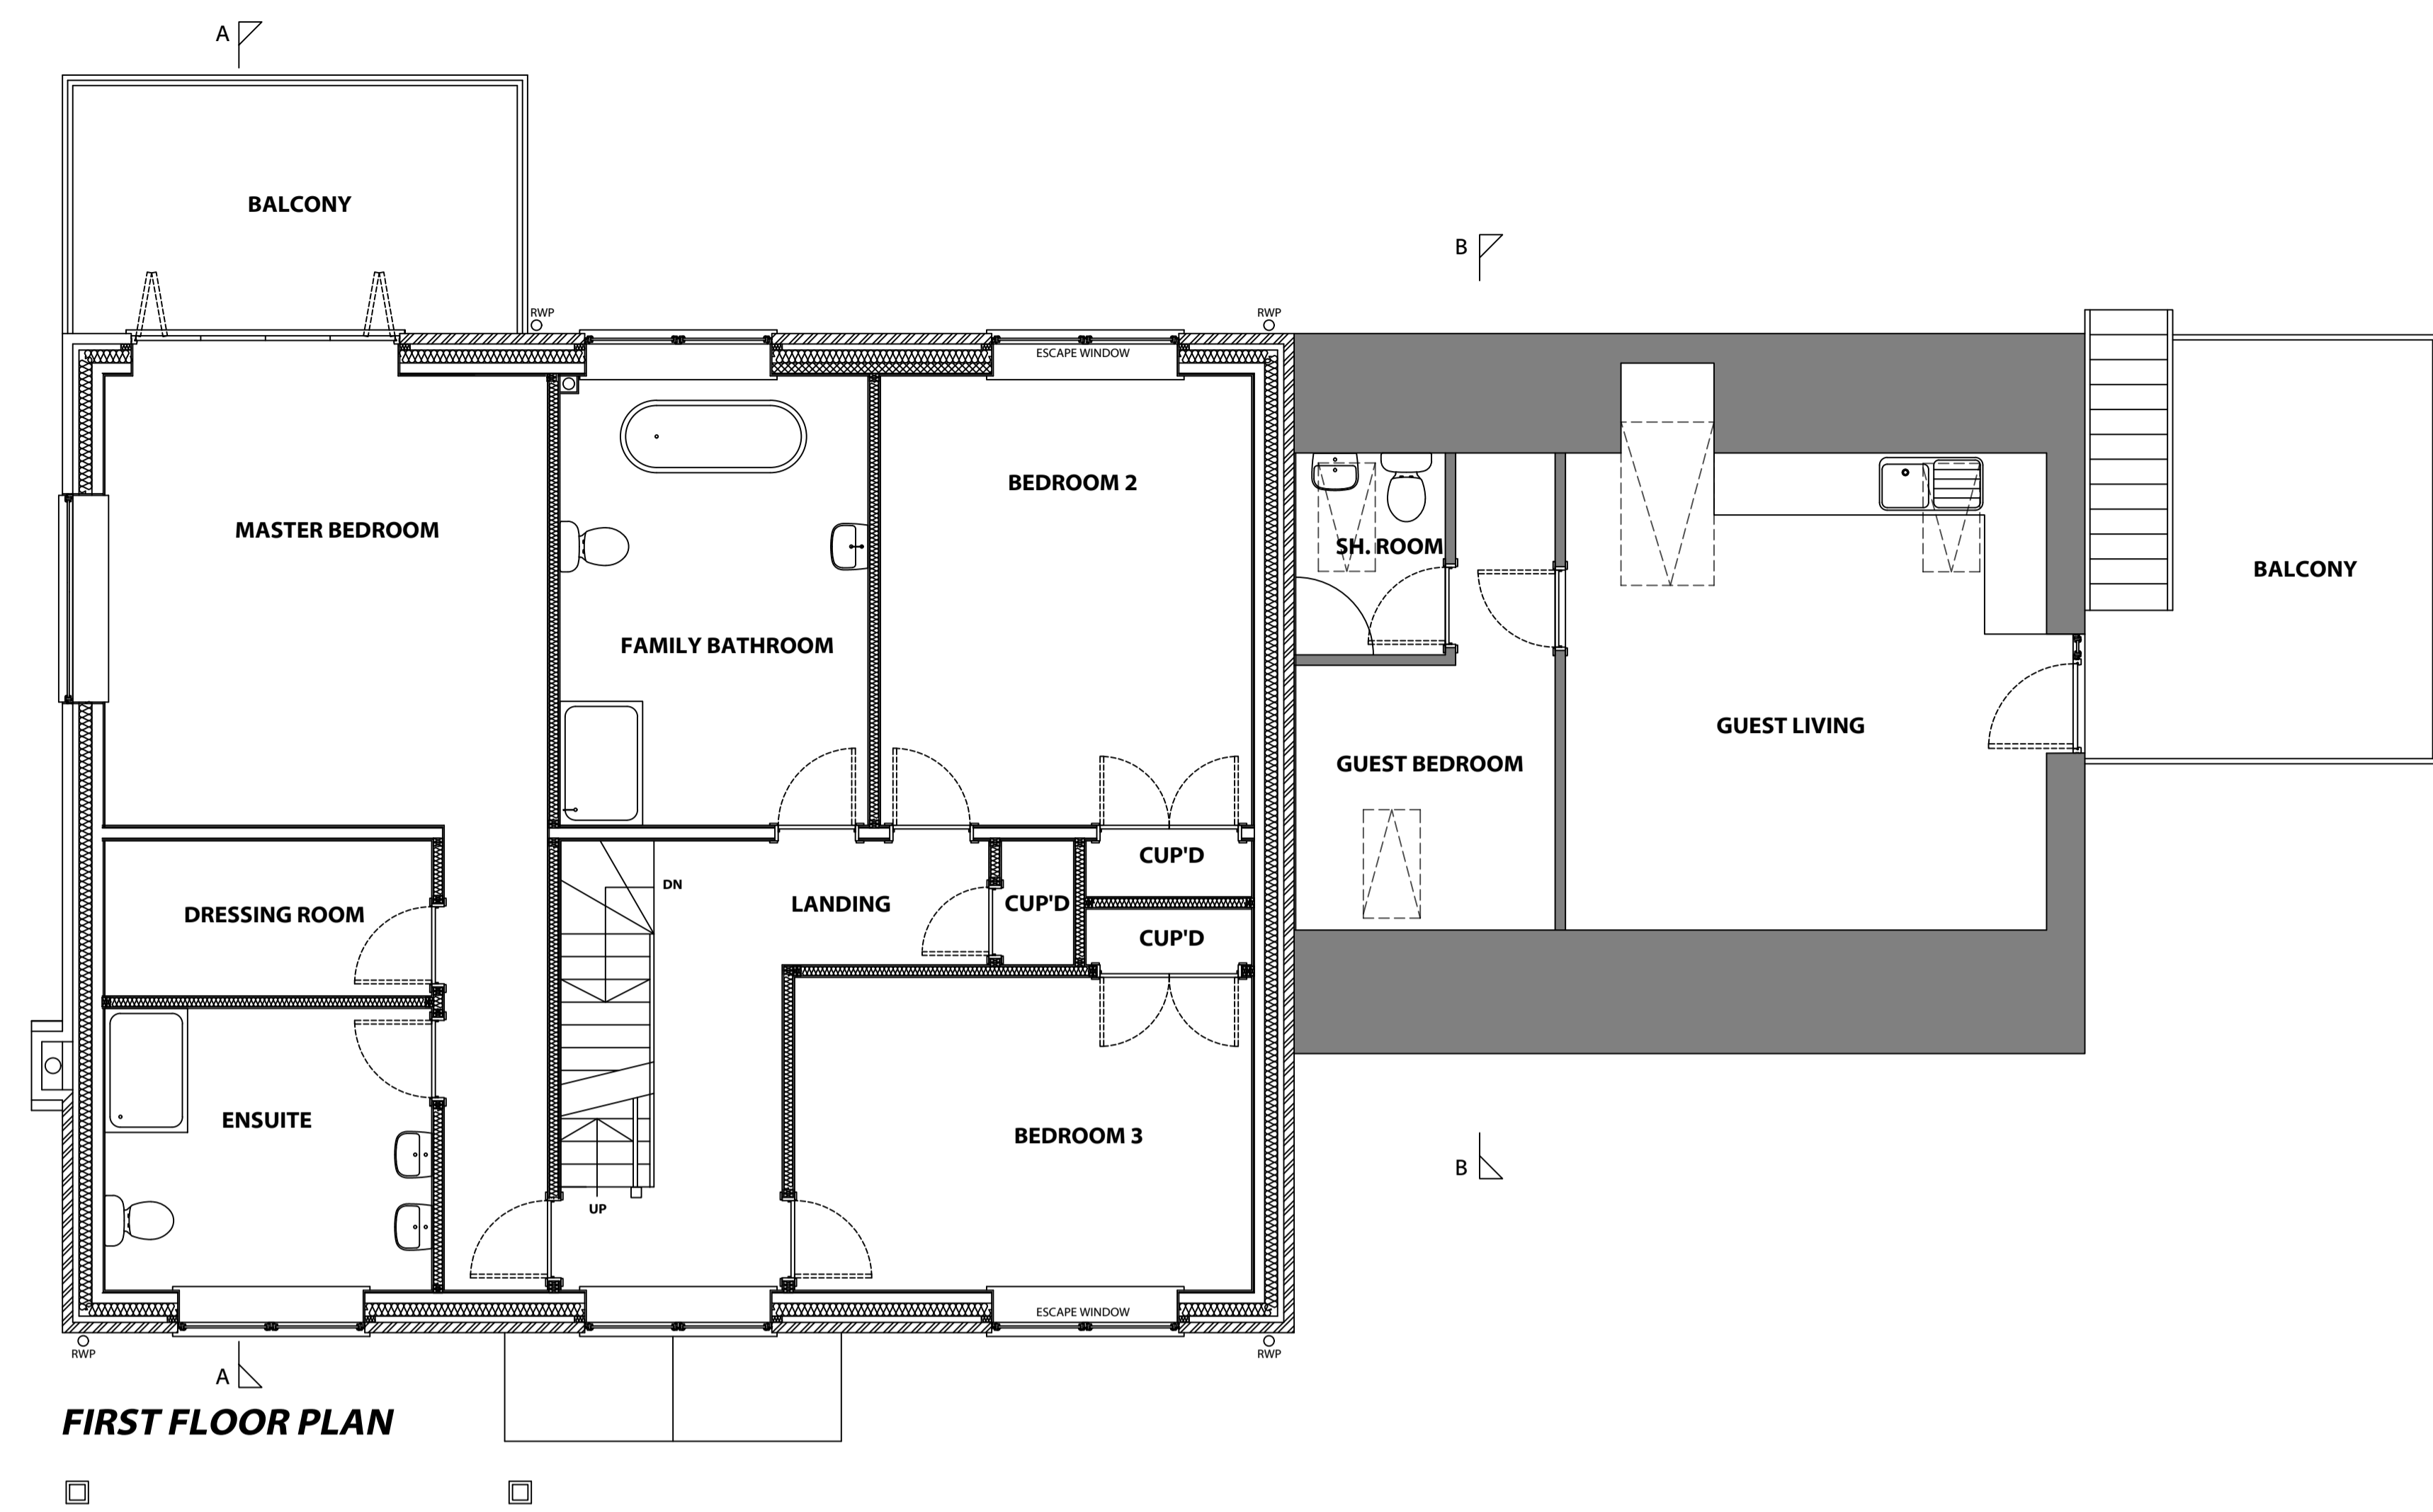

Project :- Dwelling at Glyn View, Gravels Bank, Minsterley		Drawing Title :- As Built Ground & First Floor Plans	
Drawing Status :- Stage 6: As Built		Drawing No :- Z002.6.1.100	
Scale :- 1:100@A3	Date :- 26.01.24	Rev :-	A
Drawn by :- GD	Checked :- RL		