




This drawing is COPYRIGHT. It must not be reproduced or disclosed to third parties without our prior permission. Do not scale from this drawing, or interrogate and use electronic information. Any discrepancies should be reported immediately. Any surveyed information incorporated within this drawing cannot be guaranteed as accurate unless confirmed by a fixed dimension. All dimensions are in millimetres unless noted otherwise.

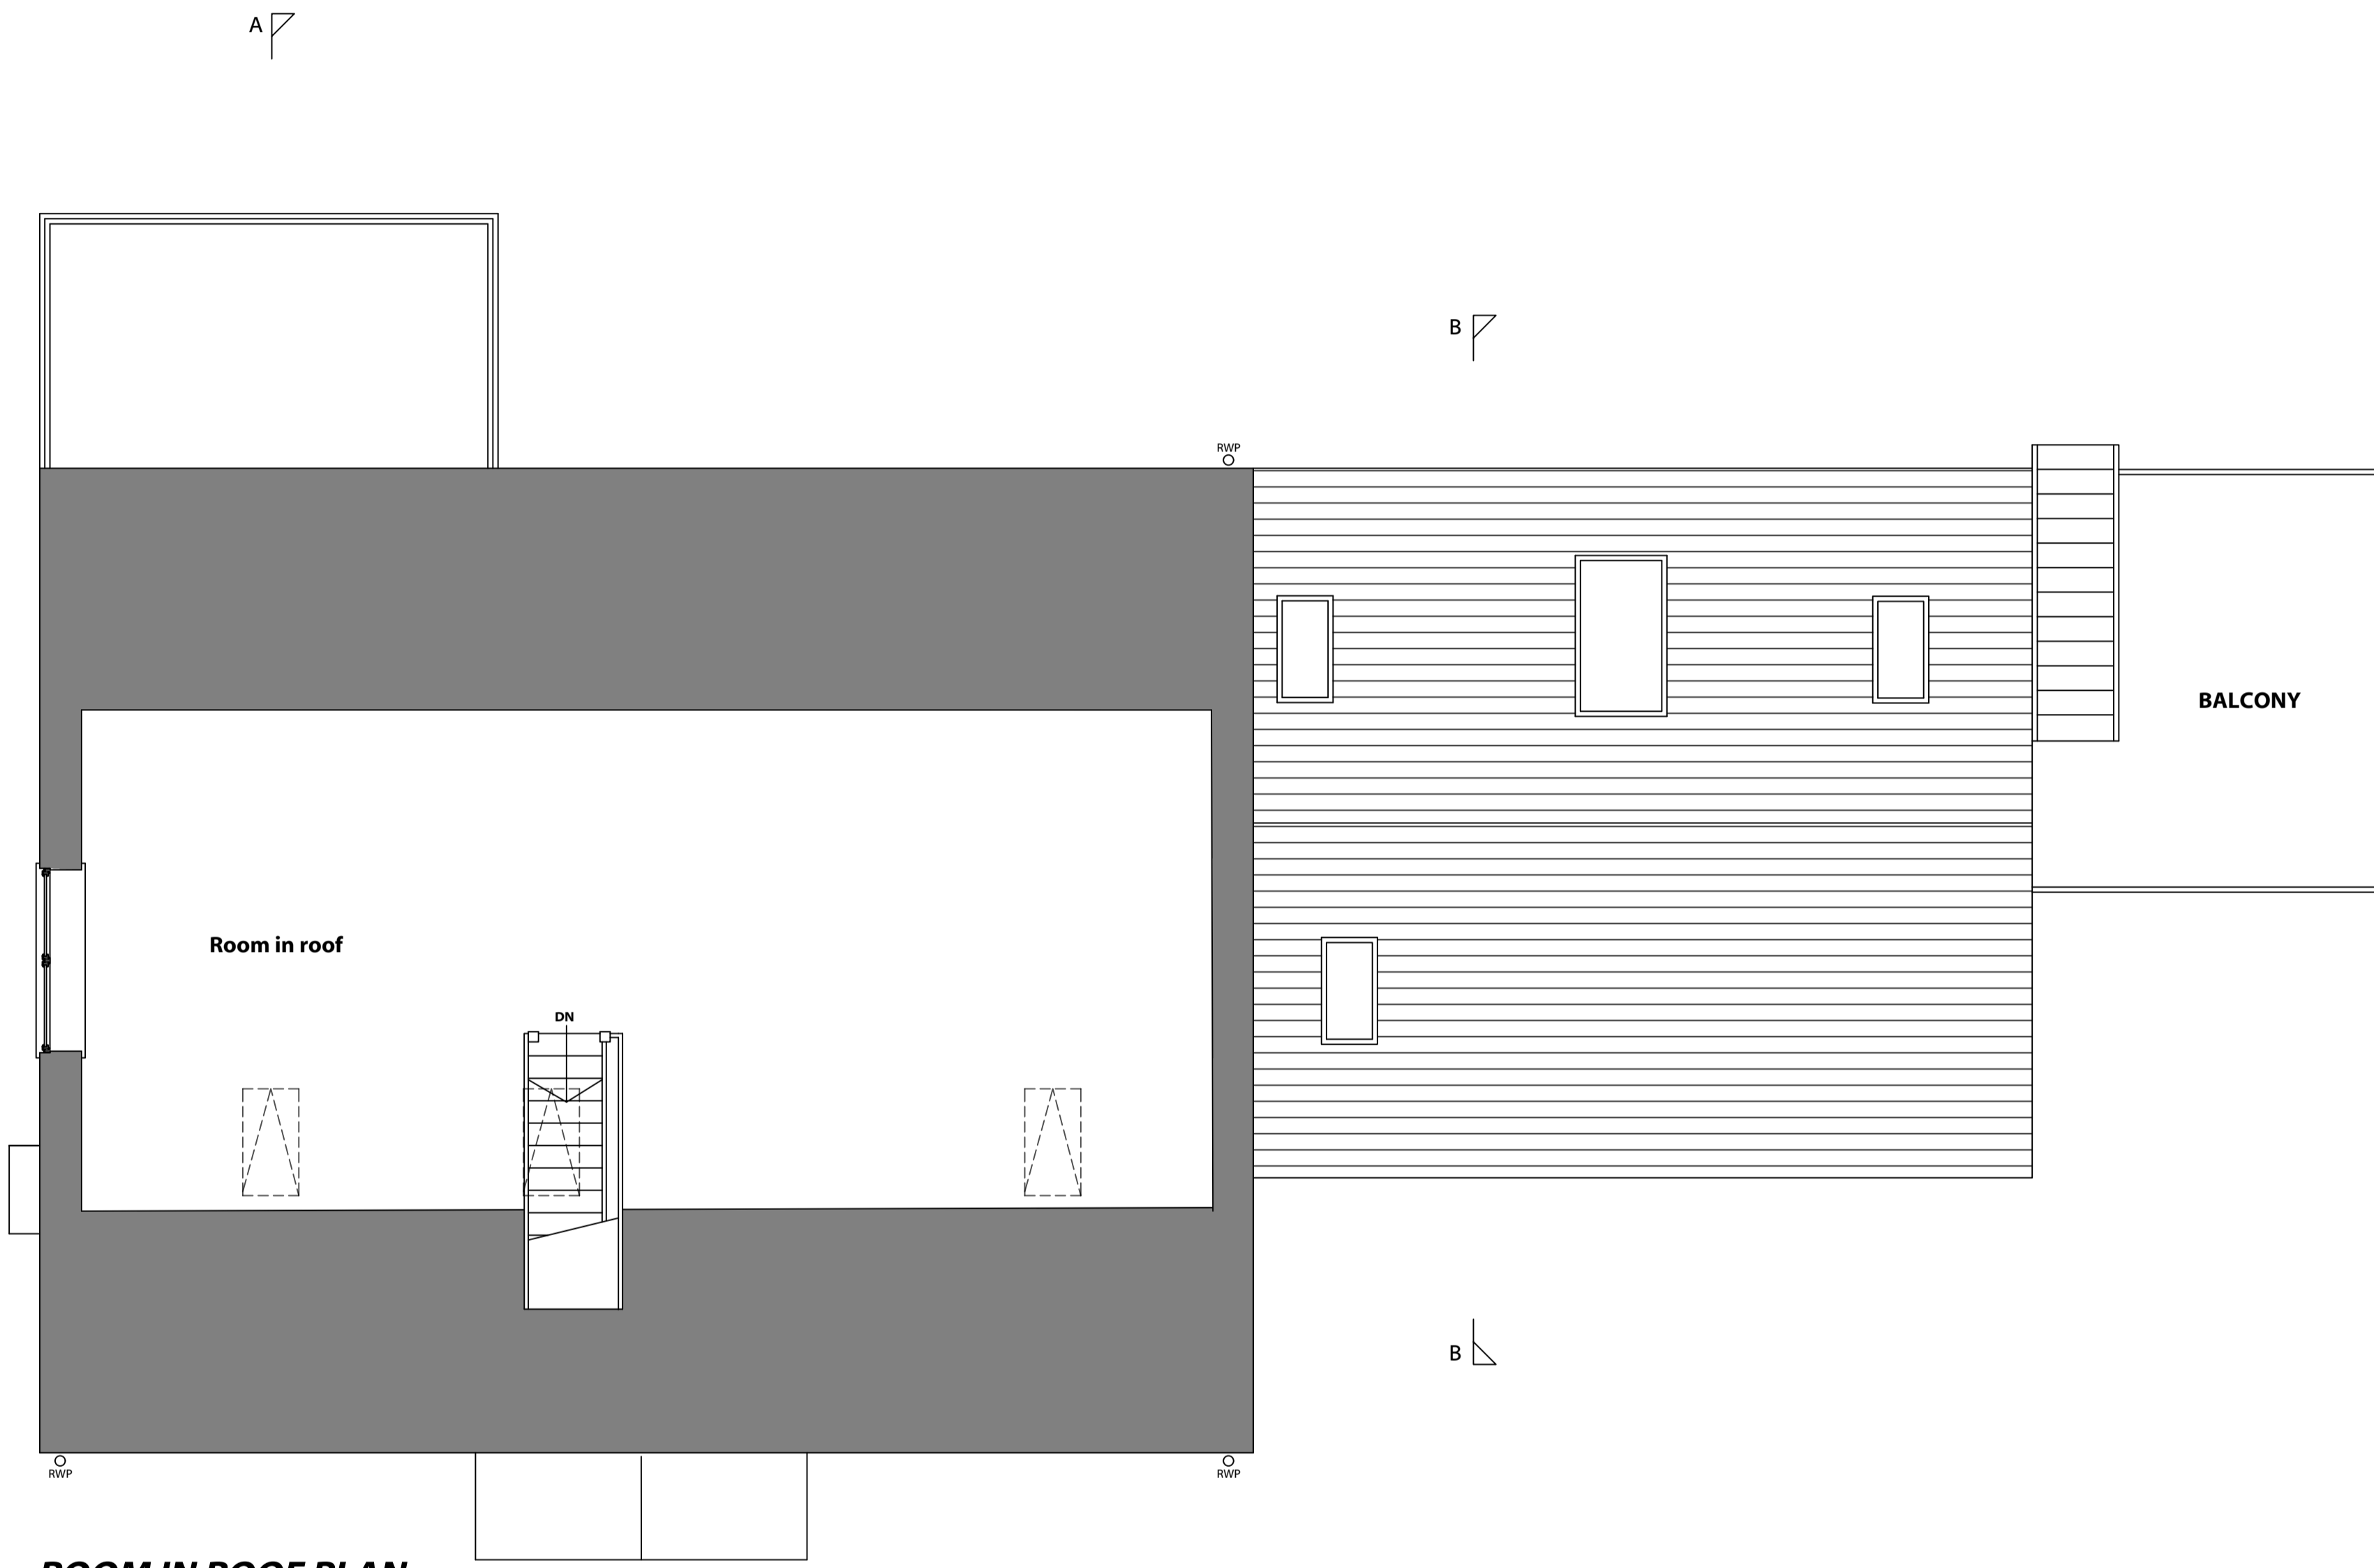

ROOM IN ROOF PLAN

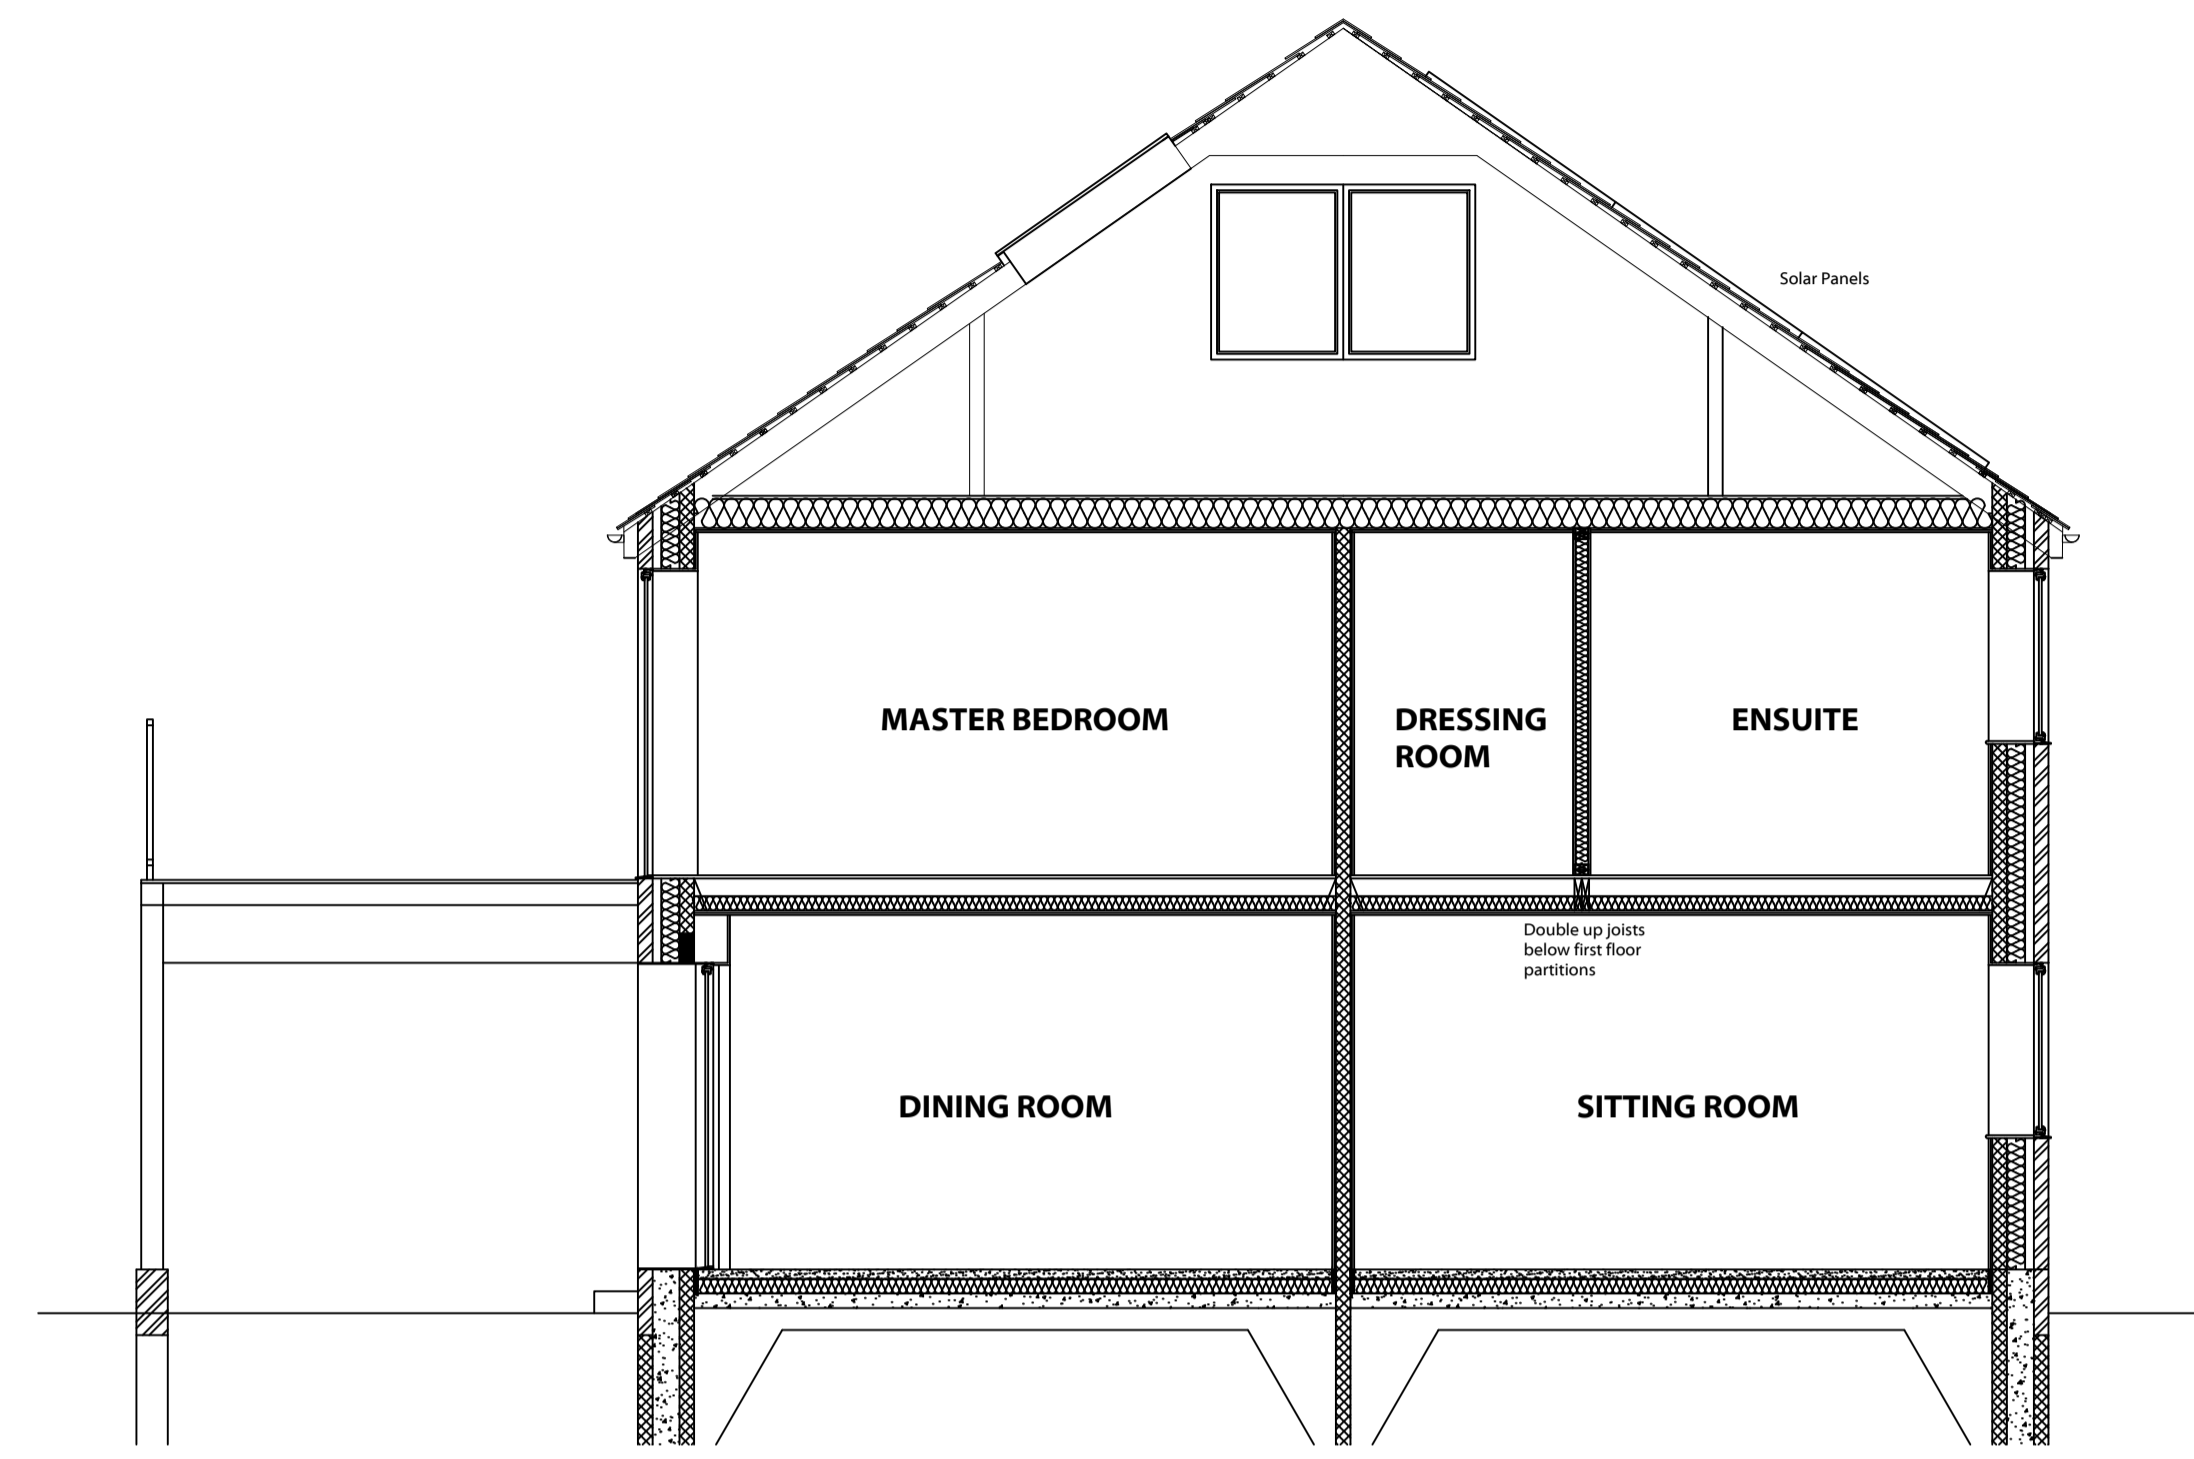

SECTION A-A

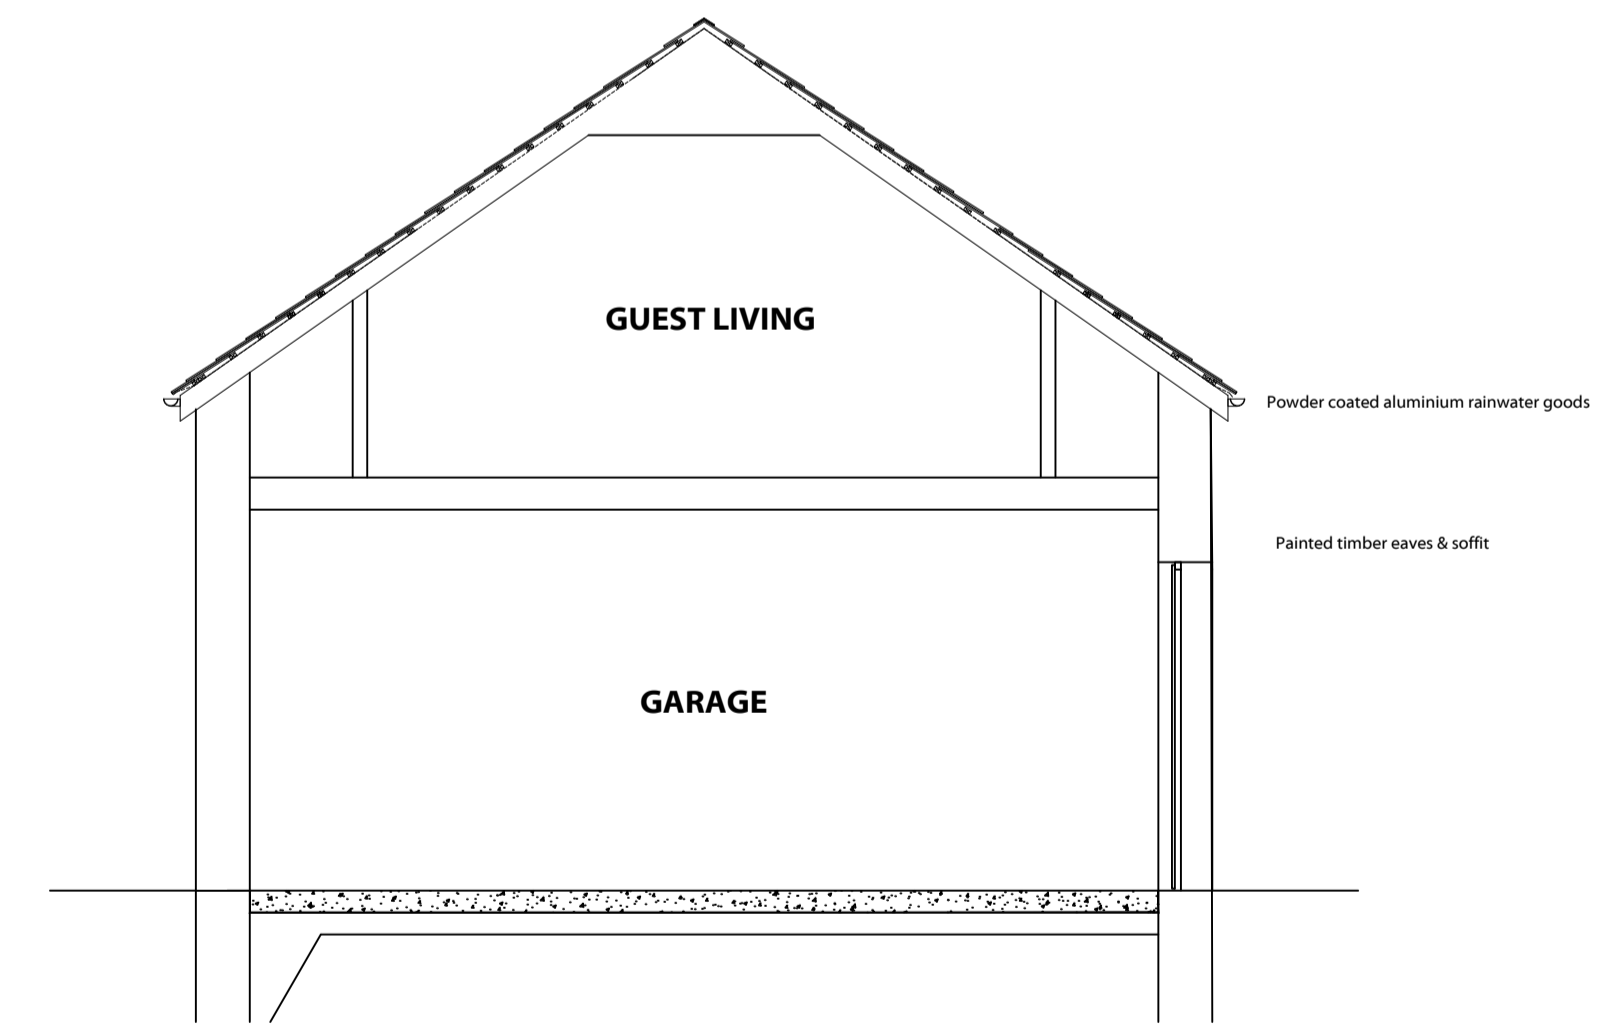

SECTION B-B

Project :- Dwelling at Glyn View, Gravels Bank, Minsterley		
Drawing Status :- Stage 6:As Built	Drawing Title :- Proposed Roof Plan & Sections	Rev :- B
Scale :- 1:100@A3	Date :- 26.01.24	Drawing No :- Z002.6.1.101
Drawn by :- GD	Checked :- RL	

Rev B - Porch - 23.02.24 - GD
Rev A - Solar Panels added - 29.01.24 - GD