

This drawing is COPYRIGHT. It must not be reproduced or disclosed to third parties without our prior permission. Do not scale from this drawing, or interrogate and use electronic information. Any discrepancies should be reported immediately. Any surveyed information incorporated within this drawing cannot be guaranteed as accurate unless confirmed by a fixed dimension. All dimensions are in millimetres unless noted otherwise.




FRONT ELEVATION



SIDE ELEVATION



REAR ELEVATION

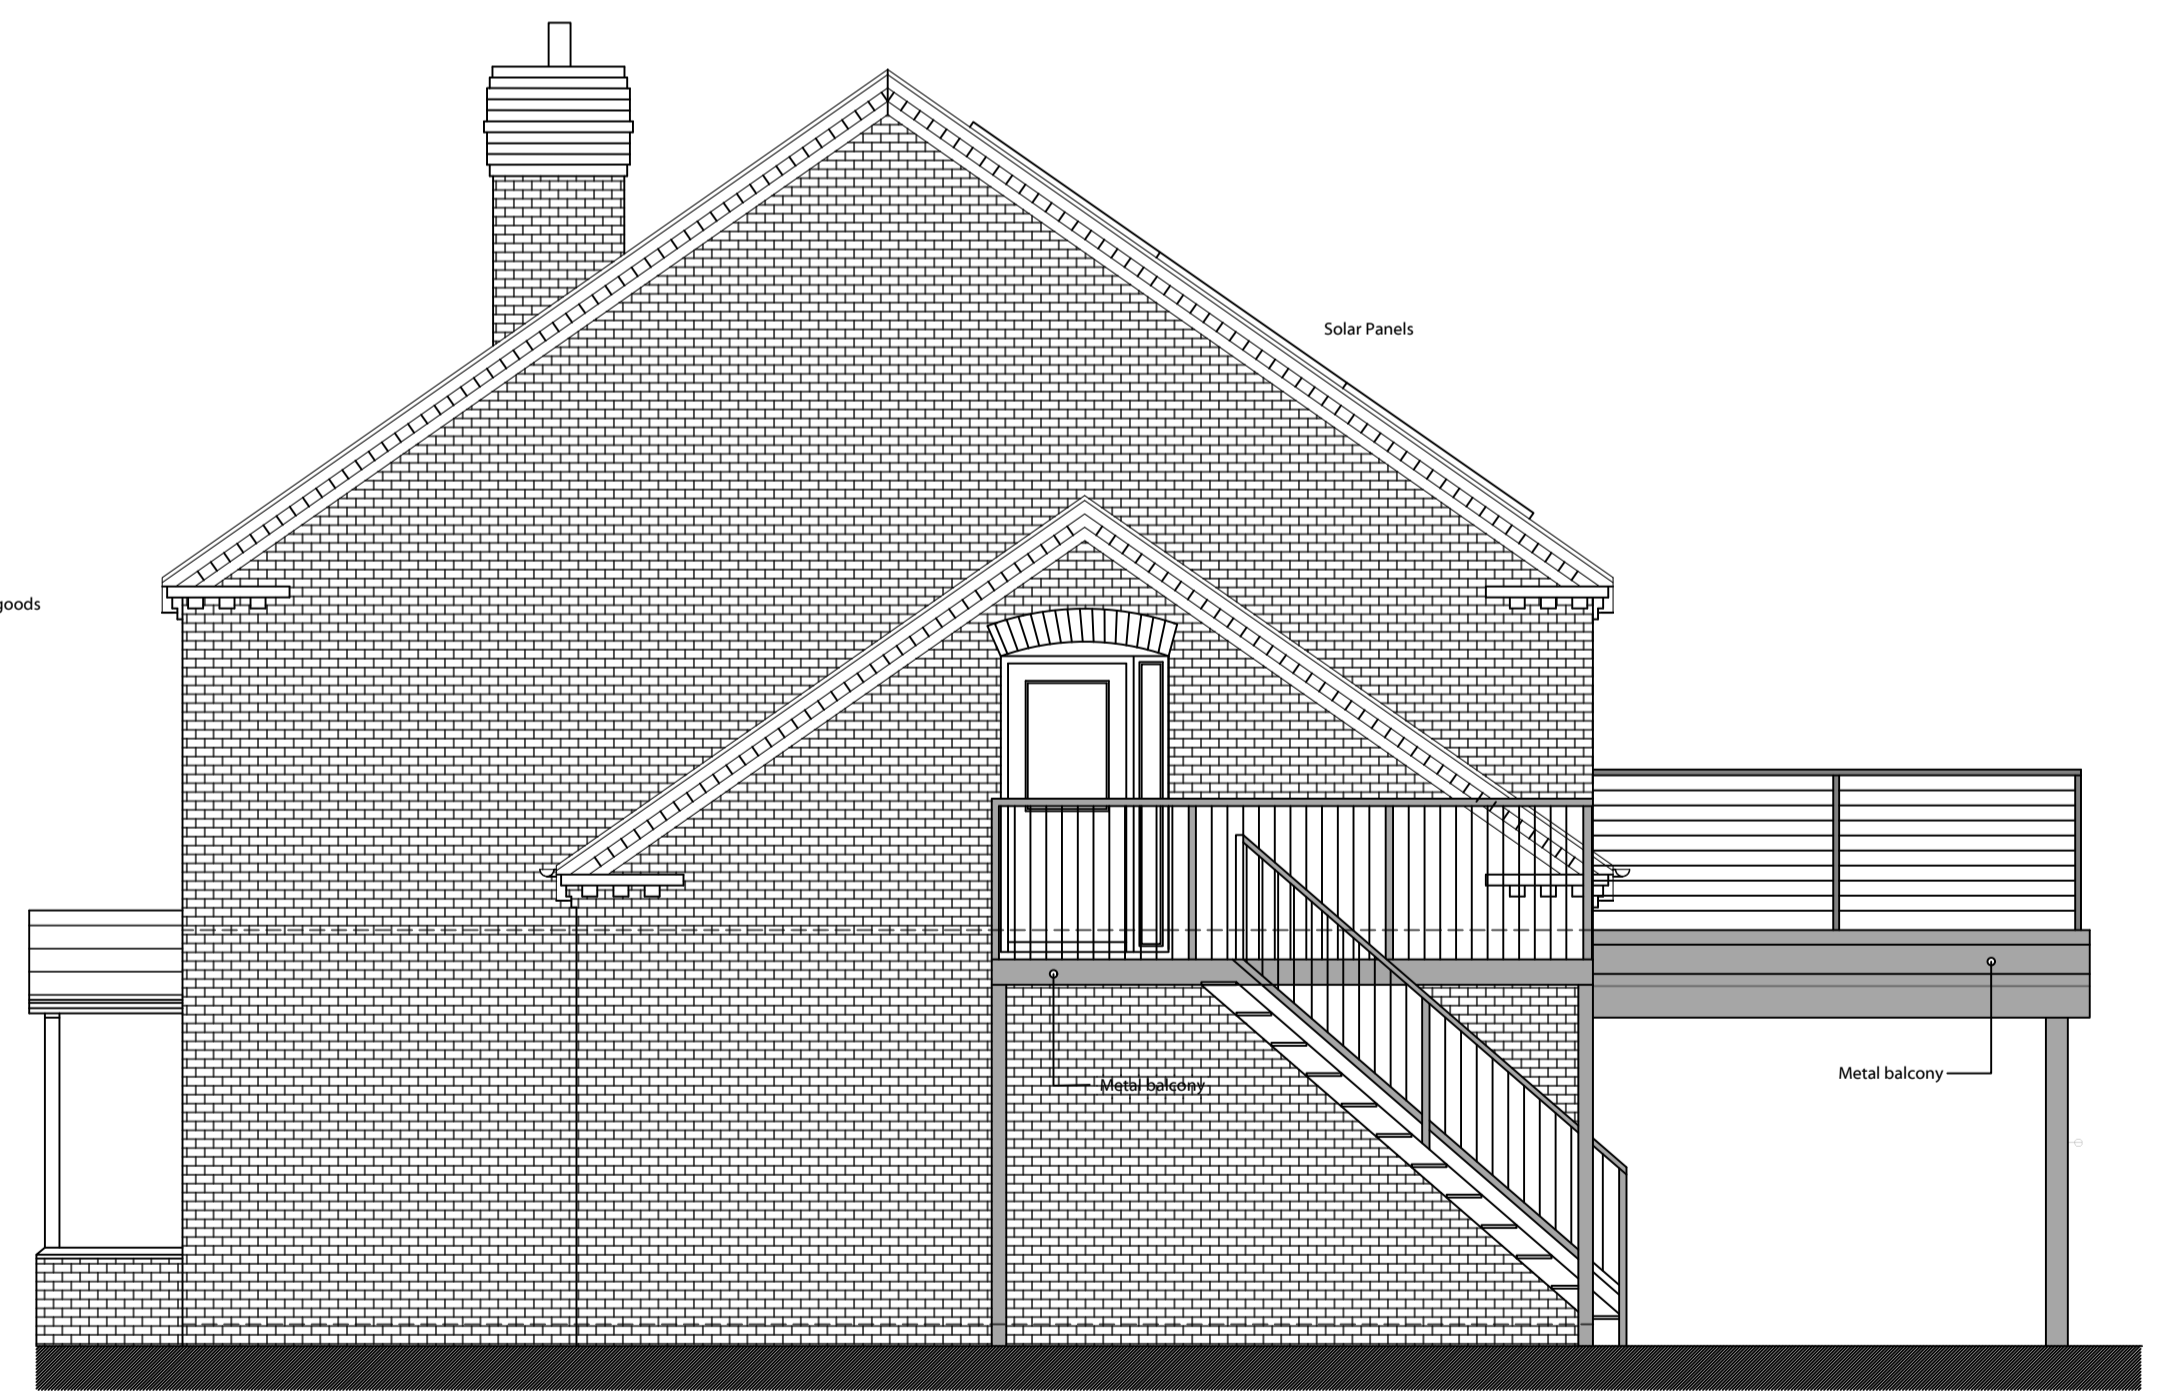

SIDE ELEVATION

Project :- Dwelling at Glyn View, Gravels Bank, Minsterley	
Drawing Status :- Stage 6: As Built	Drawing Title :- As Built Elevations
Scale :- 1:100@A3 Date :- 24.01.24	Drawing No :- Z002.6.1.102
Drawn by :- GD Checked :- RL	Rev :- A