



REAR ELEVATION



FRONT ELEVATION

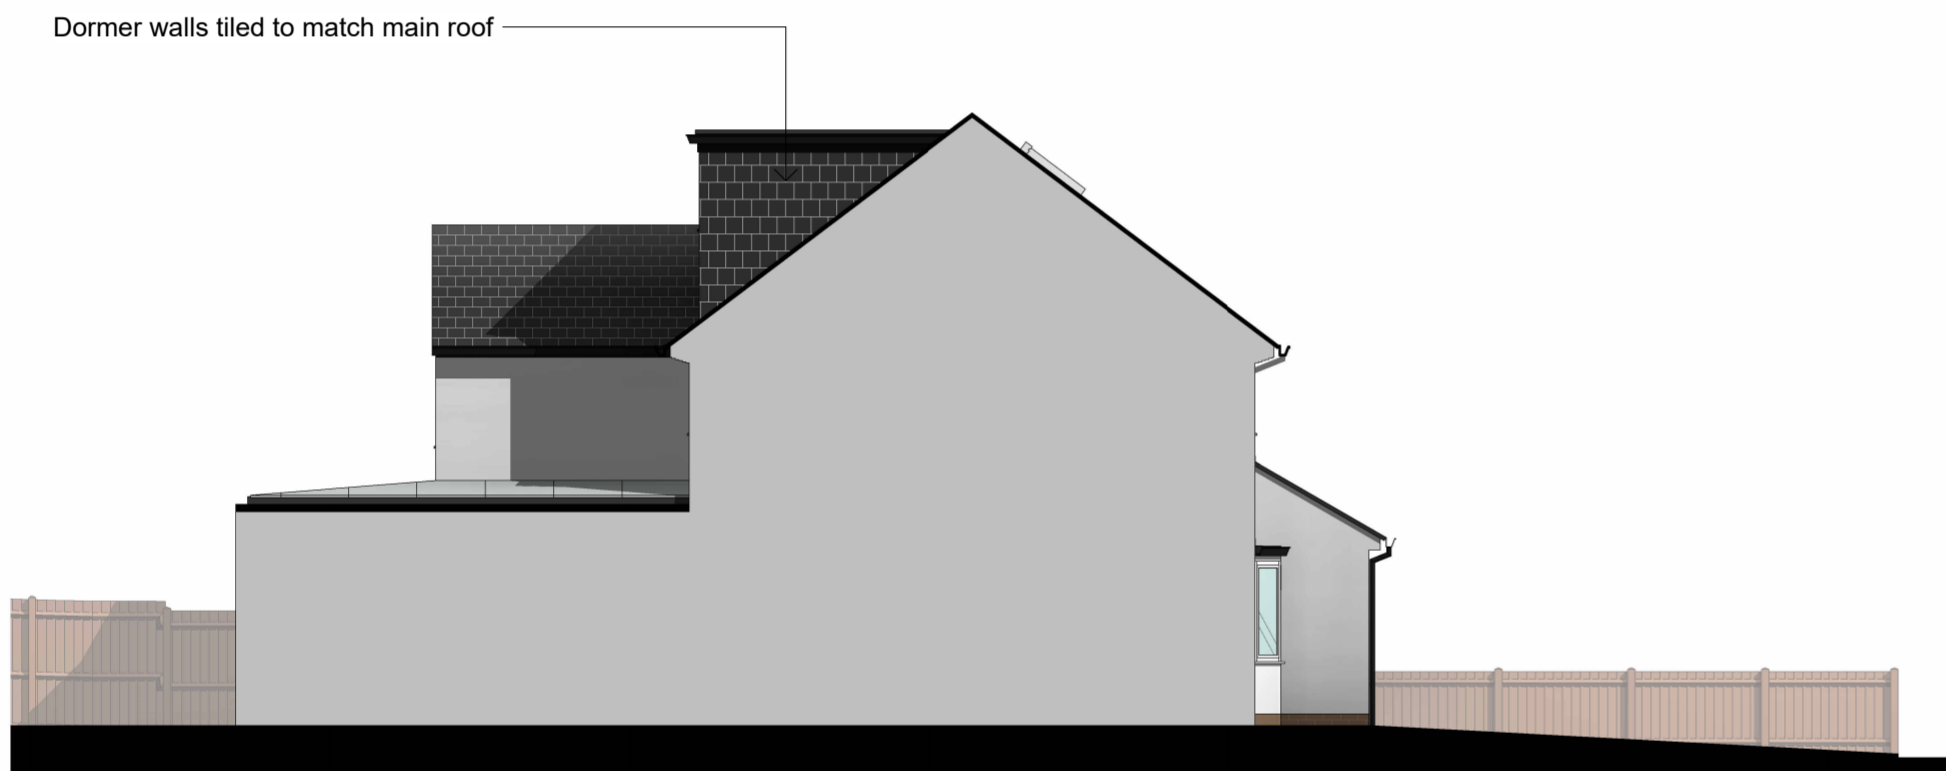


LEFT ELEVATION

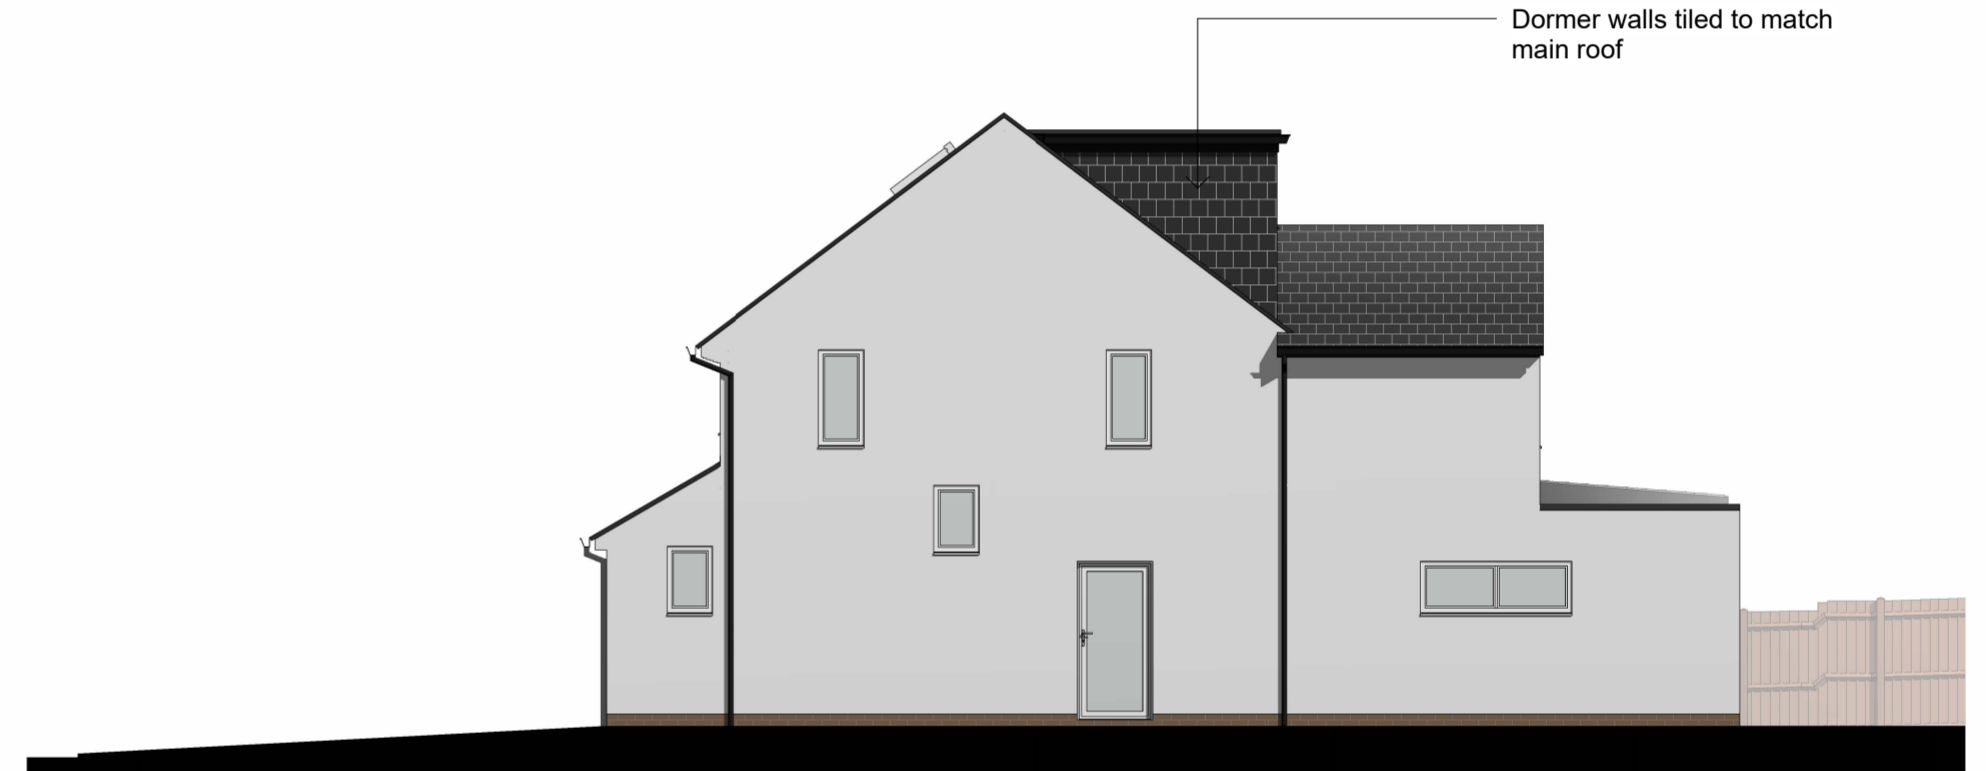

RIGHT ELEVATION



SECTION A

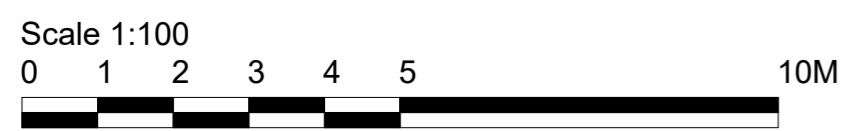

I am registered and regulated by ARB: http://architects-register.org.uk/architect/079560G		RUI COSTA, BA Arch ✉ architect.costa@gmail.com ☎ 07926133184	
PROJECT	LOFT CONVERSION, REAR DORMER, FRONT ROOFLIGHTS, AND SINGLE STOREY OUTBUILDING	DATE	25/02/2024
PROJECT ADDRESS	36 WILLOW WAY, RADLETT WD7 8DY	PROJECT NUMBER	SCALE (@ A2)
		12/2023	1 : 100
TITLE	AS BUILT SECTIONS AND ELEVATIONS	DRAWING NUMBER	REV
		06	