


5  
06


5  
06

5  
06


5  
06

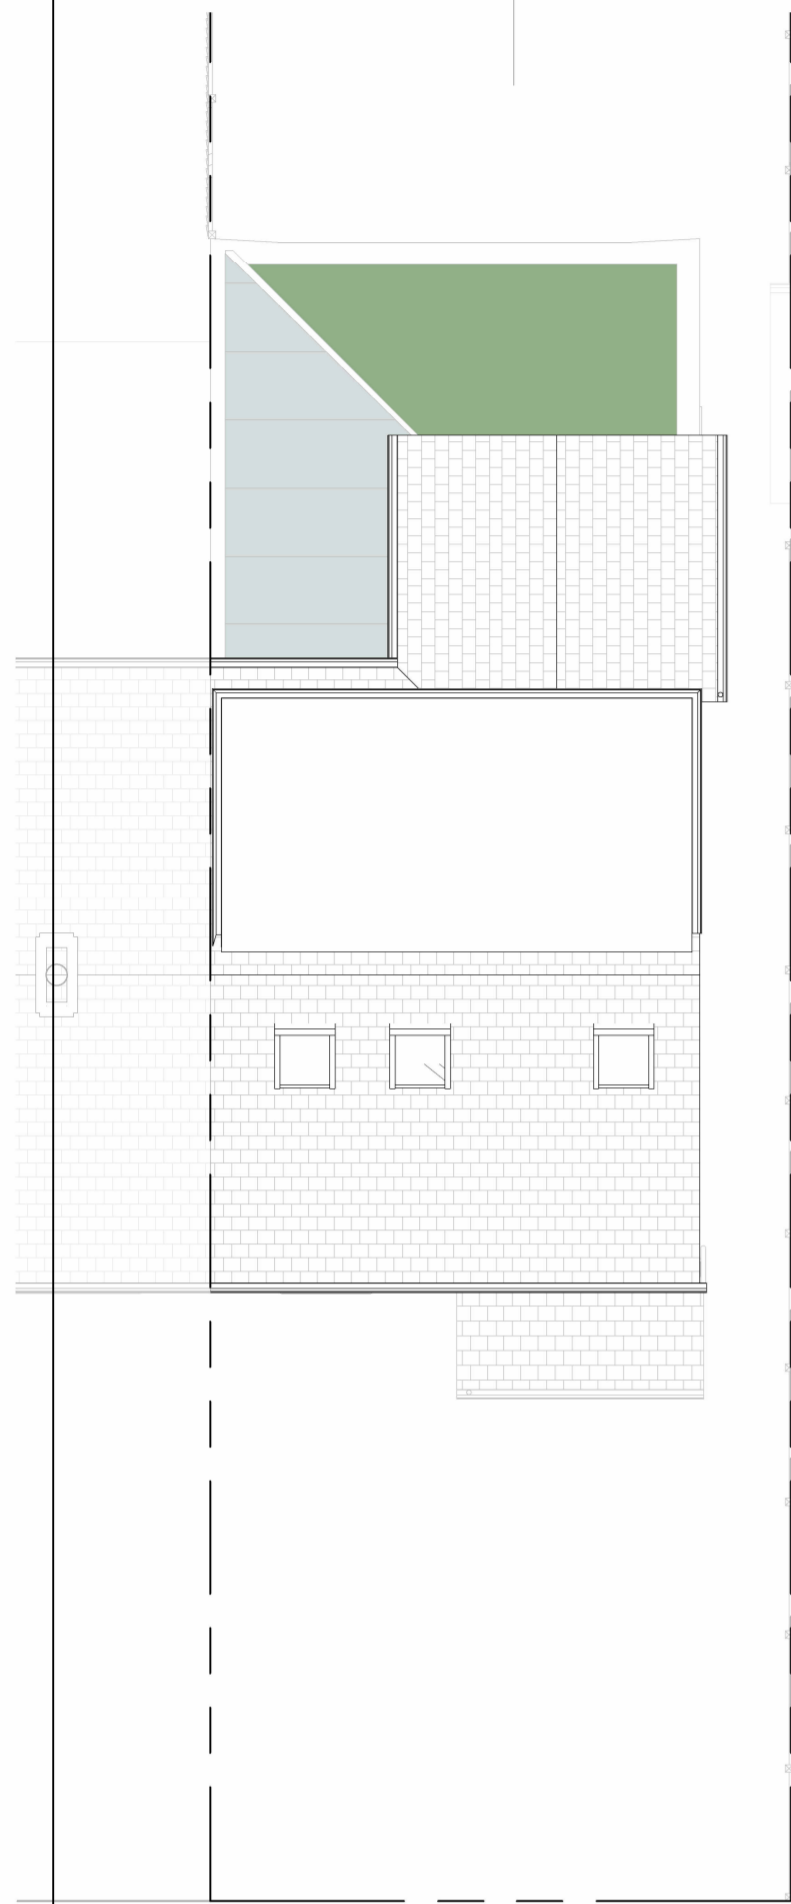

ROOF PLAN

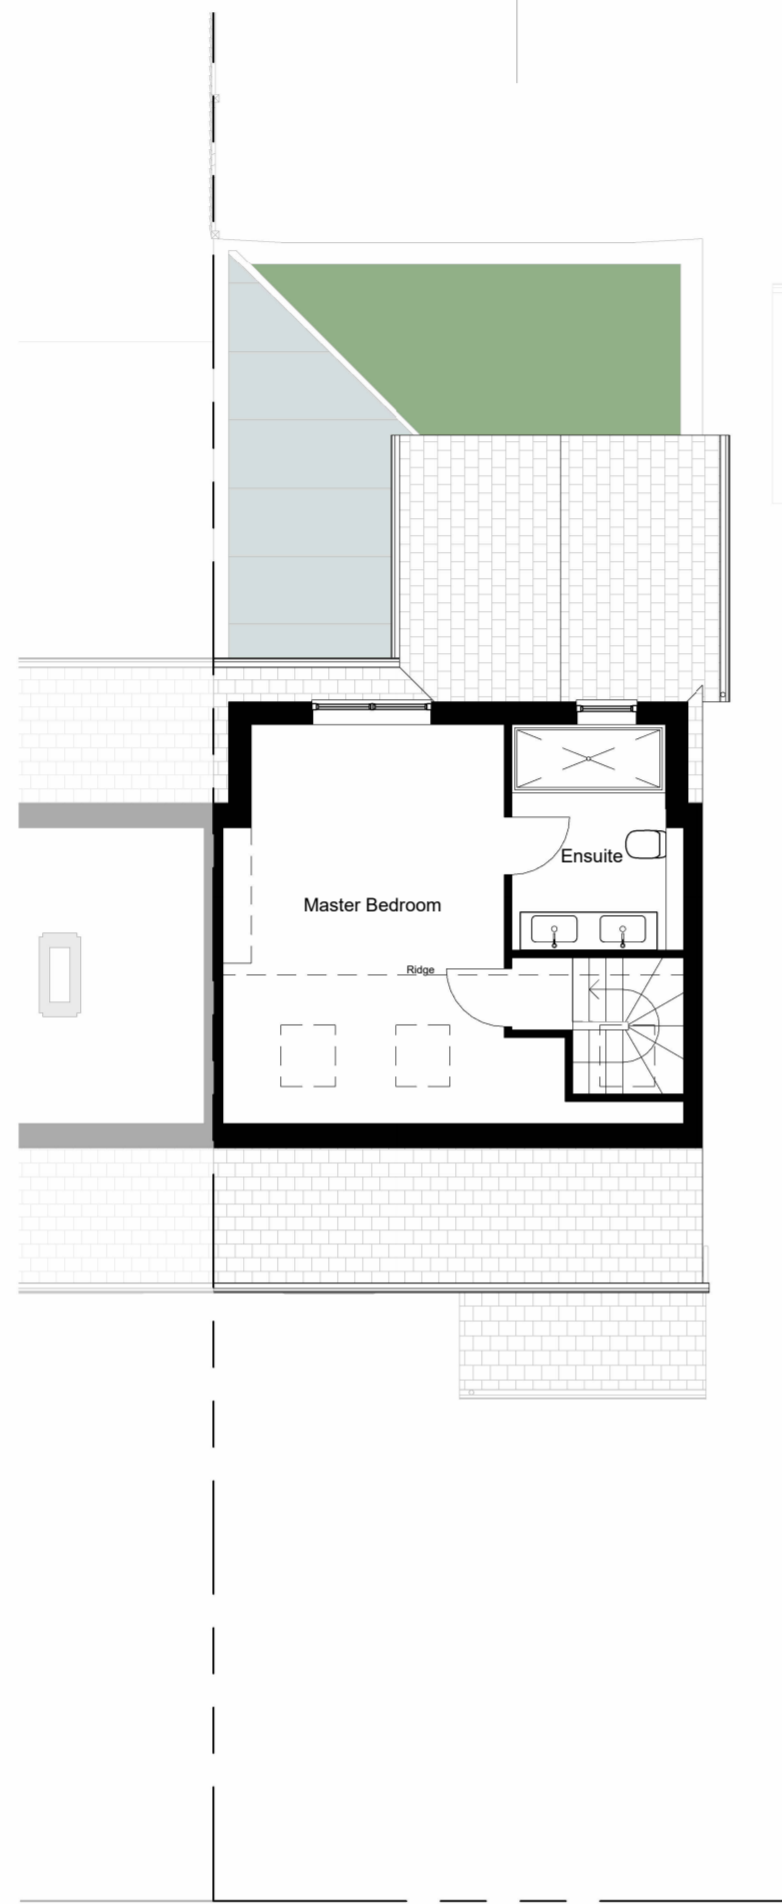


LOFT PLAN

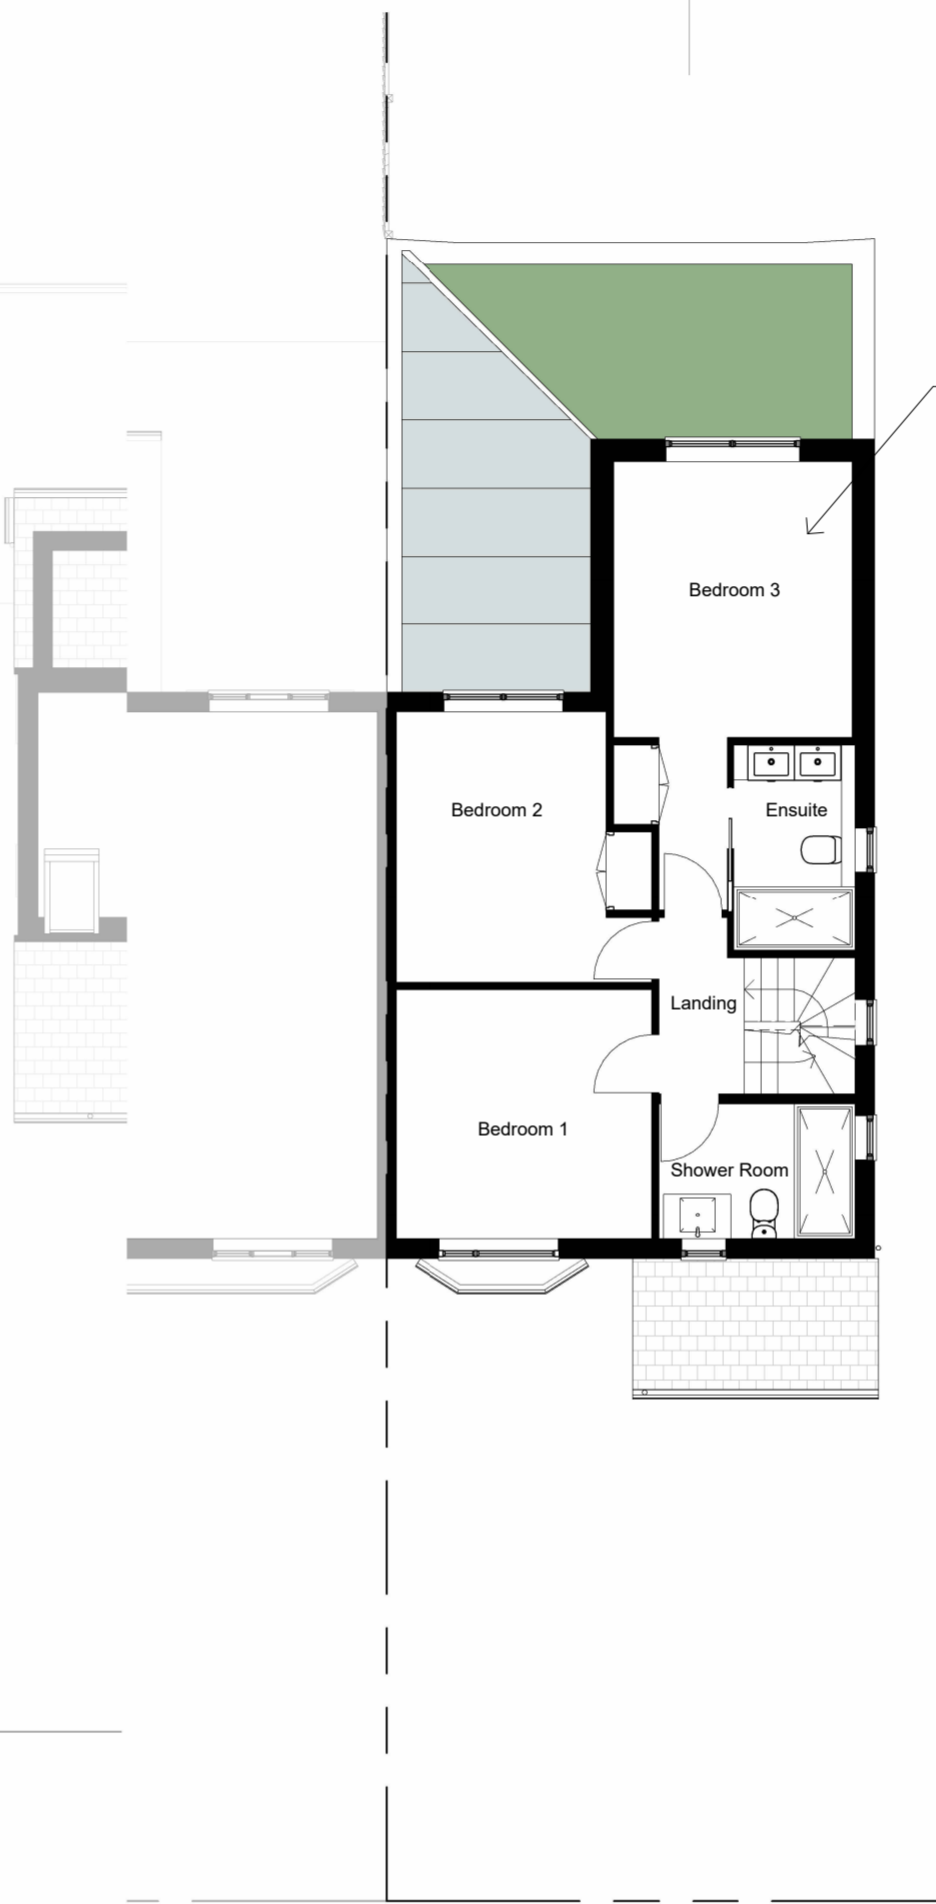

FIRST FLOOR PLAN

Existing rear extension (23/0588/PD42)

Existing first floor rear extension (23/1188/HSE)

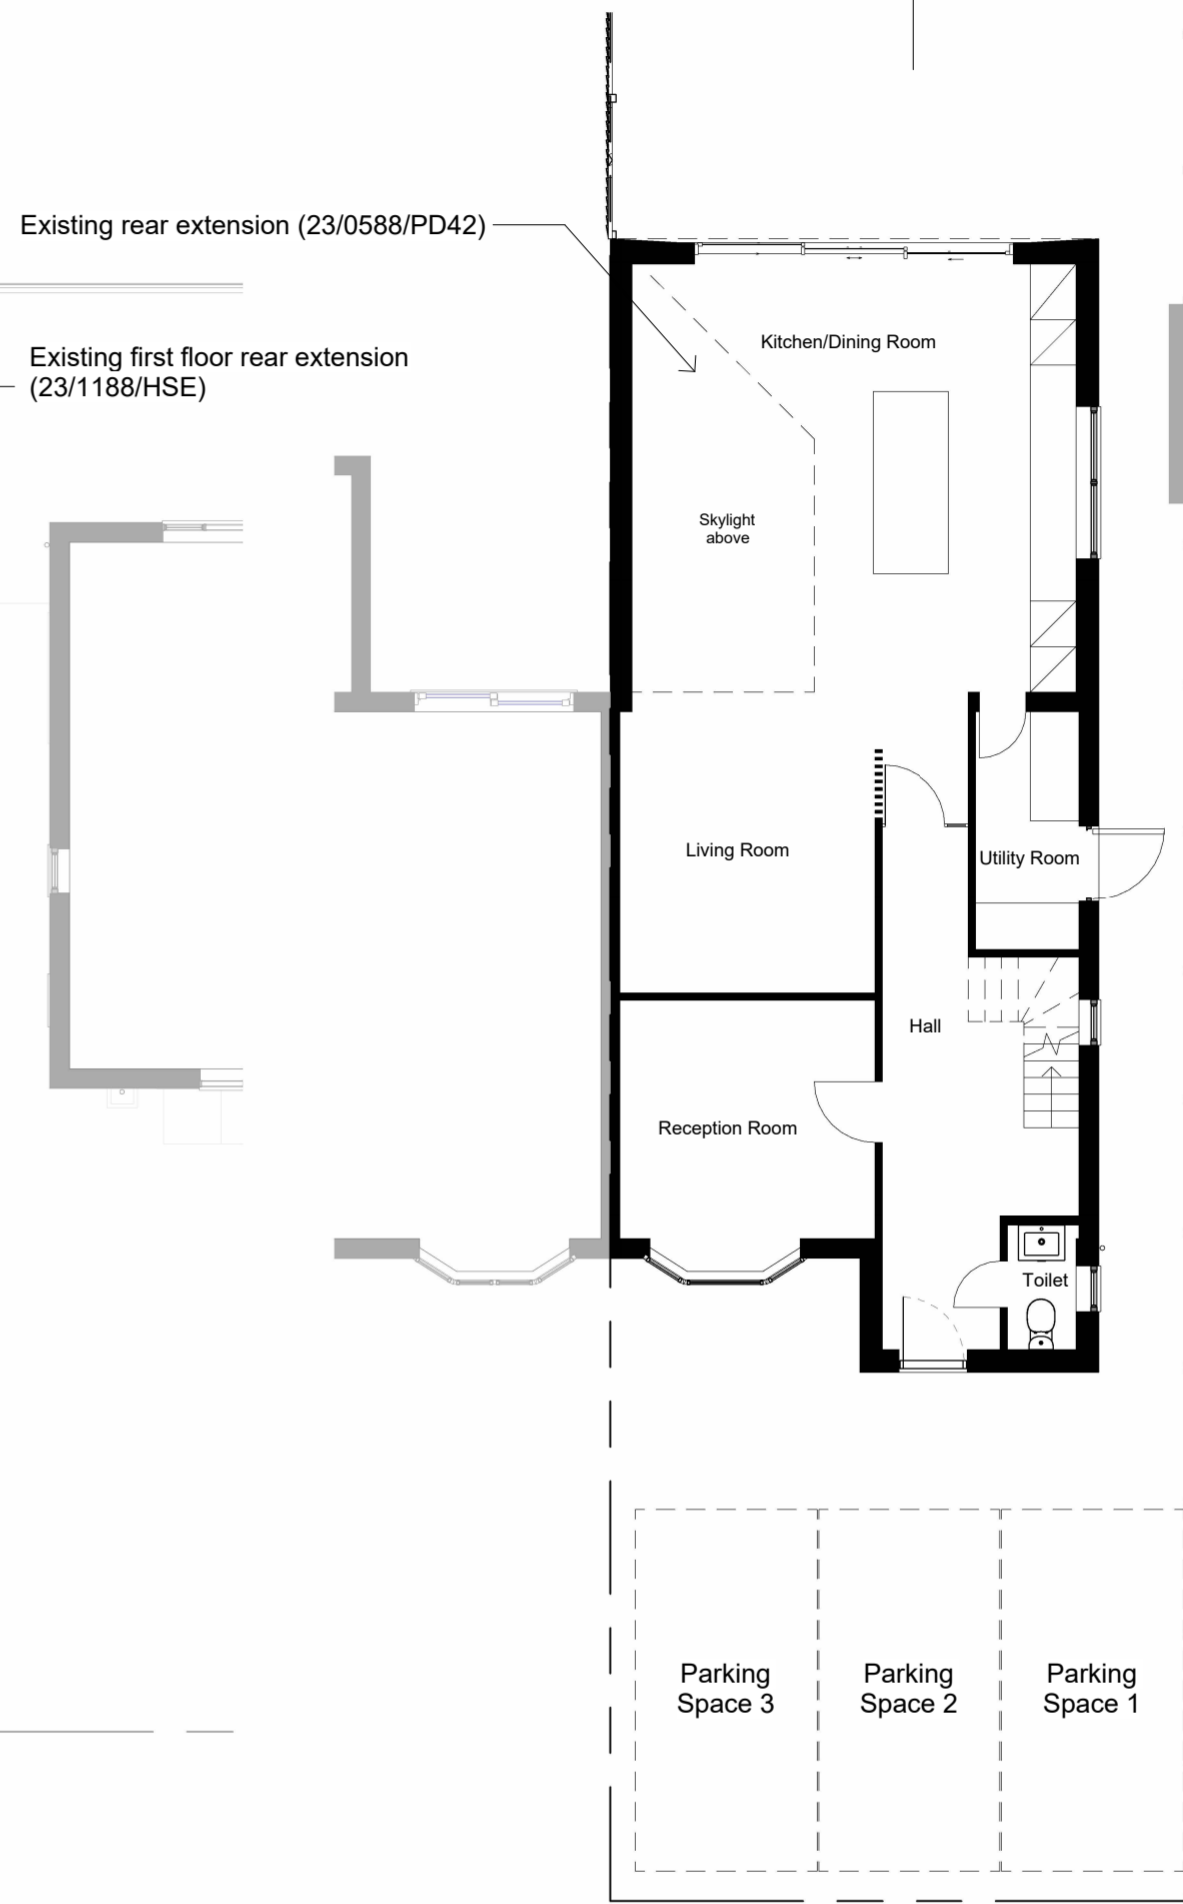


GROUND FLOOR PLAN

38

36  
WILLOW WAY

34

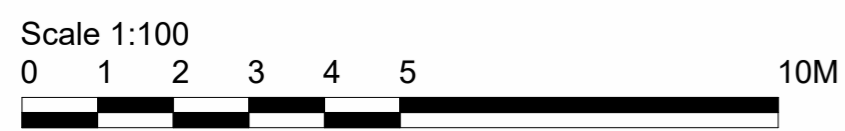

I am registered and regulated by ARB: <http://architects-register.org.uk/architect/079560G>

RUI COSTA, BA Arch  
 architect.costa@gmail.com  
 07926133184



PROJECT	LOFT CONVERSION, REAR DORMER, FRONT ROOFLIGHTS, AND SINGLE STOREY OUTBUILDING	DATE	25/02/2024
PROJECT ADDRESS	36 WILLOW WAY, RADLETT WD7 8DY	PROJECT NUMBER	12/2023
TITLE	AS BUILT FLOOR PLANS	DRAWING NUMBER	05
		SCALE (@ A2)	1 : 100
		REV	